384 V-3

PG 374 BELOIT REC

12/16/75 DAB

PLAT AND RECORD

Lot 3, 22 & 23 Swift's Add. to Edgerton

S.W.¼

Of a Survey on Section 3 T R E. of the 4 P. M. in Fulton Township

Rock County, Wisconsin, made October the 1 1938.

I hereby certify that the following is a correct record of said survey as made by me.

MICROFILMED
COUNTY BUILDING
CITY OF JANESVILLE
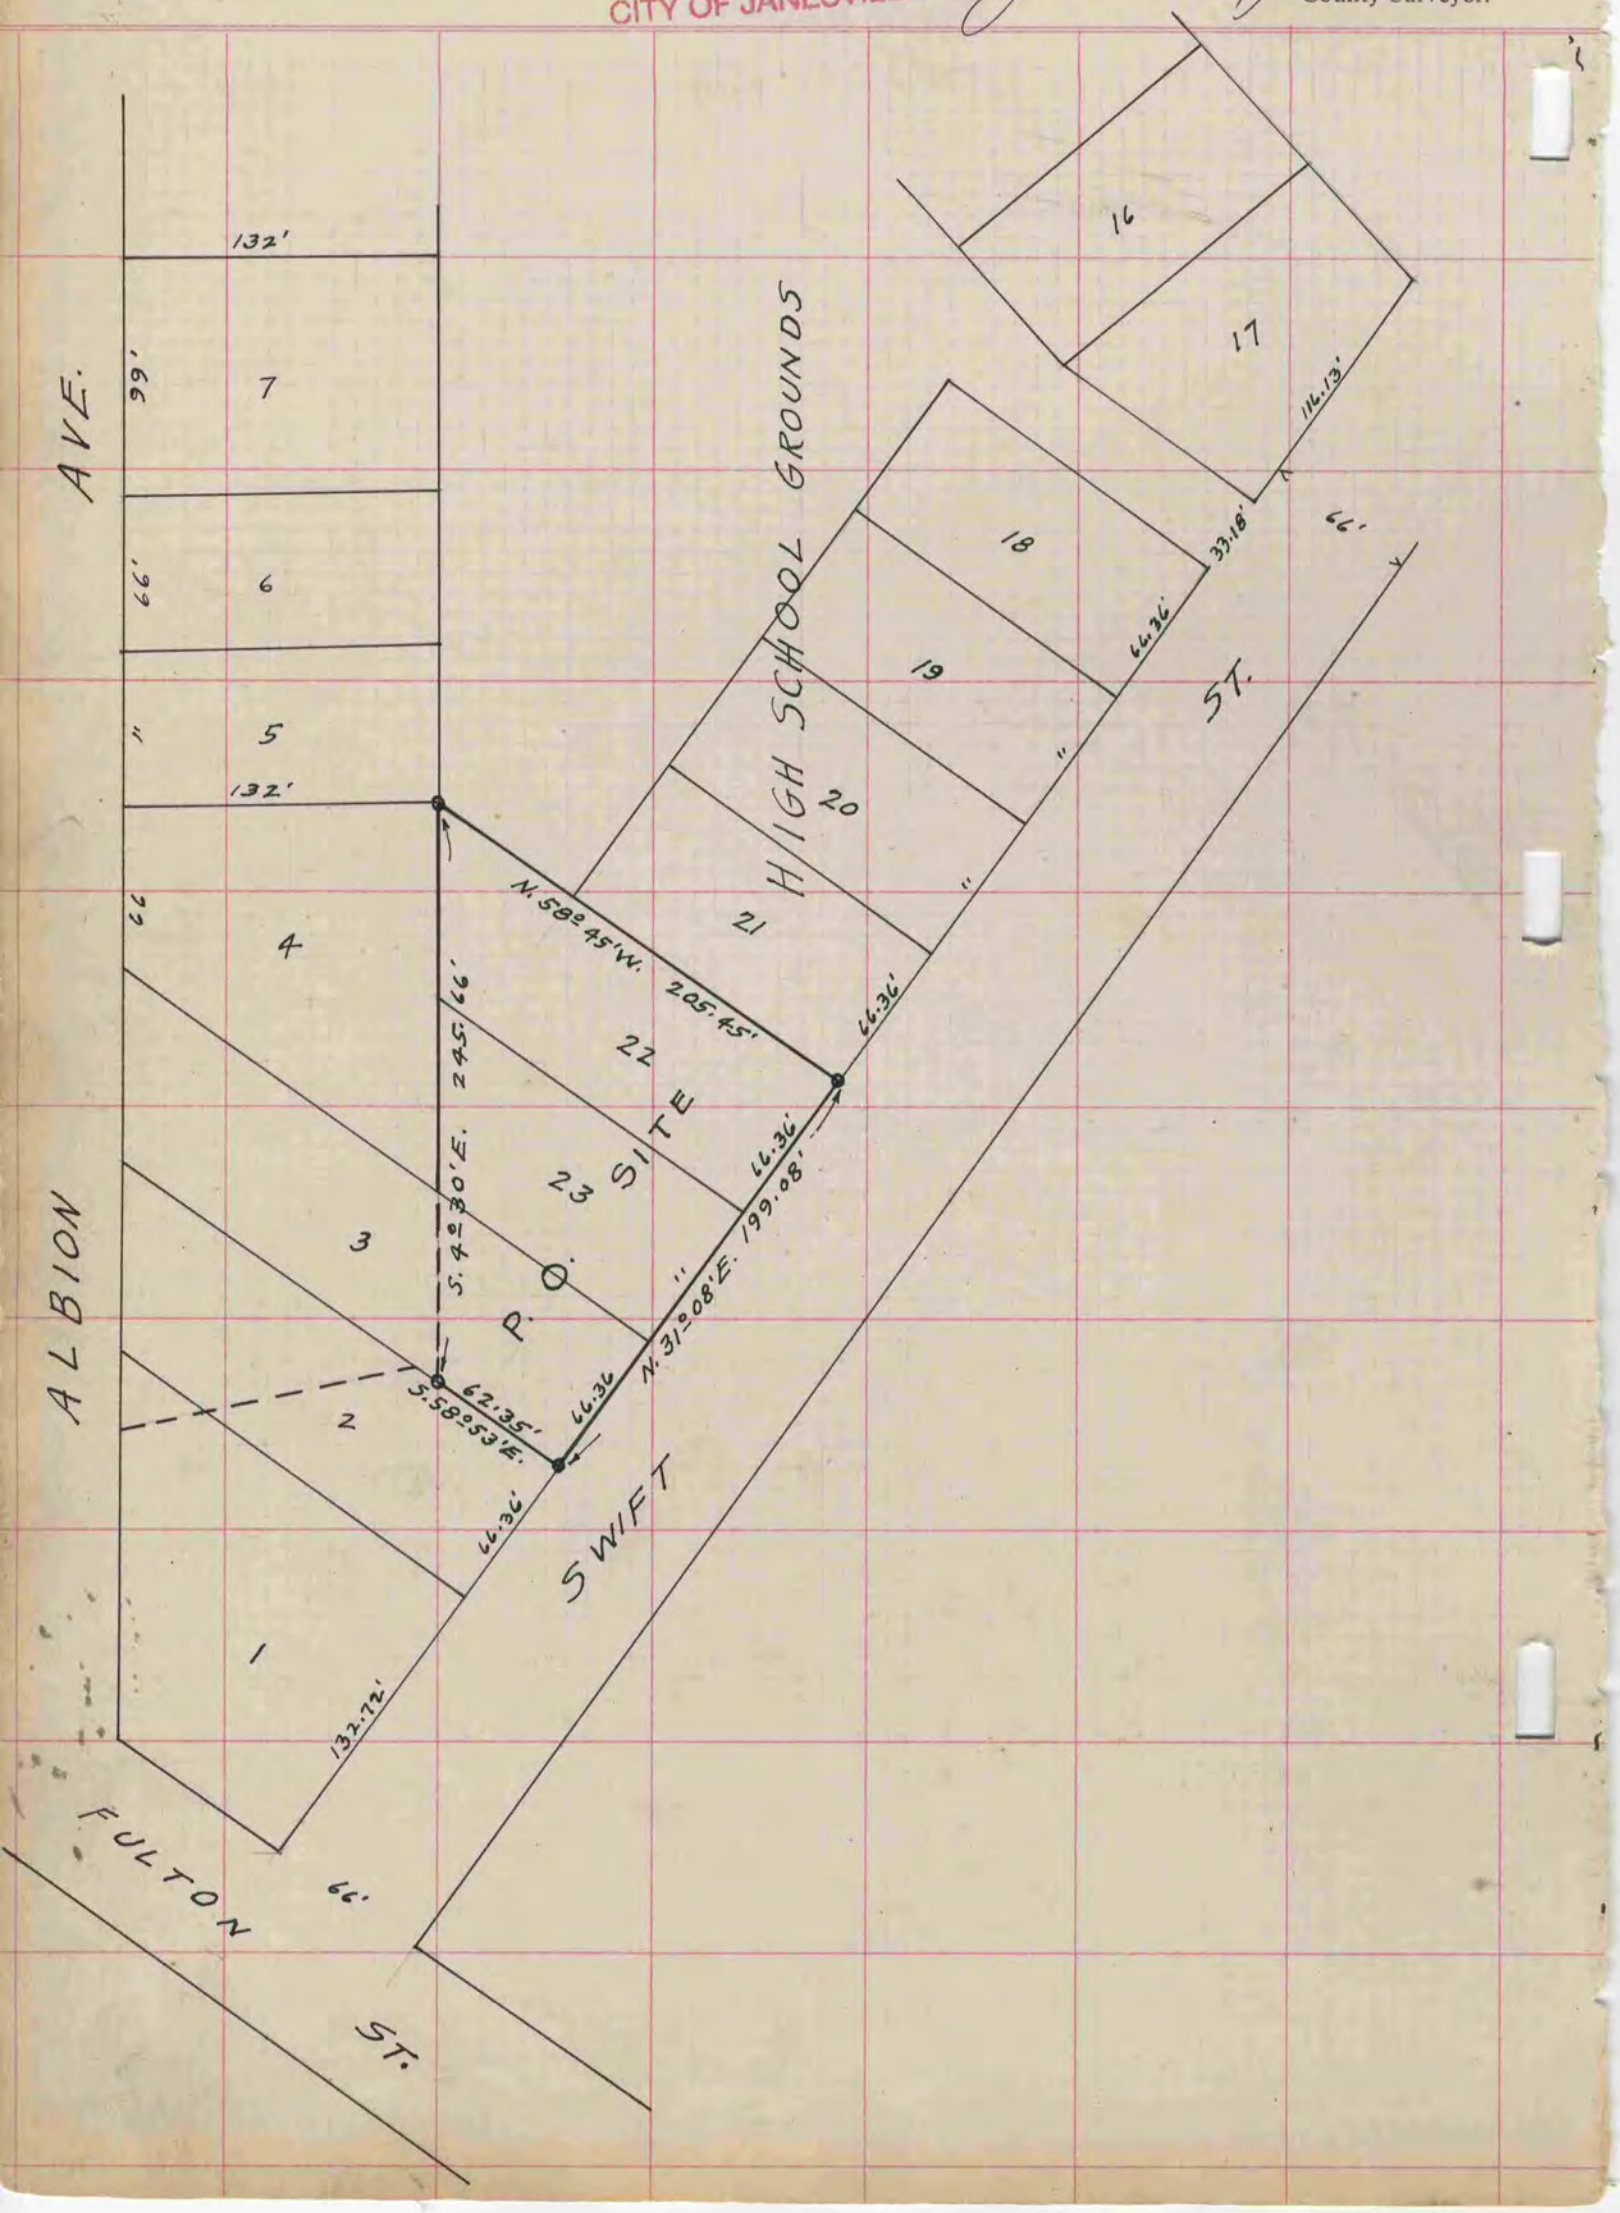
B. J. Bunny
County Surveyor.