316 V-3

PG 308 BELOIT REC

12/15/75 DAB

PLAT AND RECORD

Of a Survey on N.E.¼ Section 28 T 4N. R 13 E. of the 4 P. M. in Milton Township

Rock County, Wisconsin, made Sept. 18-22 & Oct. 1, 1936

I hereby certify that the following is a correct record of said survey as made by me.

MICROFILMED
COUNTY BUILDING
CITY OF JANESVILLE
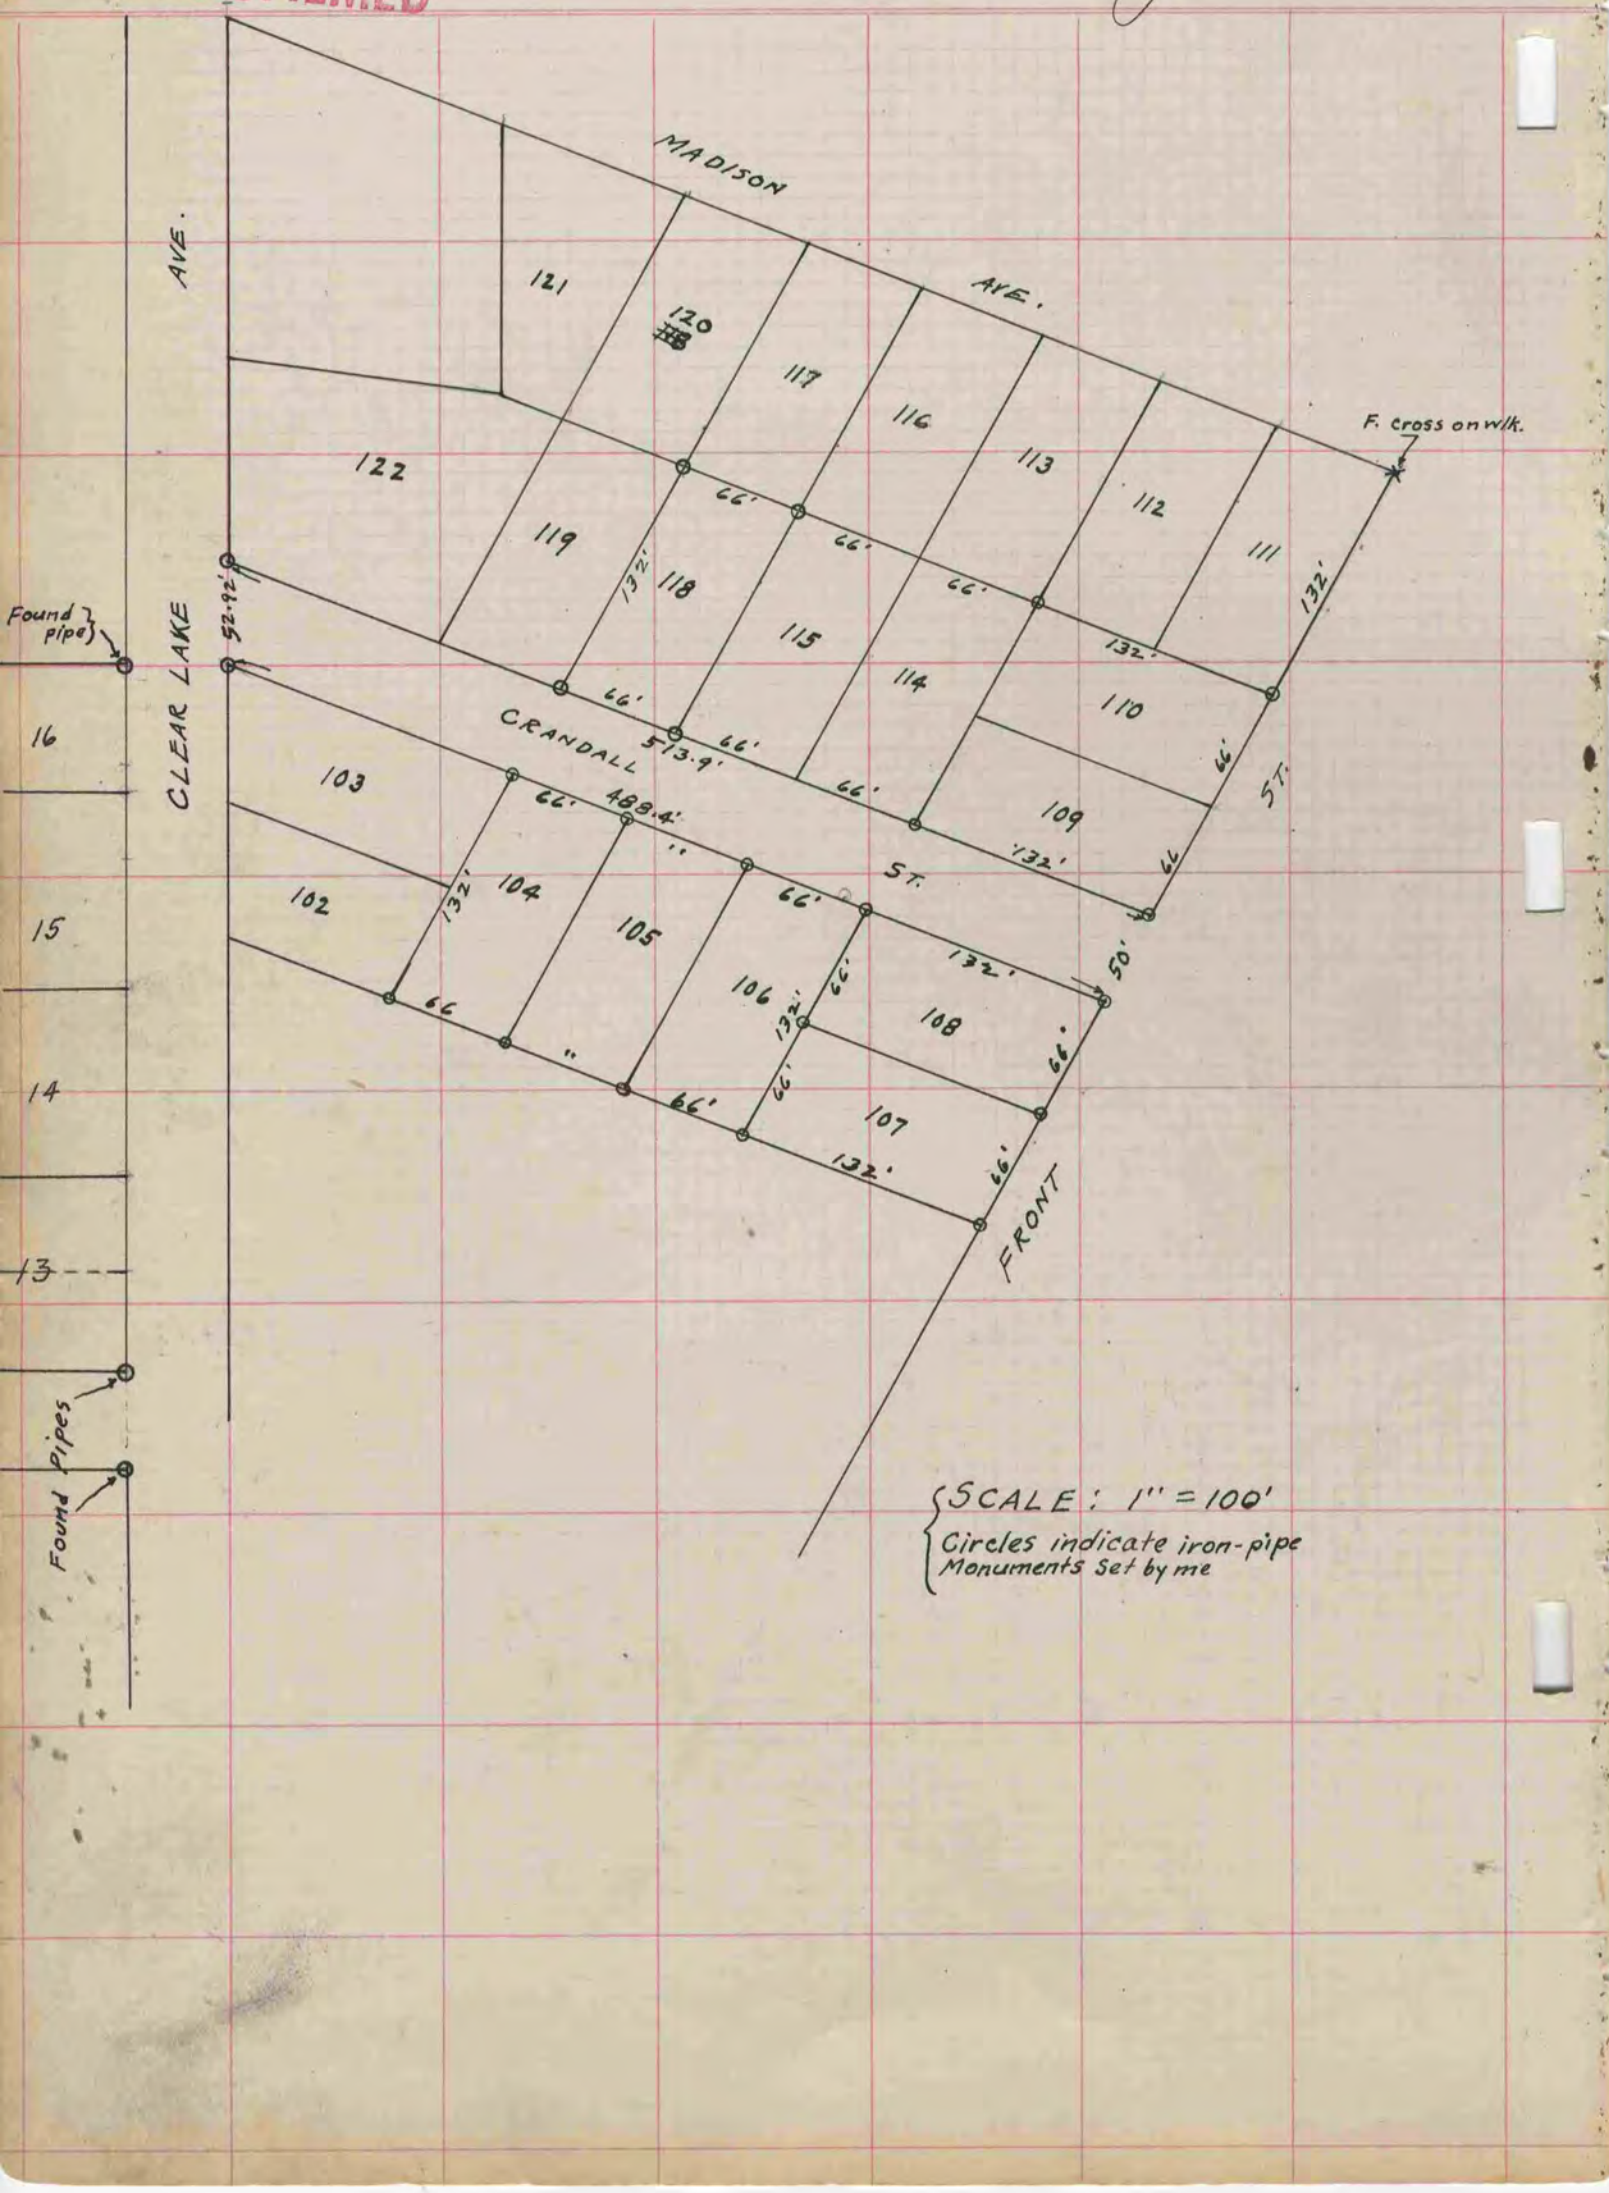
B. J. Bunney
County Surveyor.