PLAT AND RECORD

337
VOL. 6

Of a Survey on Section 27 T R E. of the 4 P.M. in UNION Township

Rock County, Wisconsin, made APRIL the 1985

I hereby certify that the following is a correct record of said survey as made by me.

COUNTY BUILDING
CITY OF JANESVILLE

WISCONSIN
DONALD A. BARNES
S-1215
JANESVILLE
WI.
LAND SURVEYOR

Donald Barnes
County Surveyor.

THE GEO. F. BARNARD COMPANY, ST. LOUIS

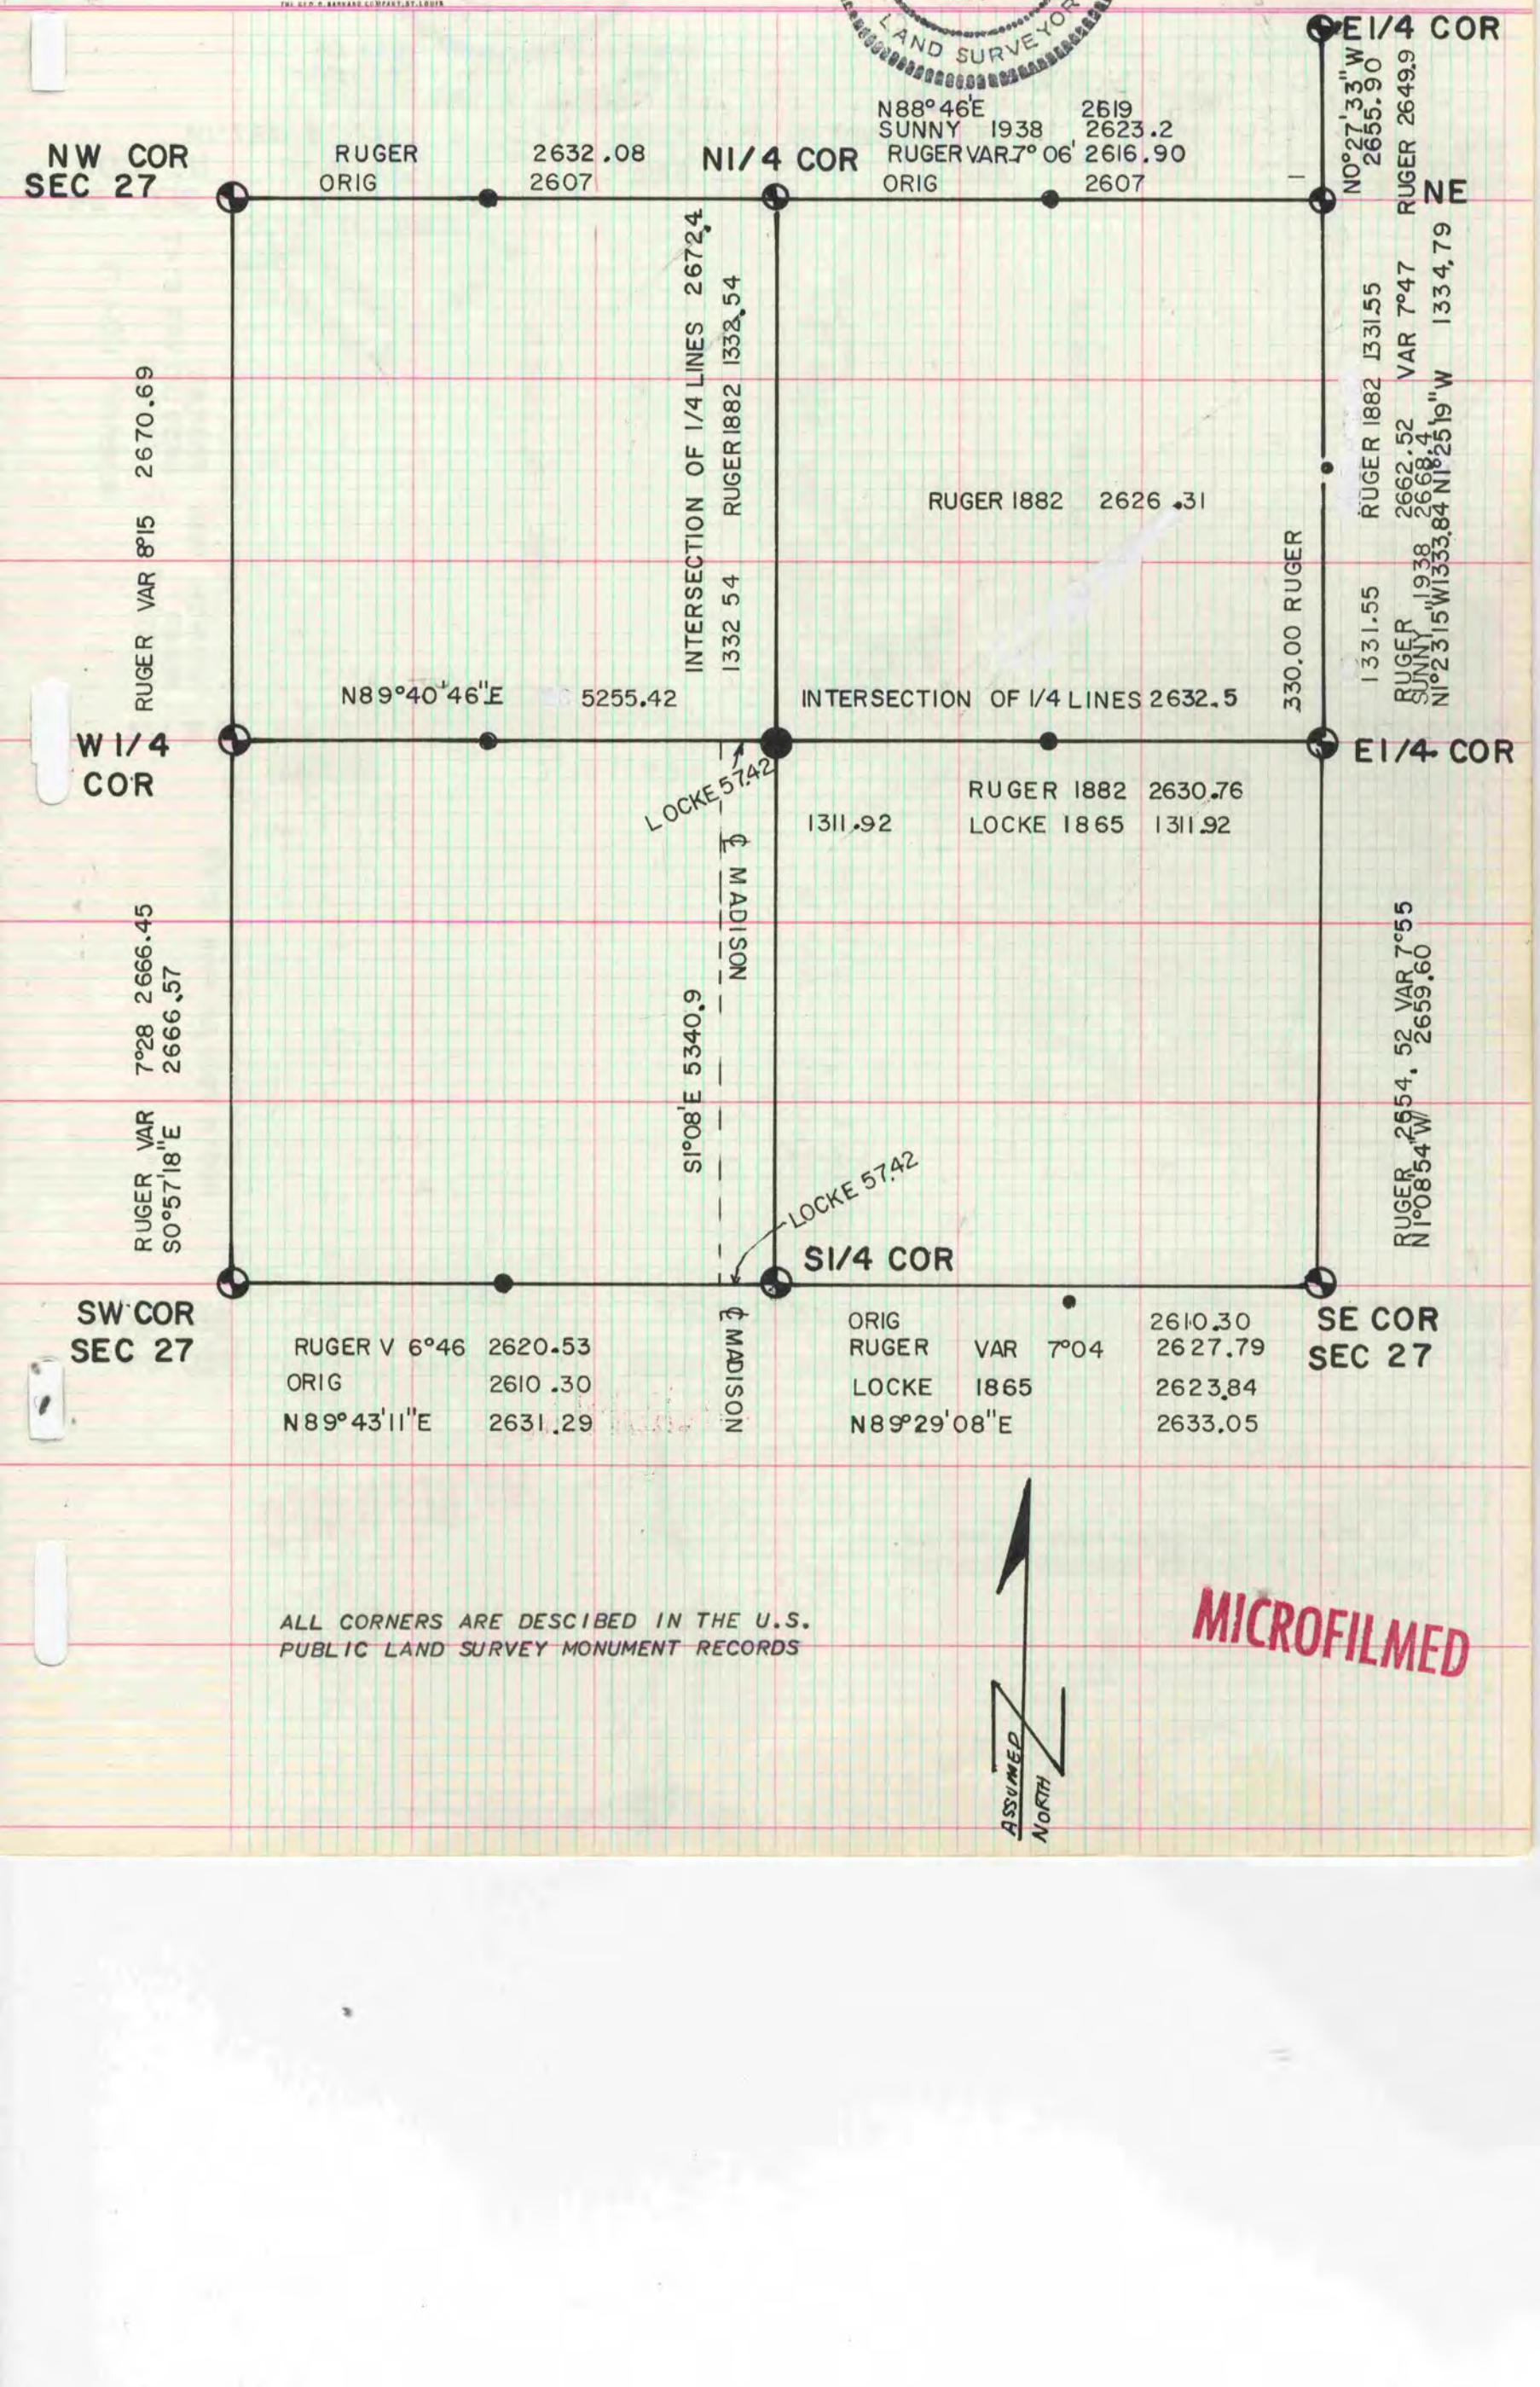

ALL CORNERS ARE DESCIBED IN THE U.S. PUBLIC LAND SURVEY MONUMENT RECORDS

MICROFILMED