323 1/2
V-2

PLAT AND RECORD

MICROFILMED

Of a Survey on Section NW¼ 30 T 3 R 13 E. of the 4 P. M. in Harmony Township

Rock County, Wisconsin, made May the 26 & 27th 1881

I hereby certify that the following is a correct record of said survey as made by me.

COUNTY BUILDING
CITY OF JANESVILLE

(Signed) R. K. Lee
R.H.B County Surveyor.

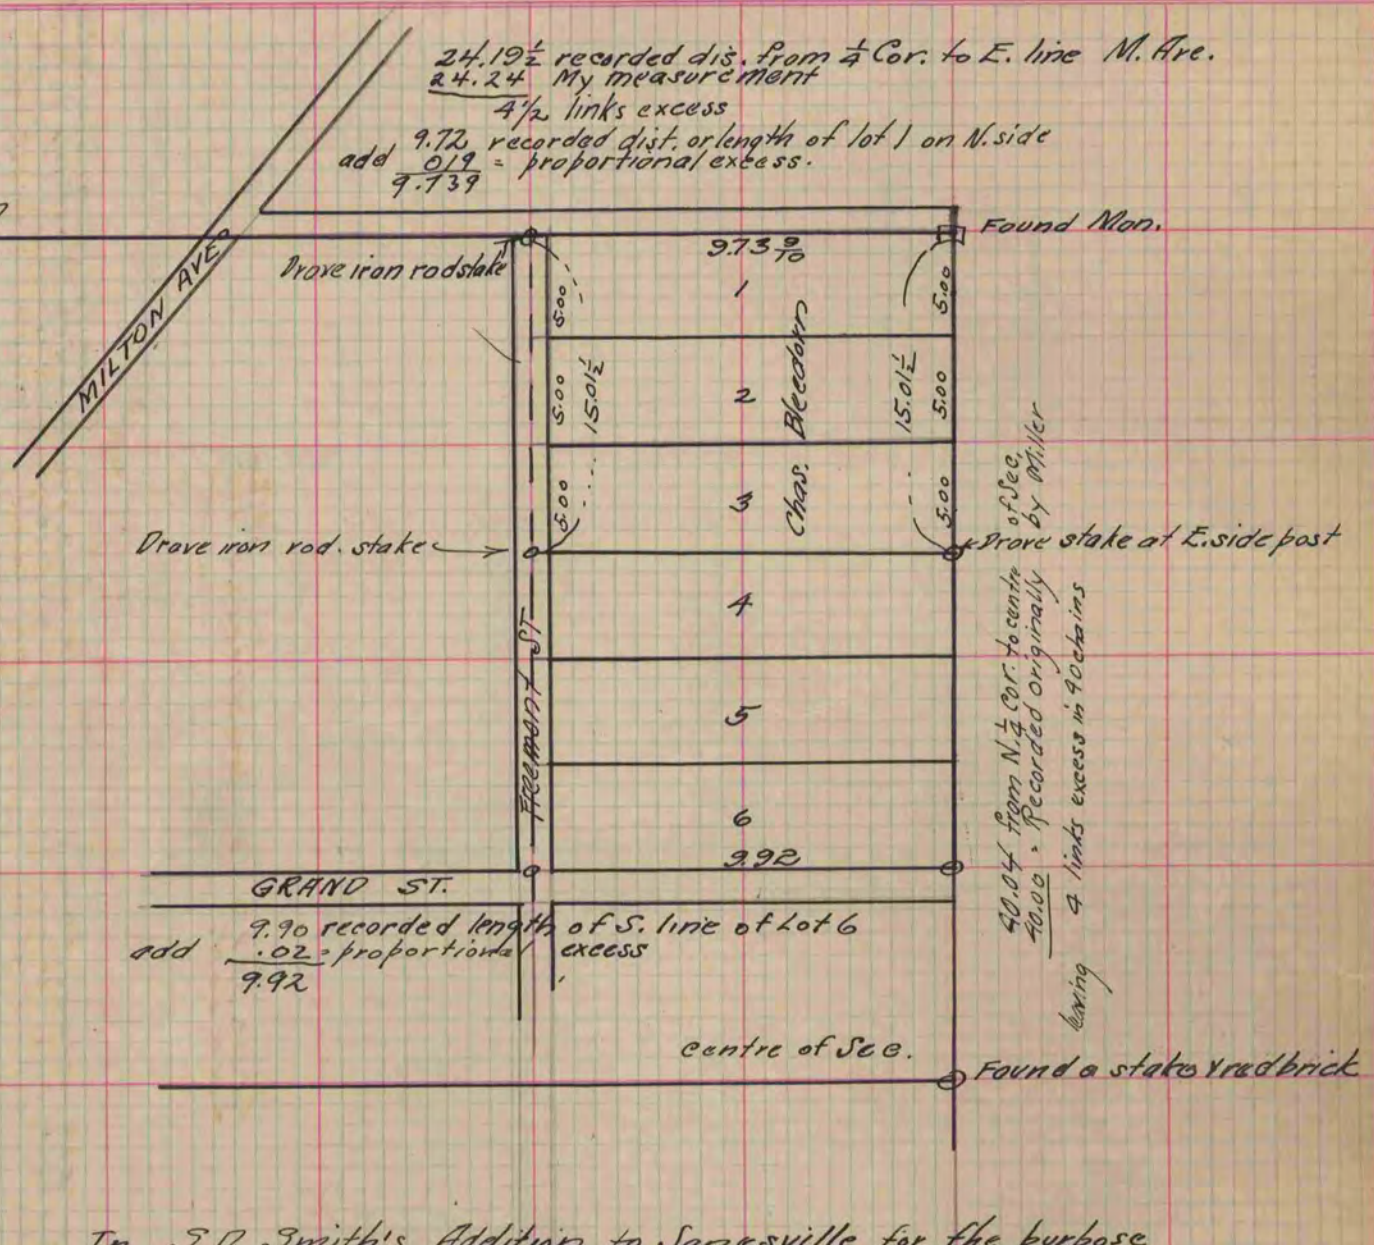

In S.D. Smith's Addition to Janesville for the purpose of determining the boundaries of Lots 1, 2 & 3 in said Addn.

Copied from page 266 County Surveyors Record.