282
V-2

MICROFILMED

PLAT AND RECORD

Of a Survey on Section 11 T 4 R 11 E. of the 4 P. M. in Porter Township

Rock County, Wisconsin, made August the 27 1886

I hereby certify that the following is a correct record of said survey as made by me.

COUNTY BUILDING
CITY OF JANESVILLE

(Signed) Edward Ruger
R.H.B. County Surveyor.

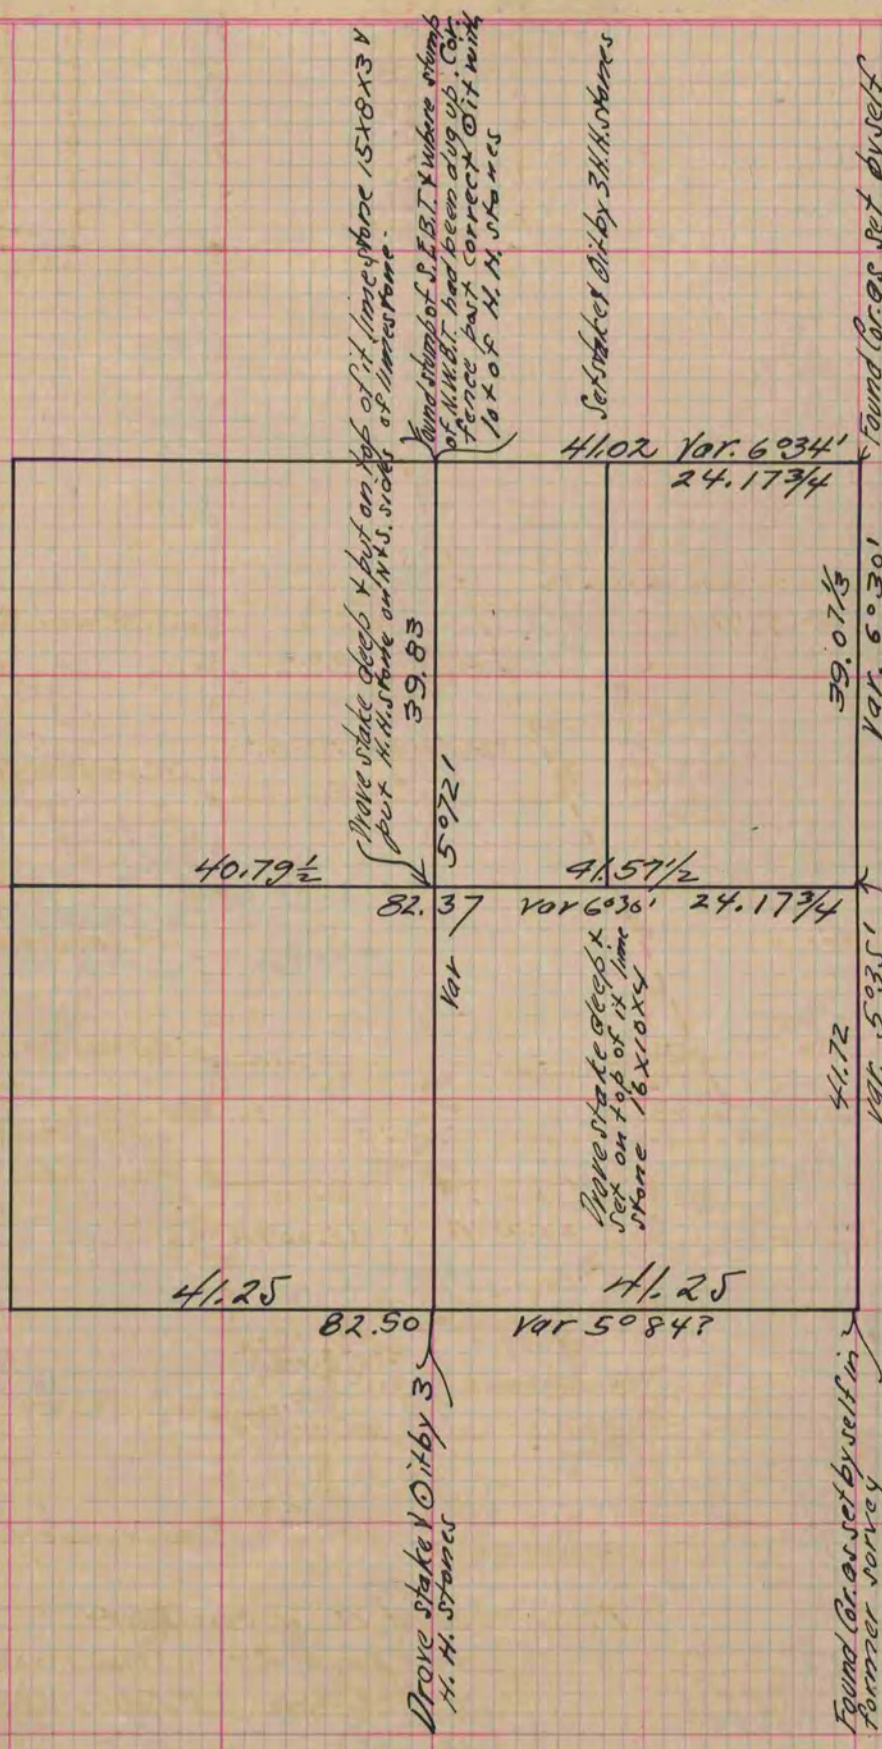

Copied from P. 234 Vol. 2. County Surveyors Record.