MICROFILMED
COUNTY BUILDING
CITY OF JANESVILLE

PLAT AND RECORD

Of the Survey on Section 13 T 3 R 14 E. of the 4 P. M. in Johnstown Township

Rock County, Wisconsin, made May the 3rd to 5th 1863

I hereby certify that the following is a correct record of said survey as made by me.

(Signed) S. P. Locke
R.H.B. County Surveyor.

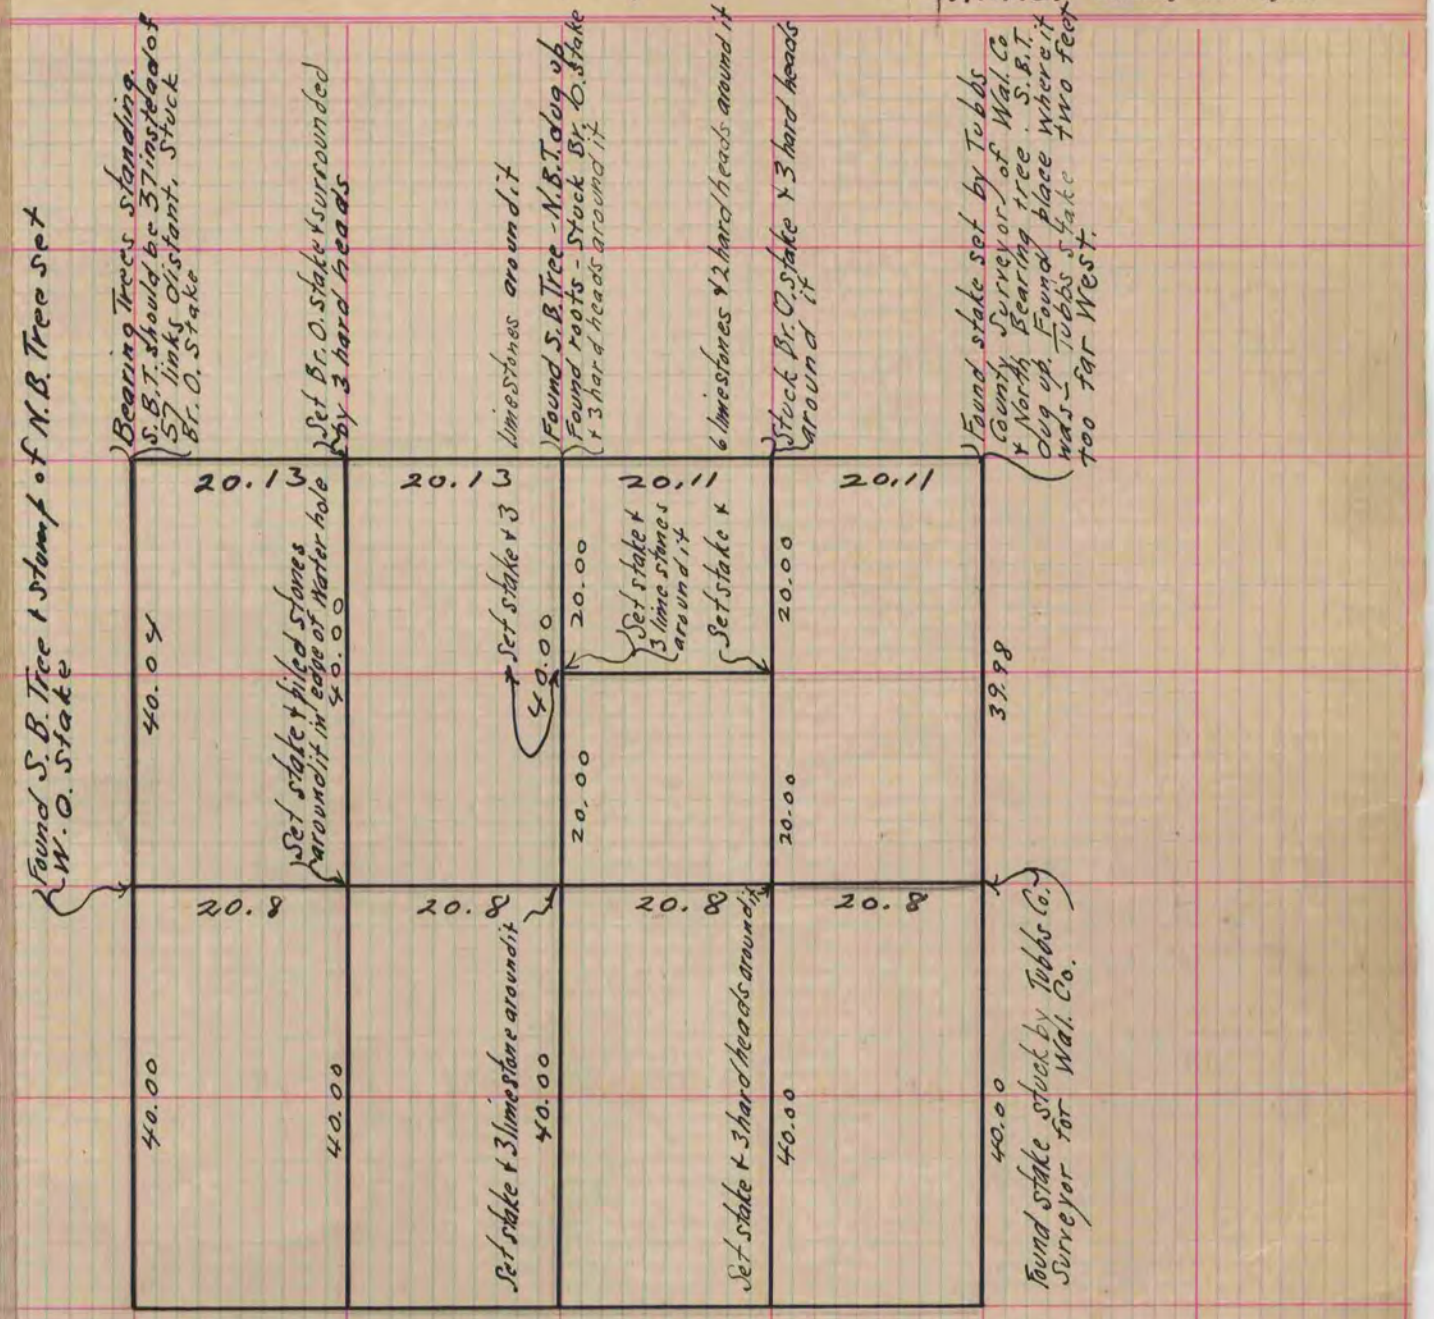

For Stakes & Monuments on South line See Sec. 24 T3R14E
Set stakes every 10 chains on North & South lines (Interior)

Copied from Page 188 Vol. One Original County Surveyors Record