18
VI

MICROFILMED

PLAT AND RECORD

Of a Survey on Section 5 T 1 R 10 E. of the 4 P. M. in Avon Township

Rock County, Wisconsin, made March the 25th 1853

I hereby certify that the following is a correct record of said survey as made by me.

COUNTY BUILDING
CITY OF JANESVILLE

(Signed) Peter McVean
R.H.B. County Surveyor.

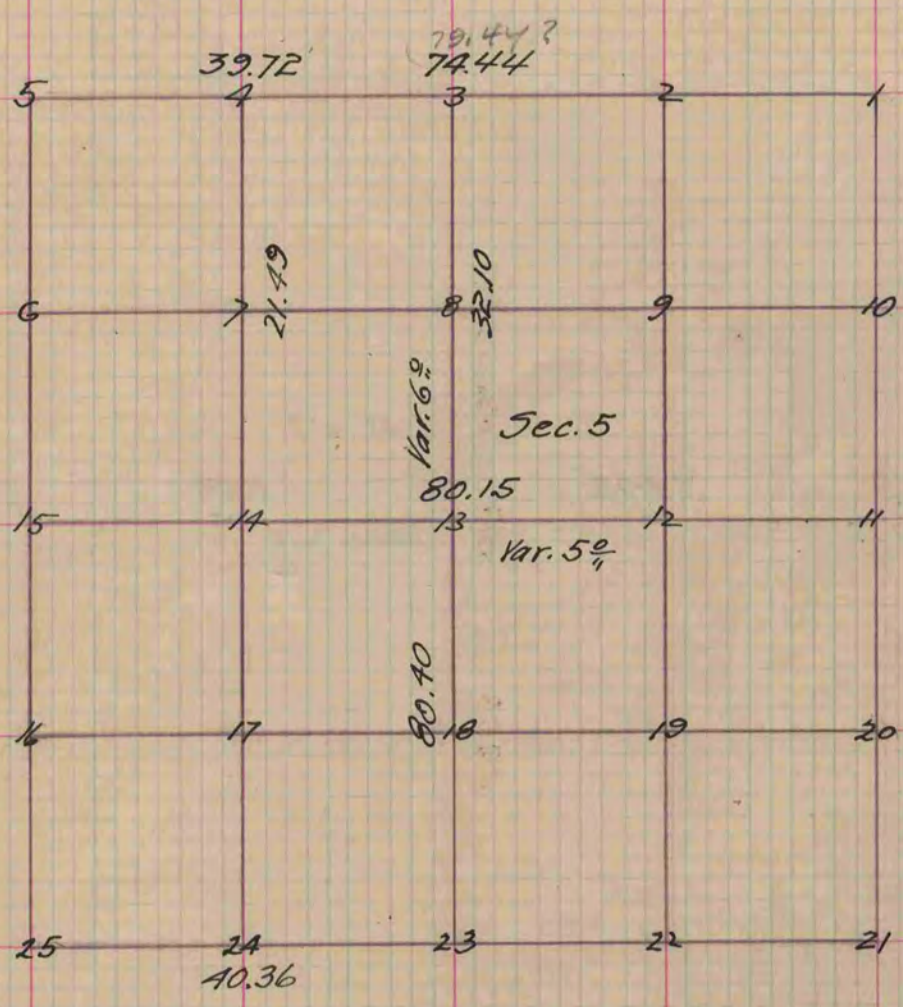

Figure 3 Represents the quarter post on the Town line N. Side of the section.

Figure 3 Br. O. 145. 43 E. 11 1/2 Also Br. O. 12 S 64 1/2 W. 27
" 24 Bl. O. 10 N 47 1/2 E 94 Also W. O. 105. 6 W. 76
" 4 W. O. 145. 14 E 43 Also W. O. 10 N. 30 W 45 1/2

Copied from Page 19 Vol. 1. Original County Surveyors Record