PLAT AND RECORD

417
VOL. 6

Of a Survey on Section 3 T 4 N. R 11 E. of the 4 P. M. in PORTER Township

Rock County, Wisconsin, made AUGUST the 12th 1991

I hereby certify that the following is a correct record of said survey as made by me.

COUNTY BUILDING
CITY OF JANESVILLE

County Surveyor.

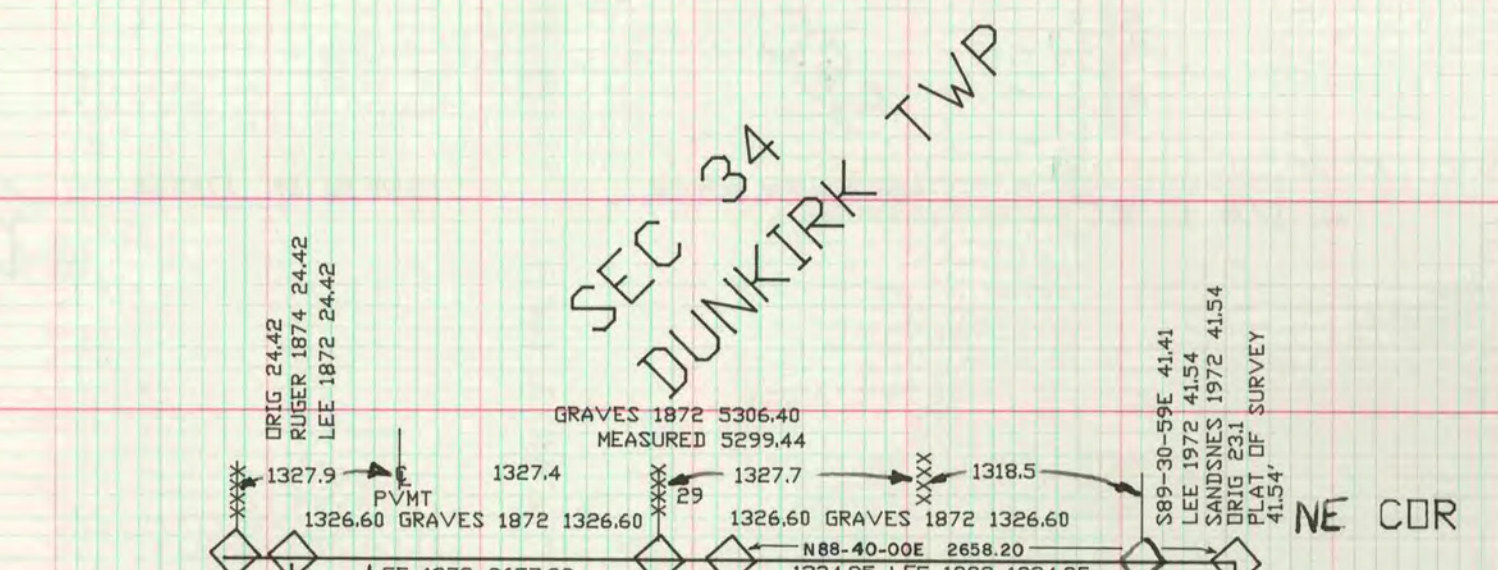

BEARINGS AND DISTANCES ARE BASED ON
TRAVERSE INFORMATION THAT WAS PROVIDED BY
GLEN NORTHROP
N 1/4 CORNER WAS ESTABLISHED BY USING THIS INFORMATION.

VOLUME 2 PG 82 WAS COPIED INCORRECTLY FROM ORIGINAL
COUNTY SURVEYORS RECORD VOL 2 PG 50. THE NORTH LINE
OF THE NE 1/4 SHOULD READ 40.27 INSTEAD OF 40.29