



Of a Survey on Section **11,12,13,14** T **3** R **10** E. of the 4 P. M. in **MAGNOLIA** Township
Rock County, Wisconsin, made **JULY 28** 19**80**

I hereby certify that the following is a correct record of said survey as made by me.

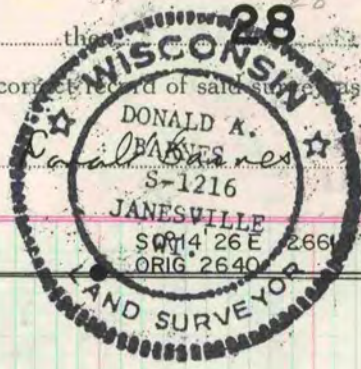

County Surveyor.

MICROFILMED

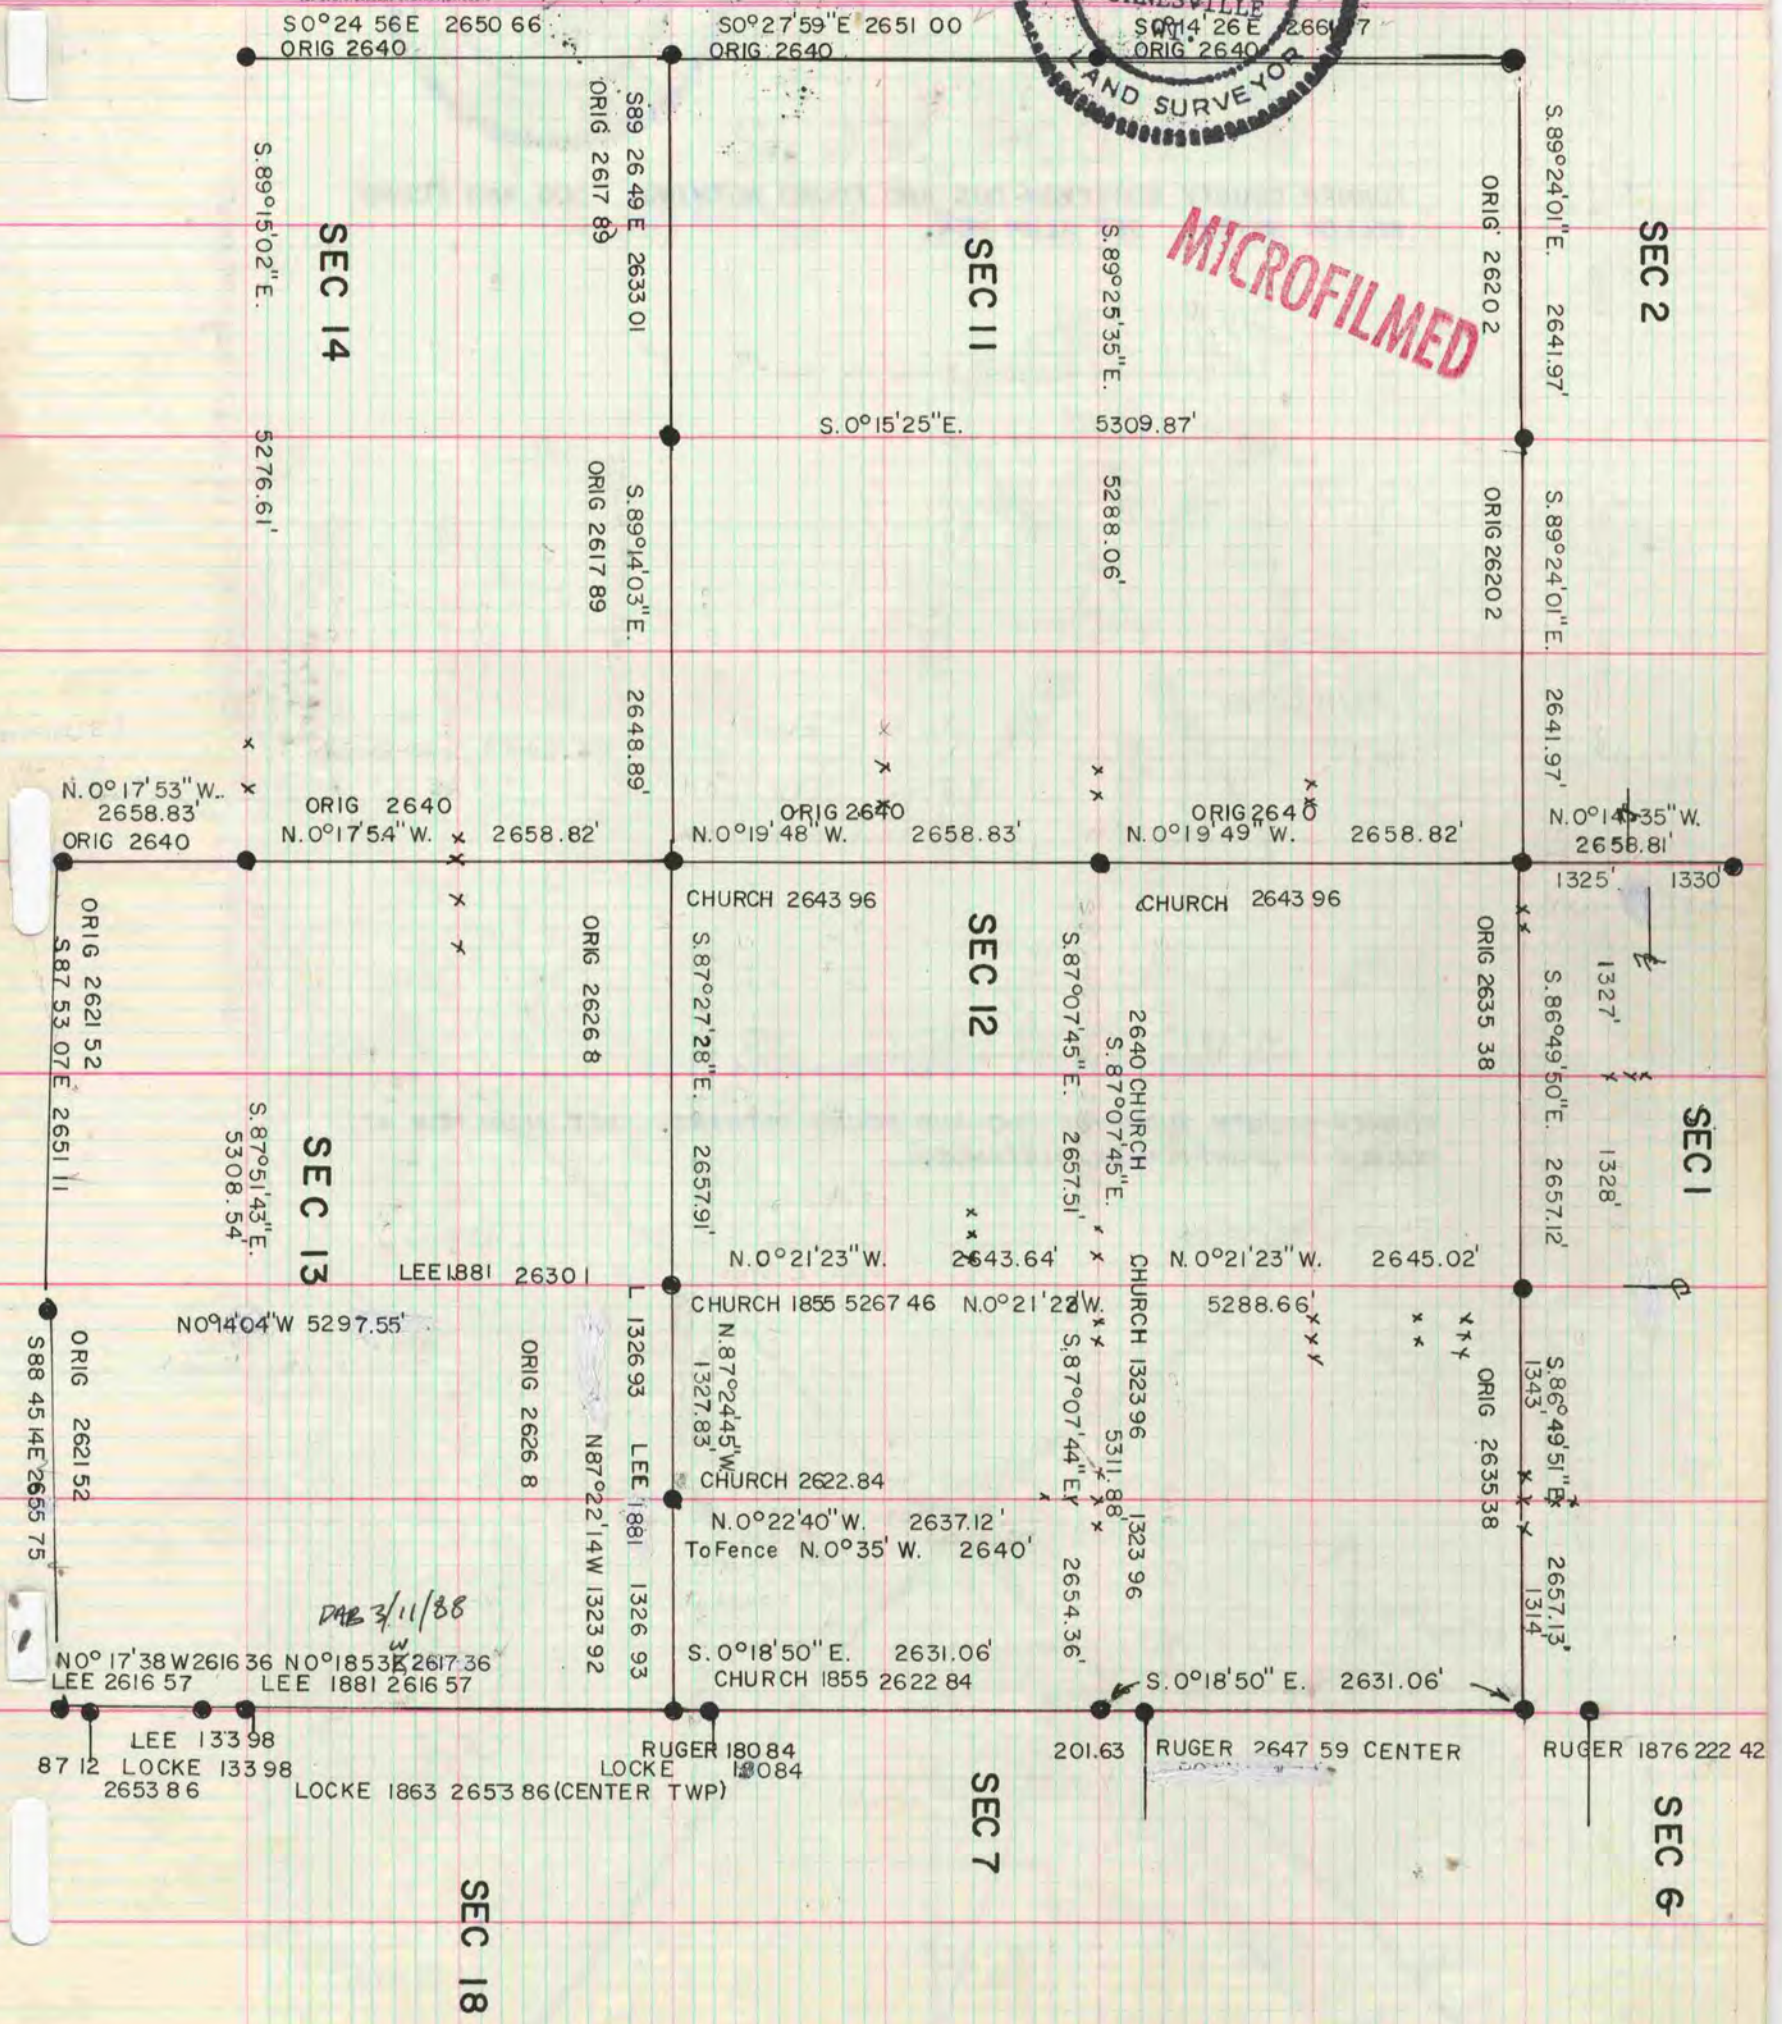

DAB 3/11/88

N. 0° 17' 38\" W. 2616.36
LEE 2616.57

LOCKE 1863 2653.86 (CENTER TWP)
RUGER 180.84
LOCKE 180.84

RUGER 2647.59 CENTER
201.63

RUGER 1876.222 42