158

# PLAT AND RECORD

VOL. 6

Of a Survey on Section 27 T 4 R 10 E. of the 4 P. M. in UNION Township

Rock County, Wisconsin, made APRIL the 23 1968

I hereby certify that the following is a correct record of said survey as made by me.

DONALD A. BARNES 1916 JANESVILLE WI LAND SURVEYOR

Donald Barnes County Surveyor.

COUNTY BUILDING
CITY OF JANESVILLE

## S 1/4 COR SEC 27

DATA SUPPLIED BY WALWORTH COUNTY SURVEYOR

PAGE "A"

7" SQ. LIMESTONE

N

FOUND BOTTOM OF STONE DOWN 22" BELOW ROAD SURFACE

86.5" x PK

83 1/4" x PK

LLJ & CITY OCT. 1968

MADISON STR.

MICROFILMED

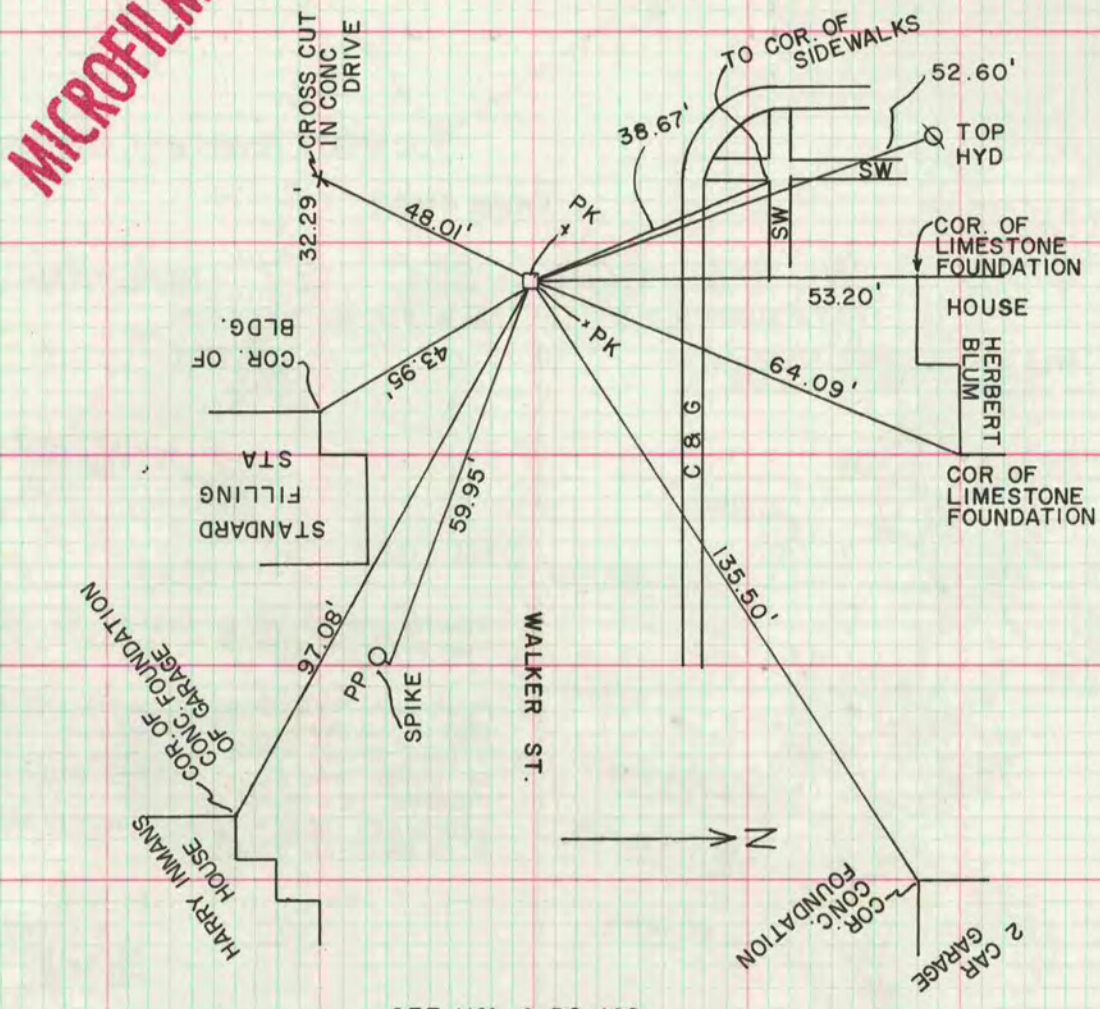


SEE VOL. 6 PG. 162