PLAT AND RECORD

179

VOL. 6

Of a Survey on Section 5 T. 1 R. 12 E. of the 14 P.M. in JOHNSTOWN BELOIT Township

Rock County, Wisconsin, made JULY 24 19 81

I hereby certify that the following is a correct record of said survey as made by me.

COUNTY BUILDING
CITY OF JANESVILLE

WISCONSIN
DONALD A. BARNES
S-1206
JANESVILLE
WI.
LAND SURVEYOR

Donald A. Barnes

County Surveyor.

THE GEO. F. BARNARD COMPANY, ST. LOUIS

IN VOL 6 PG 108 THE DISTANCE FROM THE E¼ COR SEC 5 TO THE NE COR SEC 5 IS ERRONEOUS.

SHOWN: LEE 2924.64
SHOULD BE LEE 2916.68

MICROFILMED

N 1/4 COR. SEC. 14
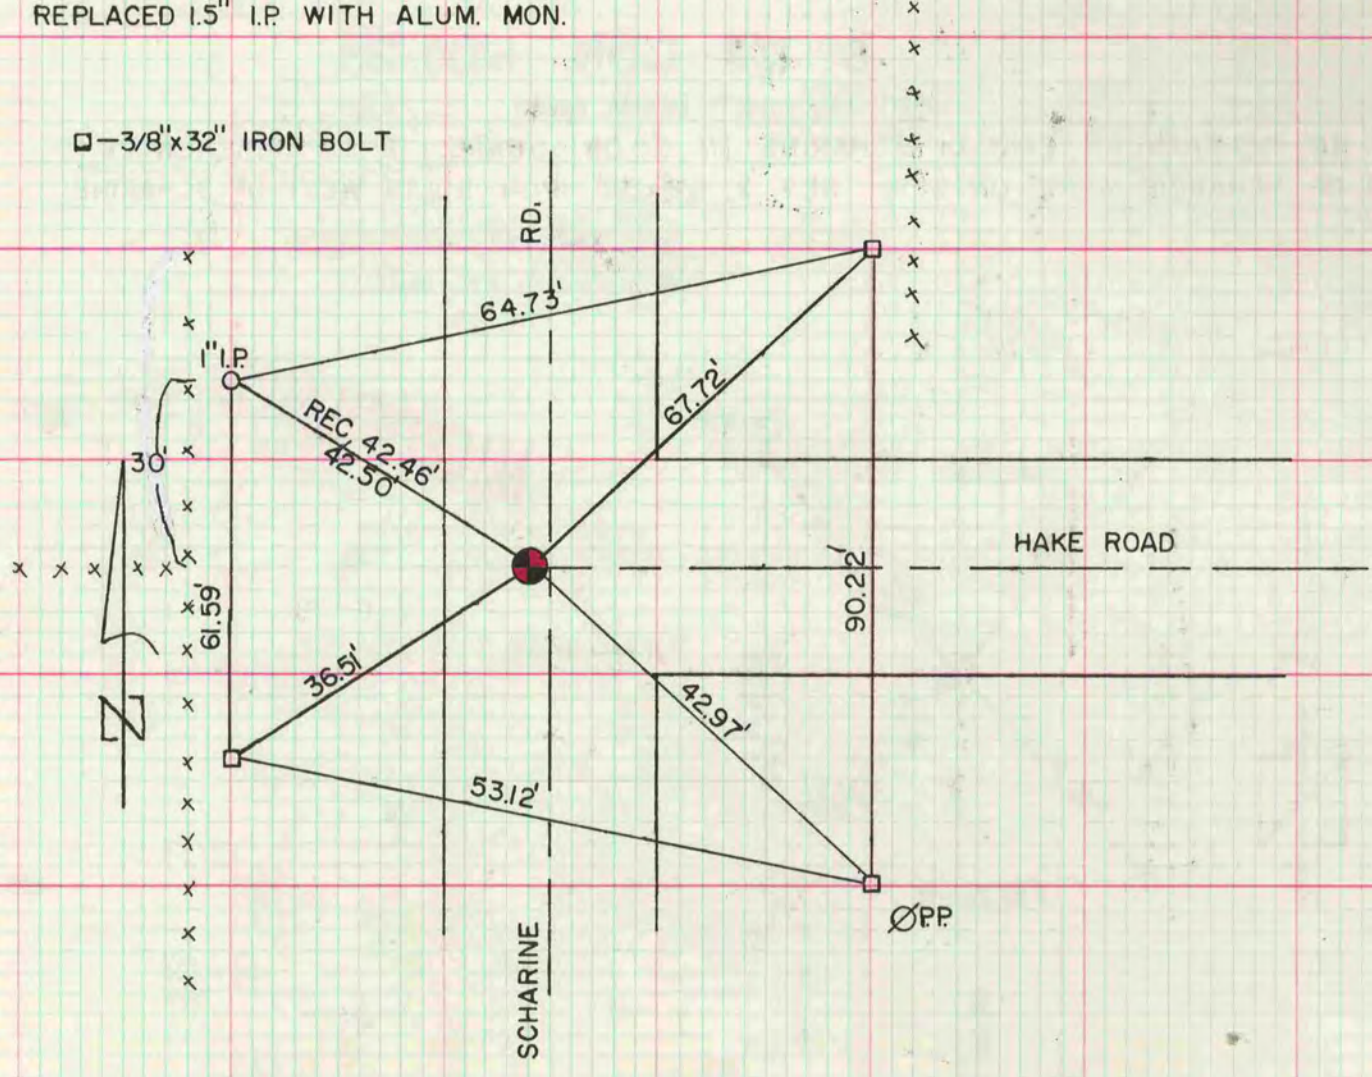
FD. PAINTED BEER CAN IN PAVEMENT, FD. 1" I.P. BELOW, FD. 1.5"x 36" I.P BELOW 1" I.P. REPLACED 1.5" I.P. WITH ALUM. MON.