# PLAT AND RECORD

561
VOL. 5

Of a Survey on Section 18 T 2 R 11 E. of the 4 P. M. in PLYMOUTH Township

Rock County, Wisconsin, made OCTOBER the 9 1979

I hereby certify that the following is a correct record of said survey as made by me.

COUNTY BUILDING
CITY OF JANESVILLE

Donald Barnes County Surveyor.
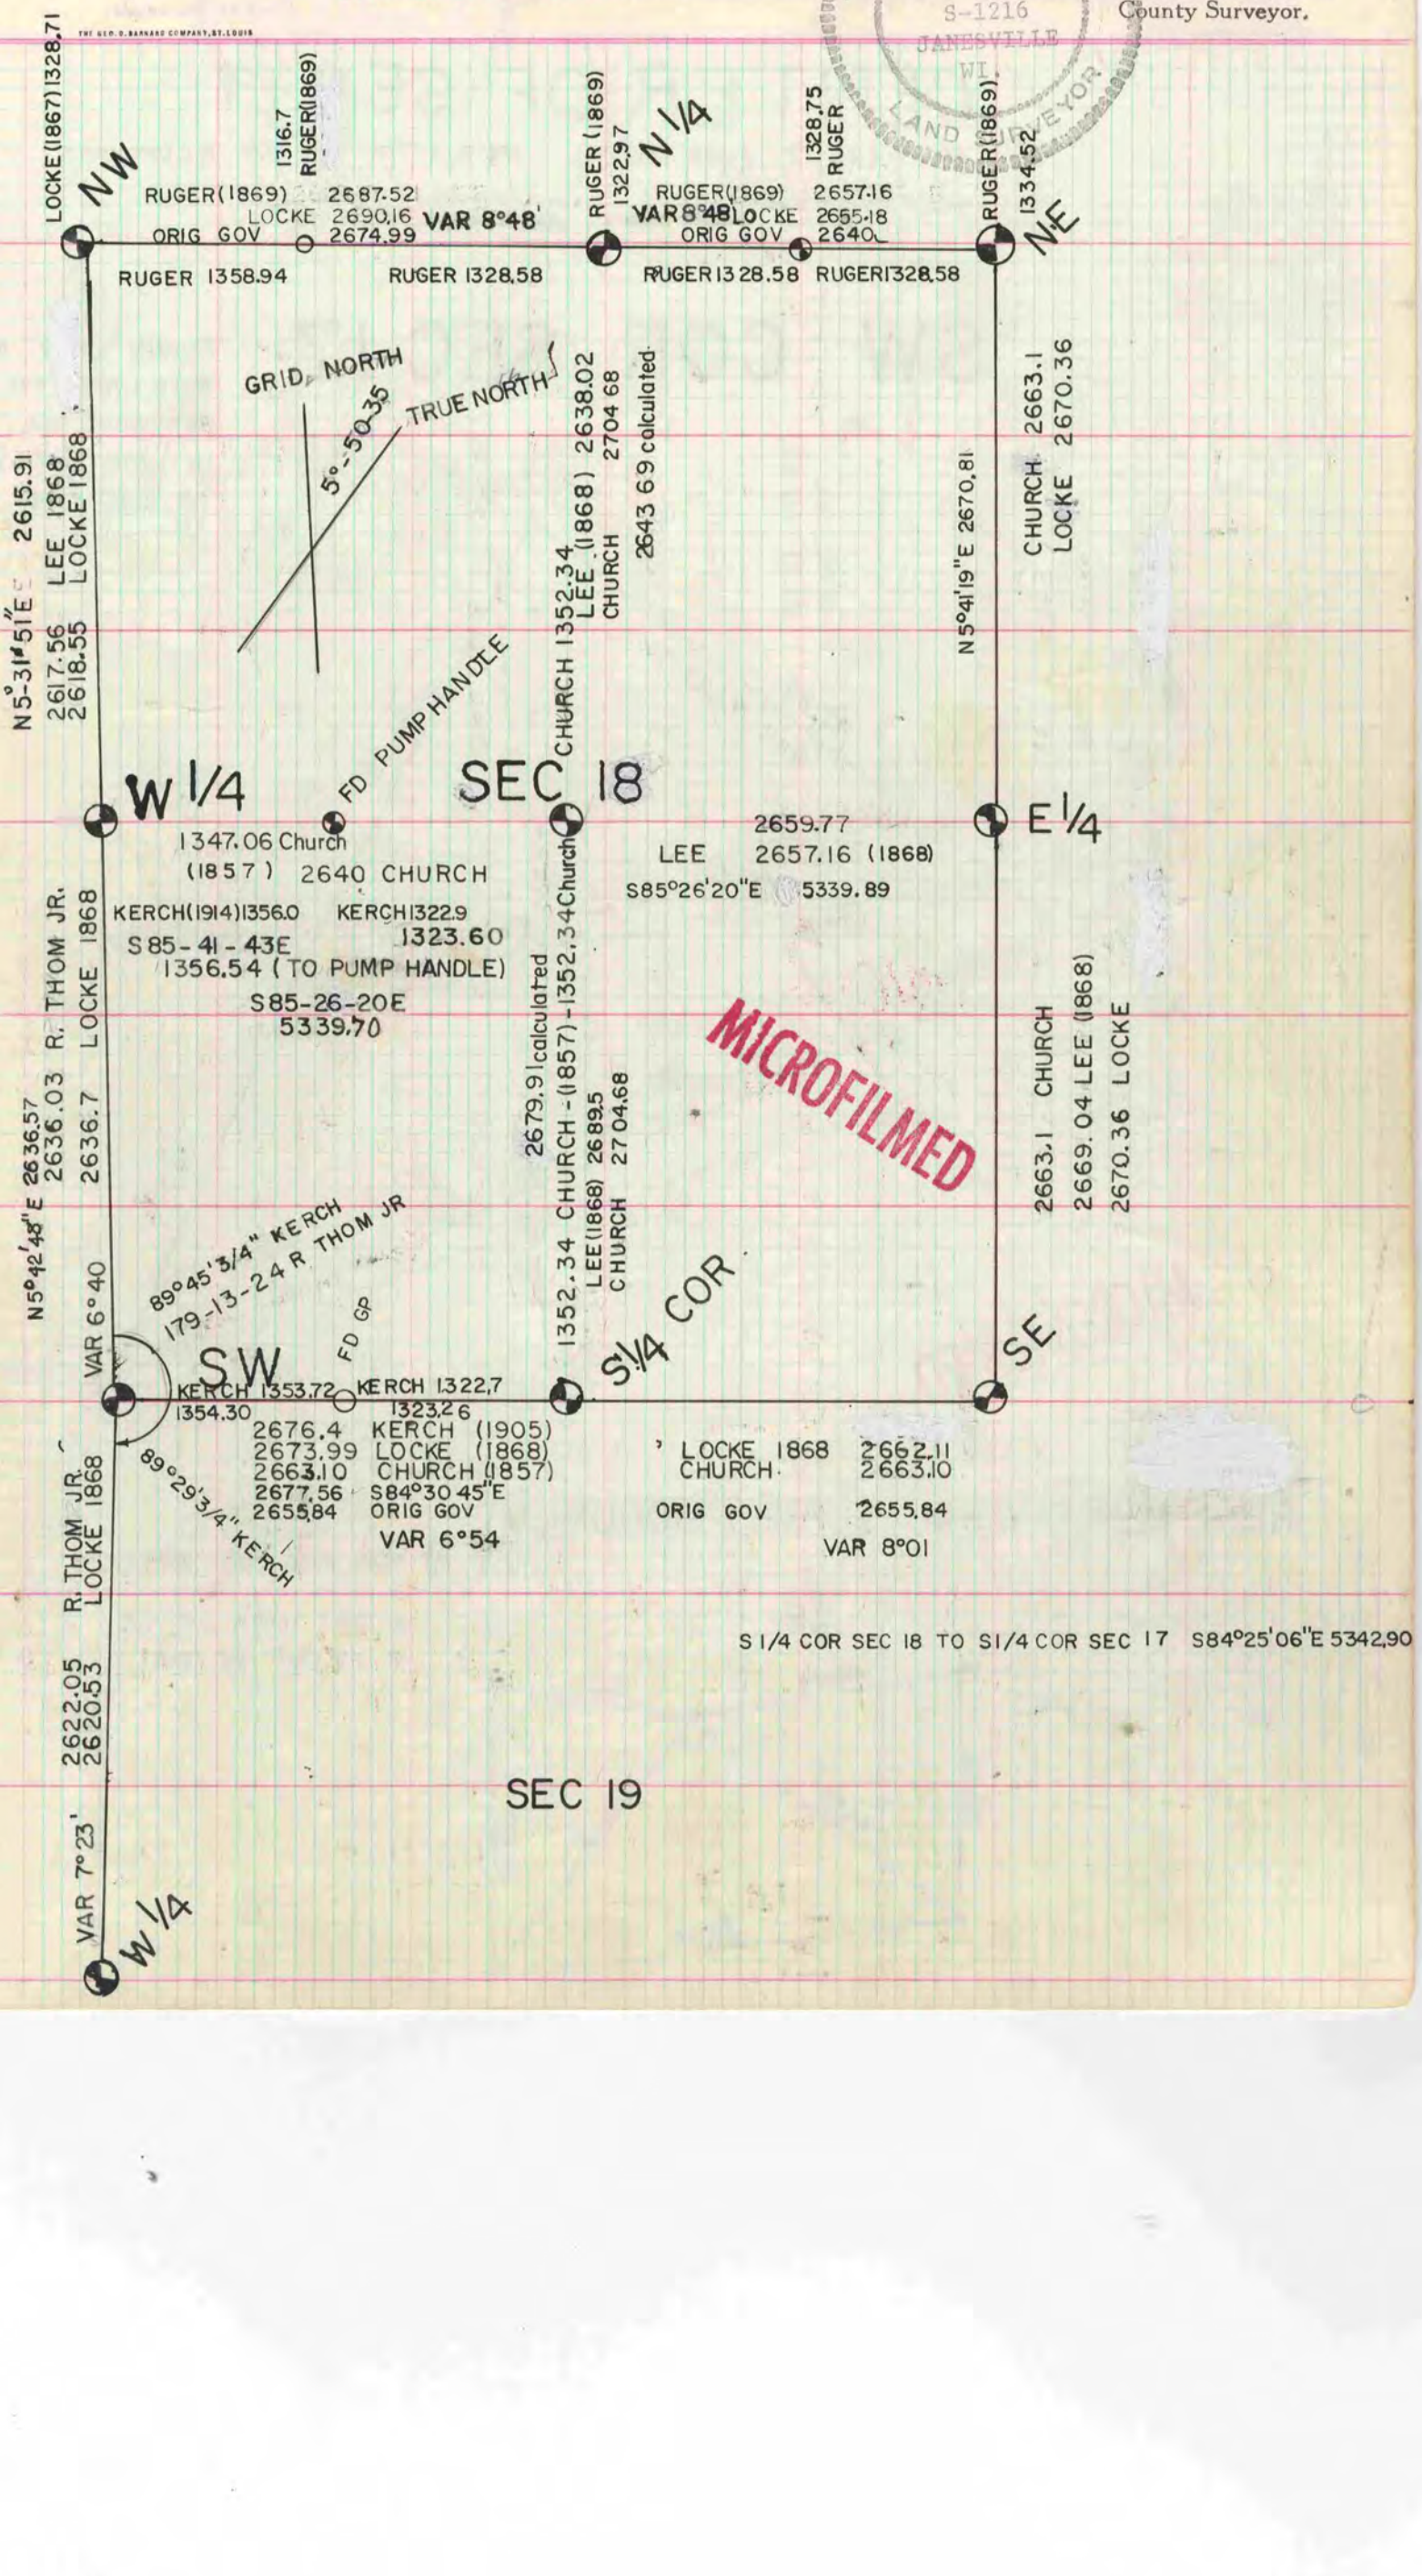
WISCONSIN
DONALD A.
BARNES
S-1216
JANESVILLE
WI.
LAND SURVEYOR