202
V-2
MICROFILMED

PLAT AND RECORD

Of a Survey on Section 2 T 1 R 13 E. of the 4 P. M. in Turtle Township

Rock County, Wisconsin, made January the 12+13 1876

I hereby certify that the following is a correct record of said survey as made by me.

COUNTY BUILDING
CITY OF JANESVILLE

(Signed) Edward Ruger
R.H.B. County Surveyor.

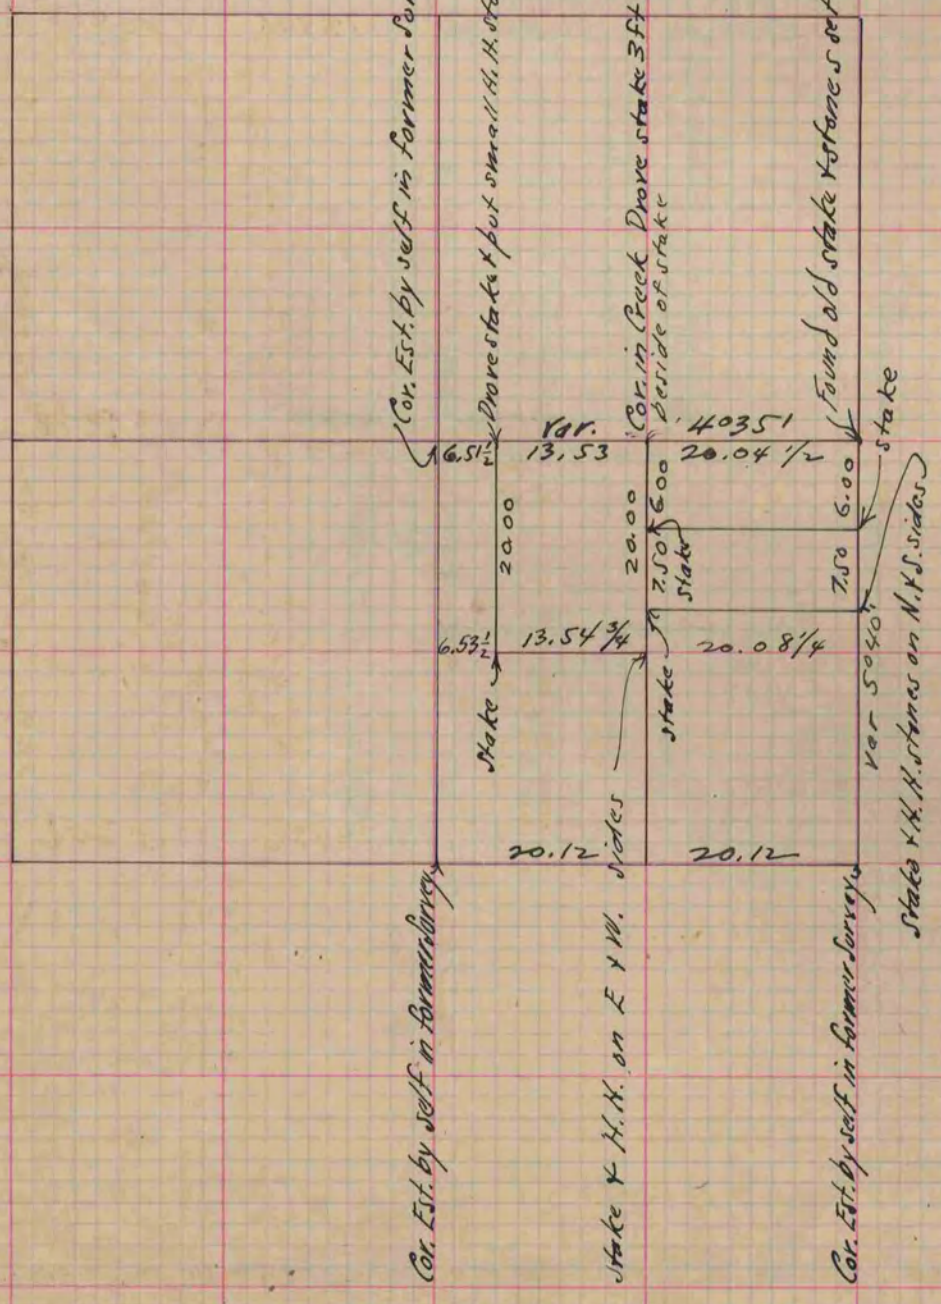

Copied from P. 156 Vol. 2 County Surveyors Record.