392
VOL. 6

PLAT AND RECORD

Of a Survey on Section 8 T 3 R 13 E. of the 4 P. M. in HARMONY Township

Rock County, Wisconsin, made Dec the 6 1988

I hereby certify that the following is a correct record of said survey as made by me.

Donald Barnes
County Surveyor.

WISCONSIN DONALD A. BARNES S-1216 JANESVILLE WI. LAND SURVEYOR

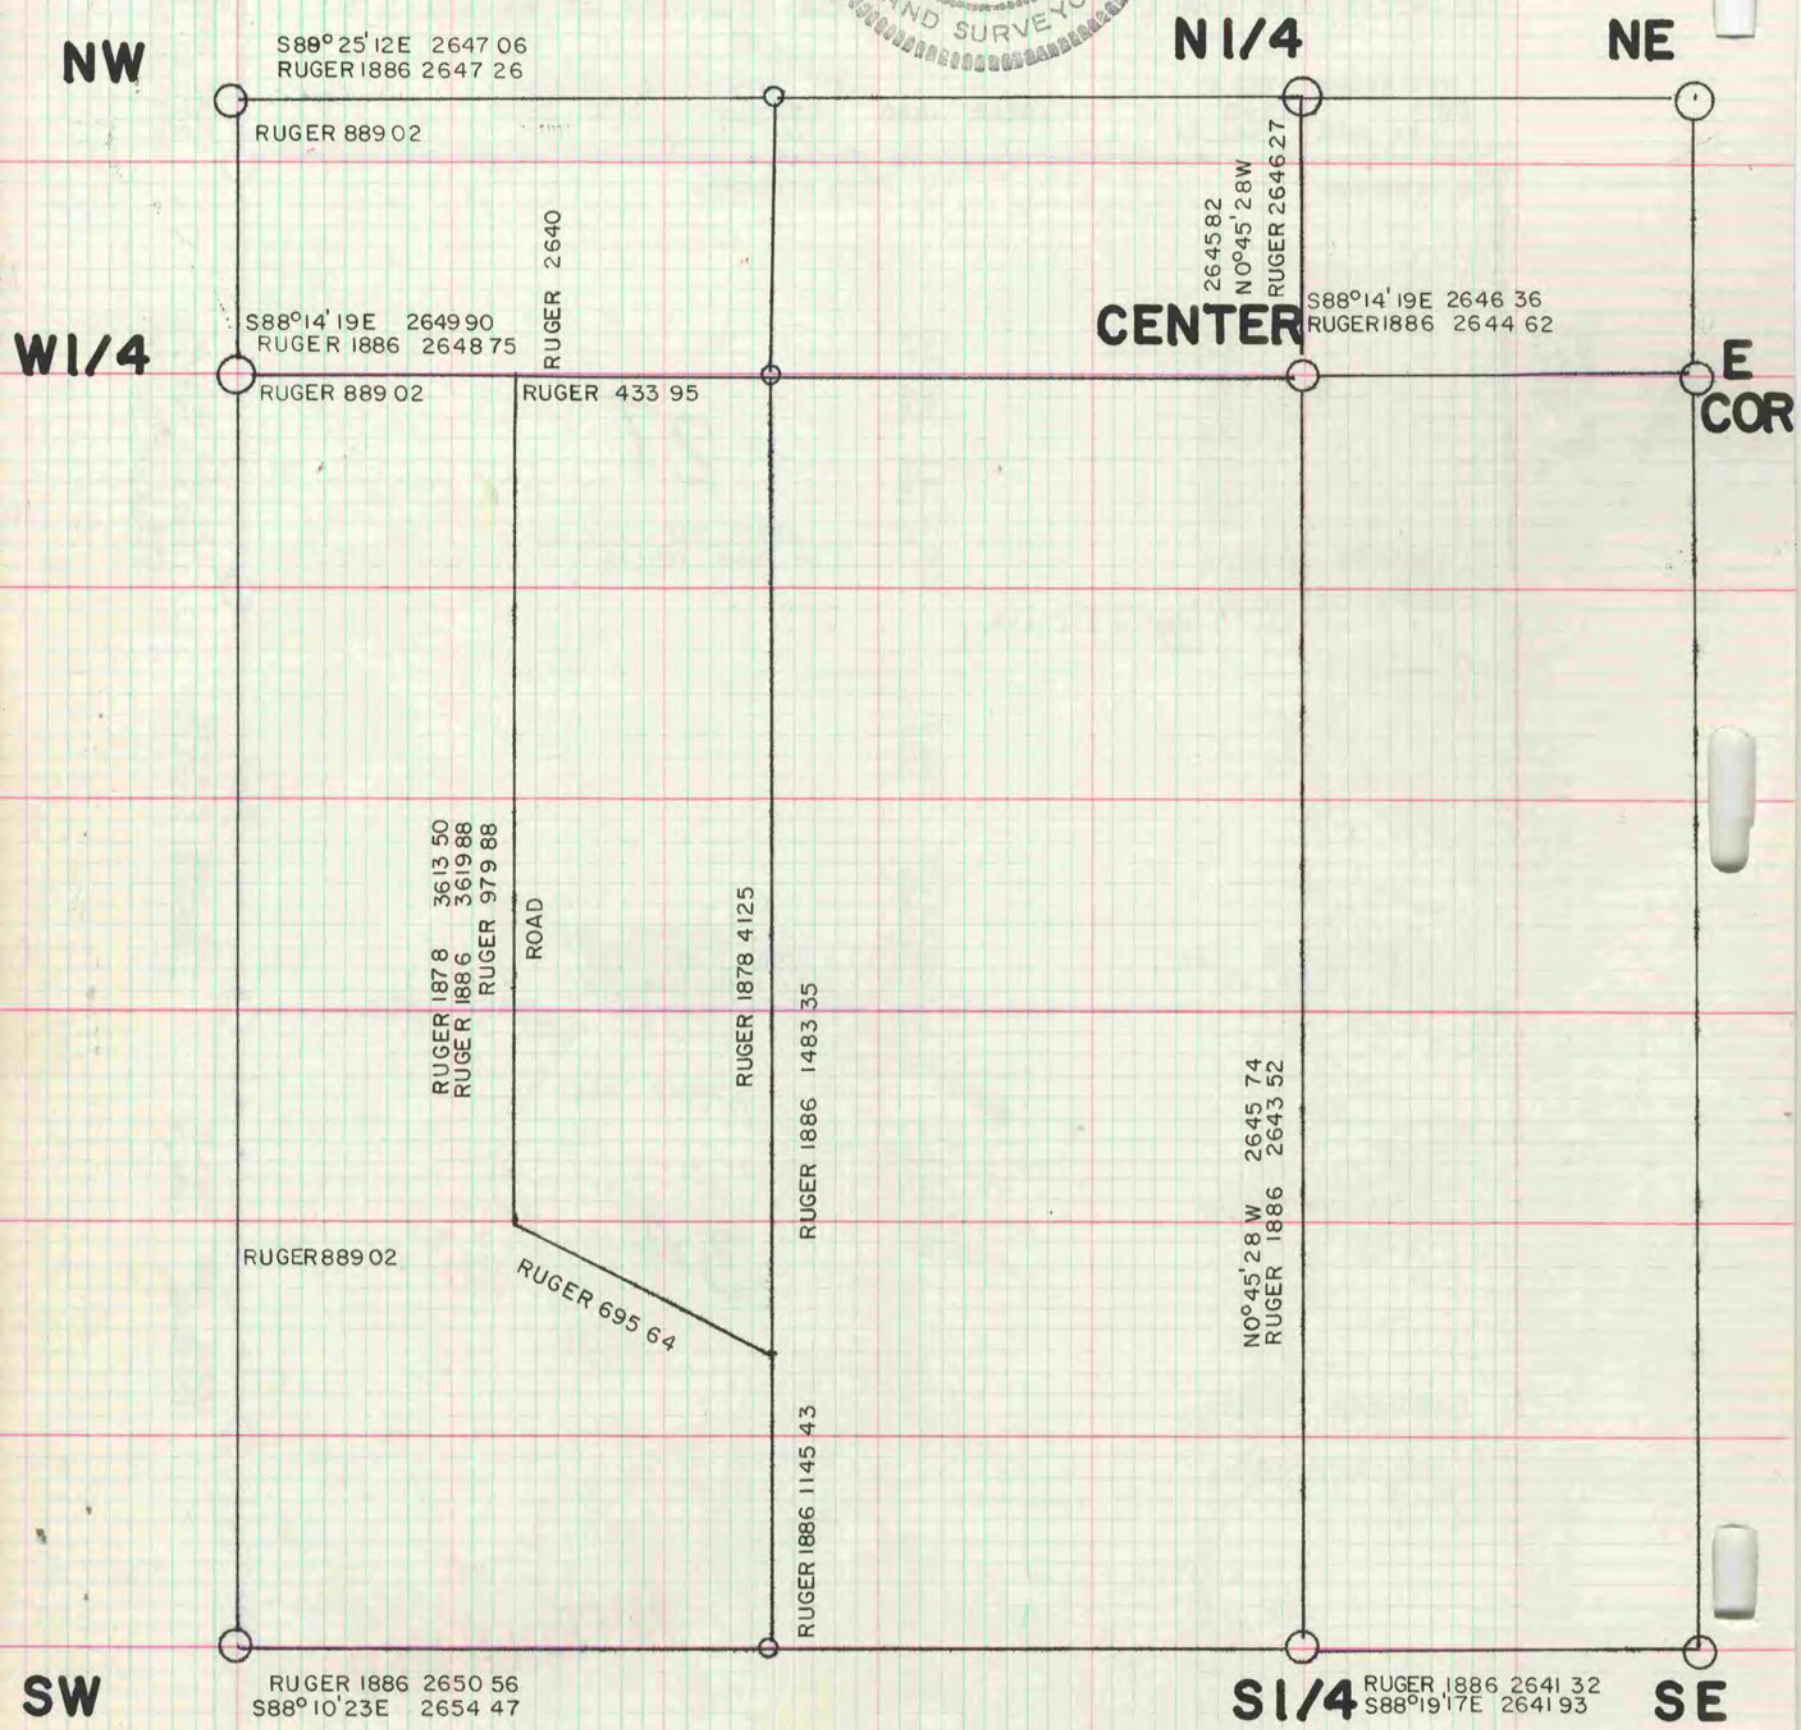

MAP COMPILED FROM RUGER'S MAPS & MY HARMONY TWP COORDINATES