PLAT AND RECORD

273
VOL. 6

Of a Survey on Section 7, T 4 R 10 E. of the 4 P. M. in UNION Township

Rock County, Wisconsin, made MAY the 16 1982

I hereby certify that the following is a correct record of said survey as made by me.

Donald A. Barnes 5-16-82

County Surveyor.

WISCONSIN
DONALD A. BARNES
JANESVILLE WI.
LAND SURVEYOR

COUNTY BUILDING
CITY OF JANESVILLE

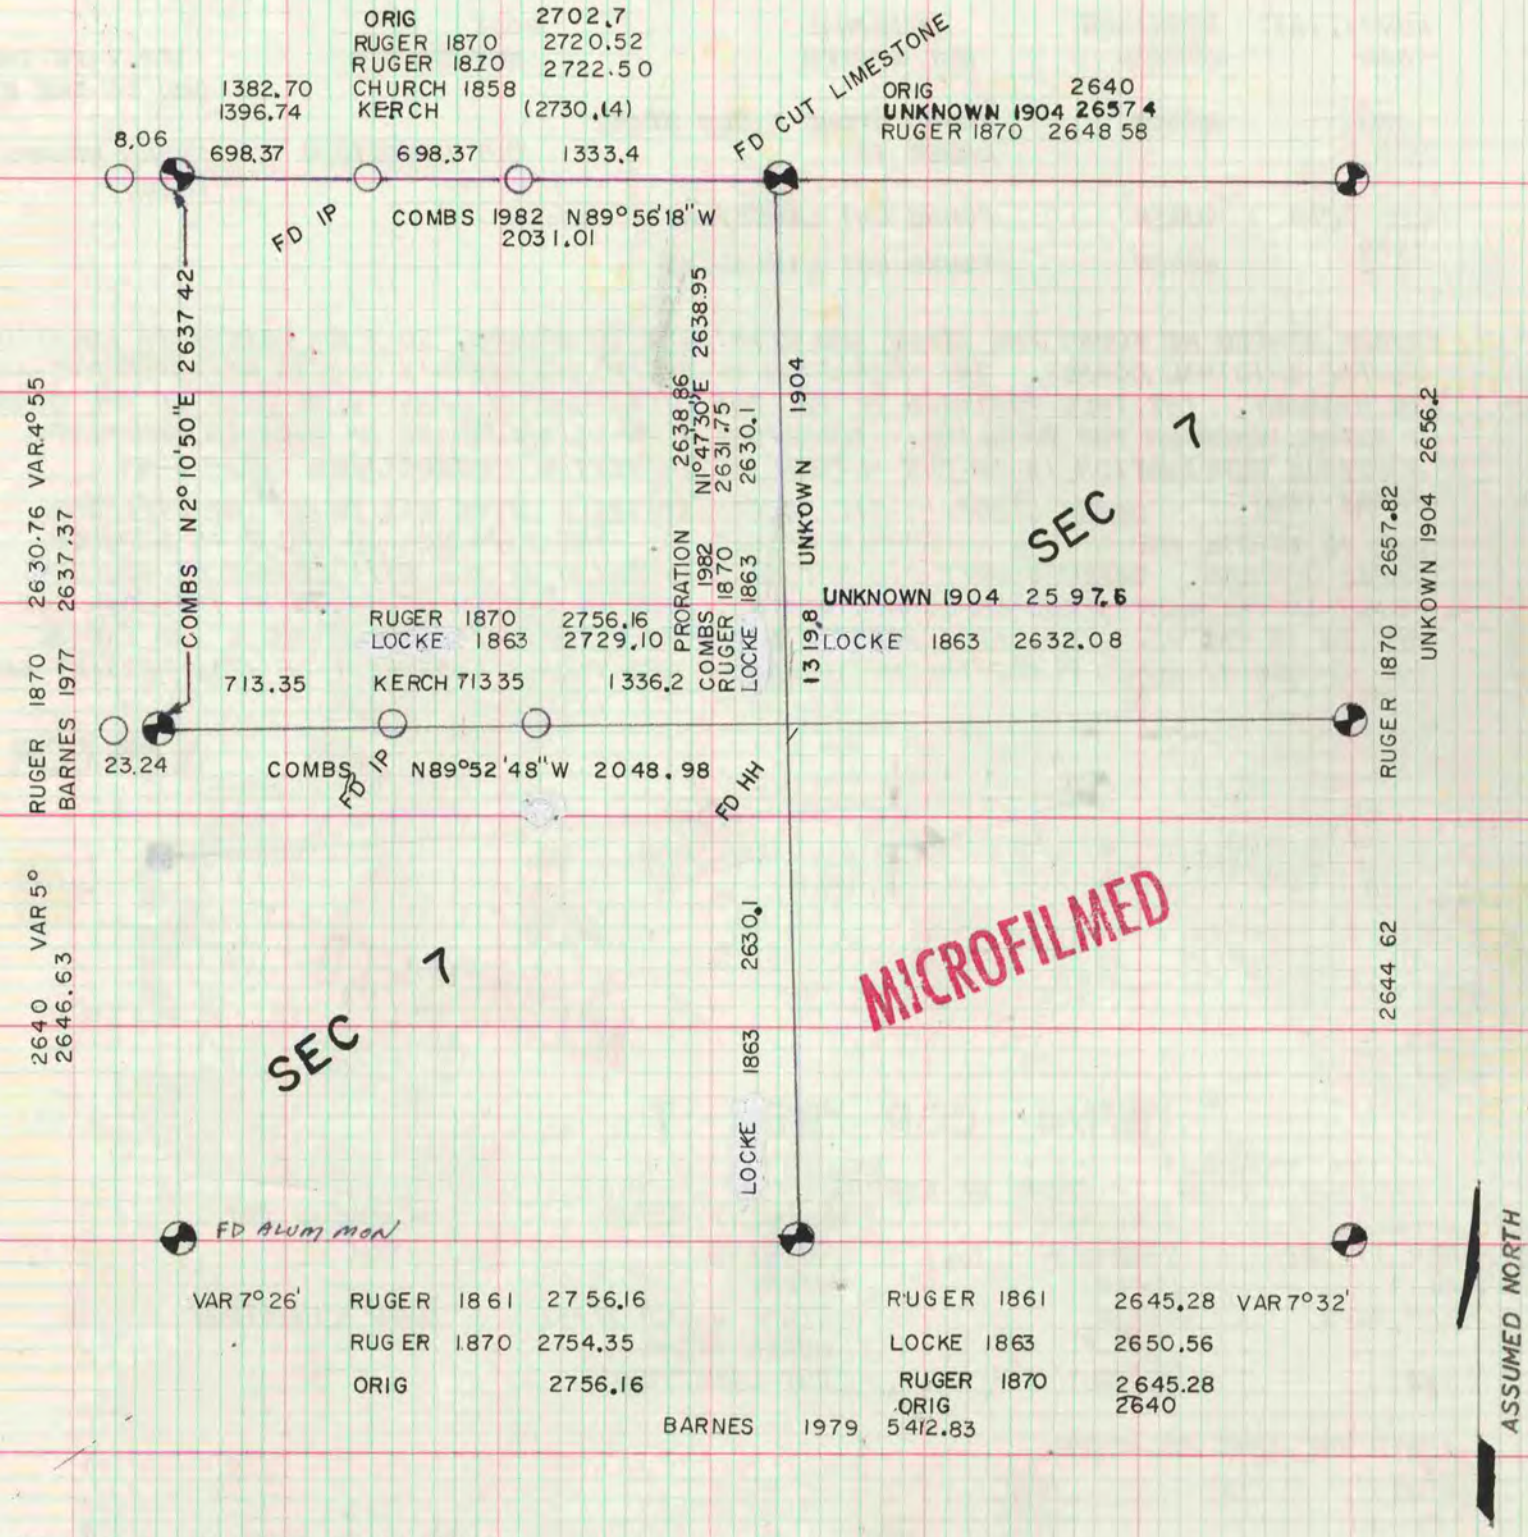

MICROFILMED

○ 3" ANGLE IRON SET IN CONCRETE
SEE VOL5 PG 530

□ N1/4 COR SEC 7 AND CENTER
OF SEC 7 PROJECTED SOUTH
2638.9' FROM THE CENTER

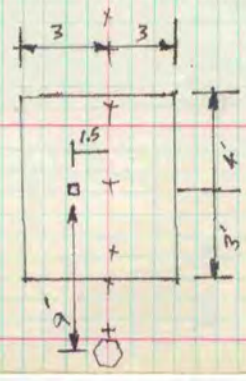

DUG 3' DEEP AND FOUND NOTHING
S1/4 COR OF SEC 7