236
V-1

PLAT AND RECORD

MICROFILMED

Of a Survey on Section 25,26,35&36 T 2 R 13 E. of the 4 P. M. in La Prairie Township

Rock County, Wisconsin, made June the 12, 13, 15&16 1865

I hereby certify that the following is a correct record of said survey as made by me.

COUNTY BUILDING
CITY OF JANESVILLE

(Signed) S. D. Locke
R. N. B. County Surveyor.

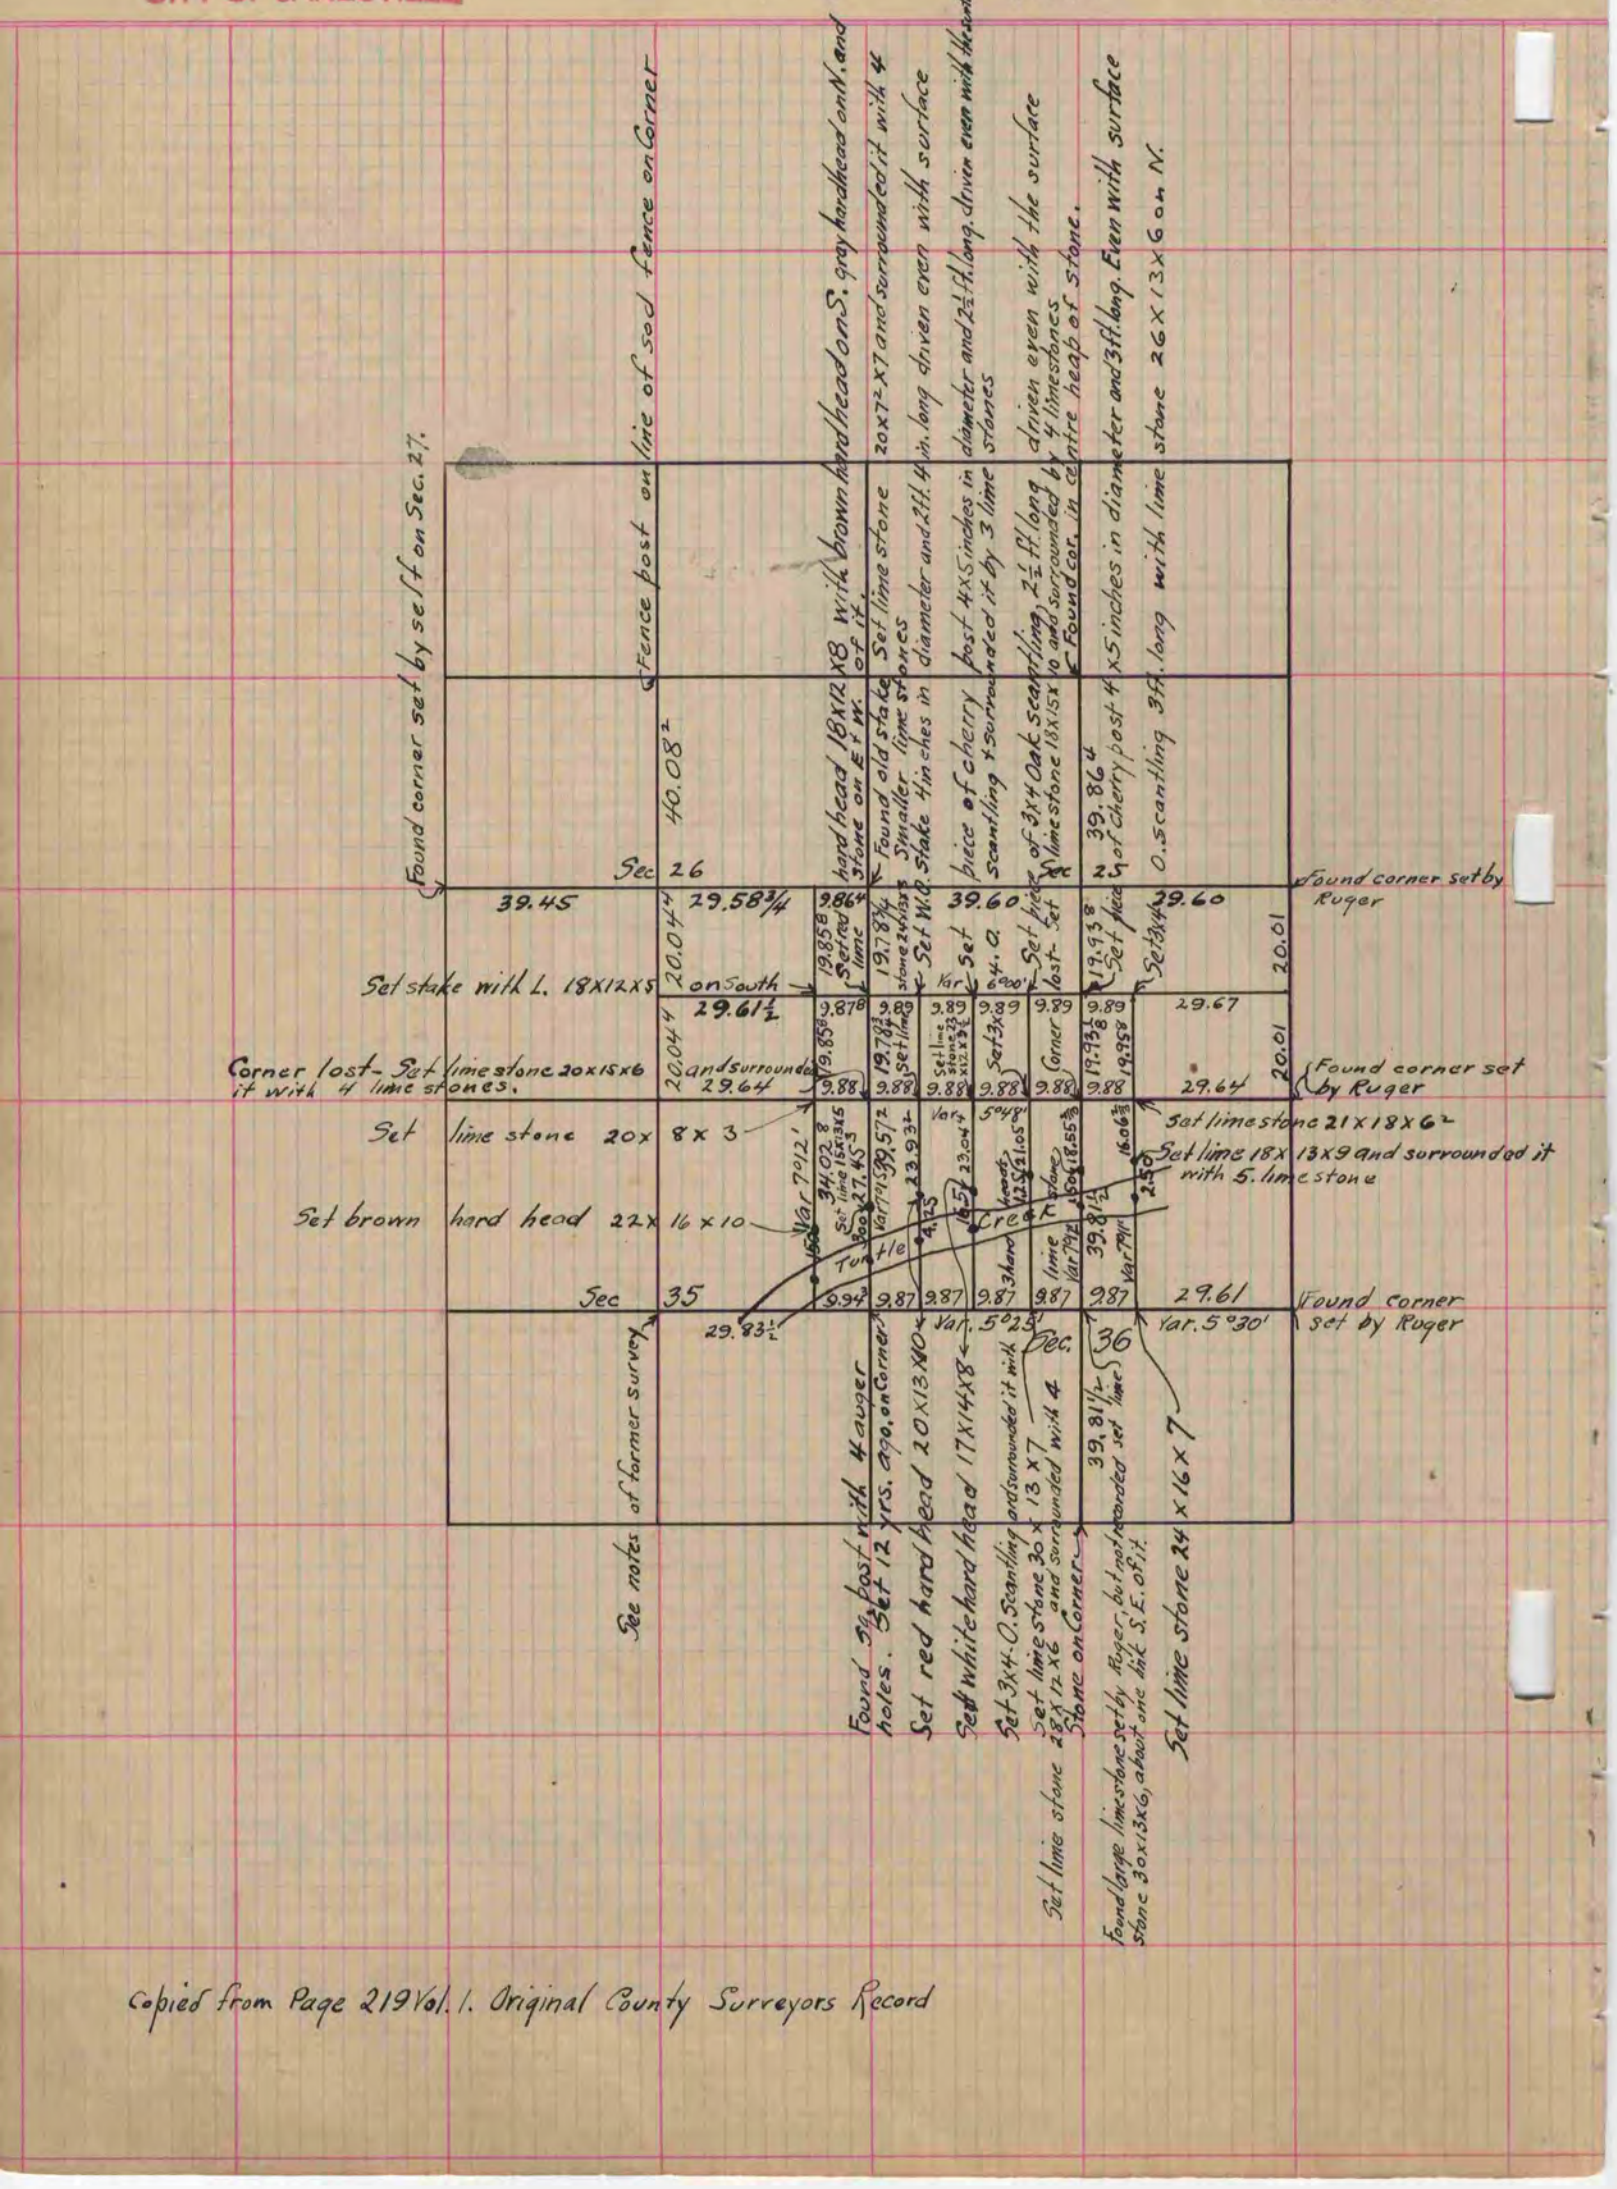

Copied from Page 219 Vol. 1. Original County Surveyors Record