PLAT AND RECORD

V-3 439
PG 419
BELOIT REC
12/16/75 DAB

BLOCK 6, Original Plat of Clinton

Of a Survey on Section 8 (S.E.¼) T ____ R ____ E. of the 4 P. M. in Clinton Township

Rock County, Wisconsin, made July the 8 1939

I hereby certify that the following is a correct record of said survey as made by me.

MICROFILMED
COUNTY BUILDING
CITY OF JANESVILLE
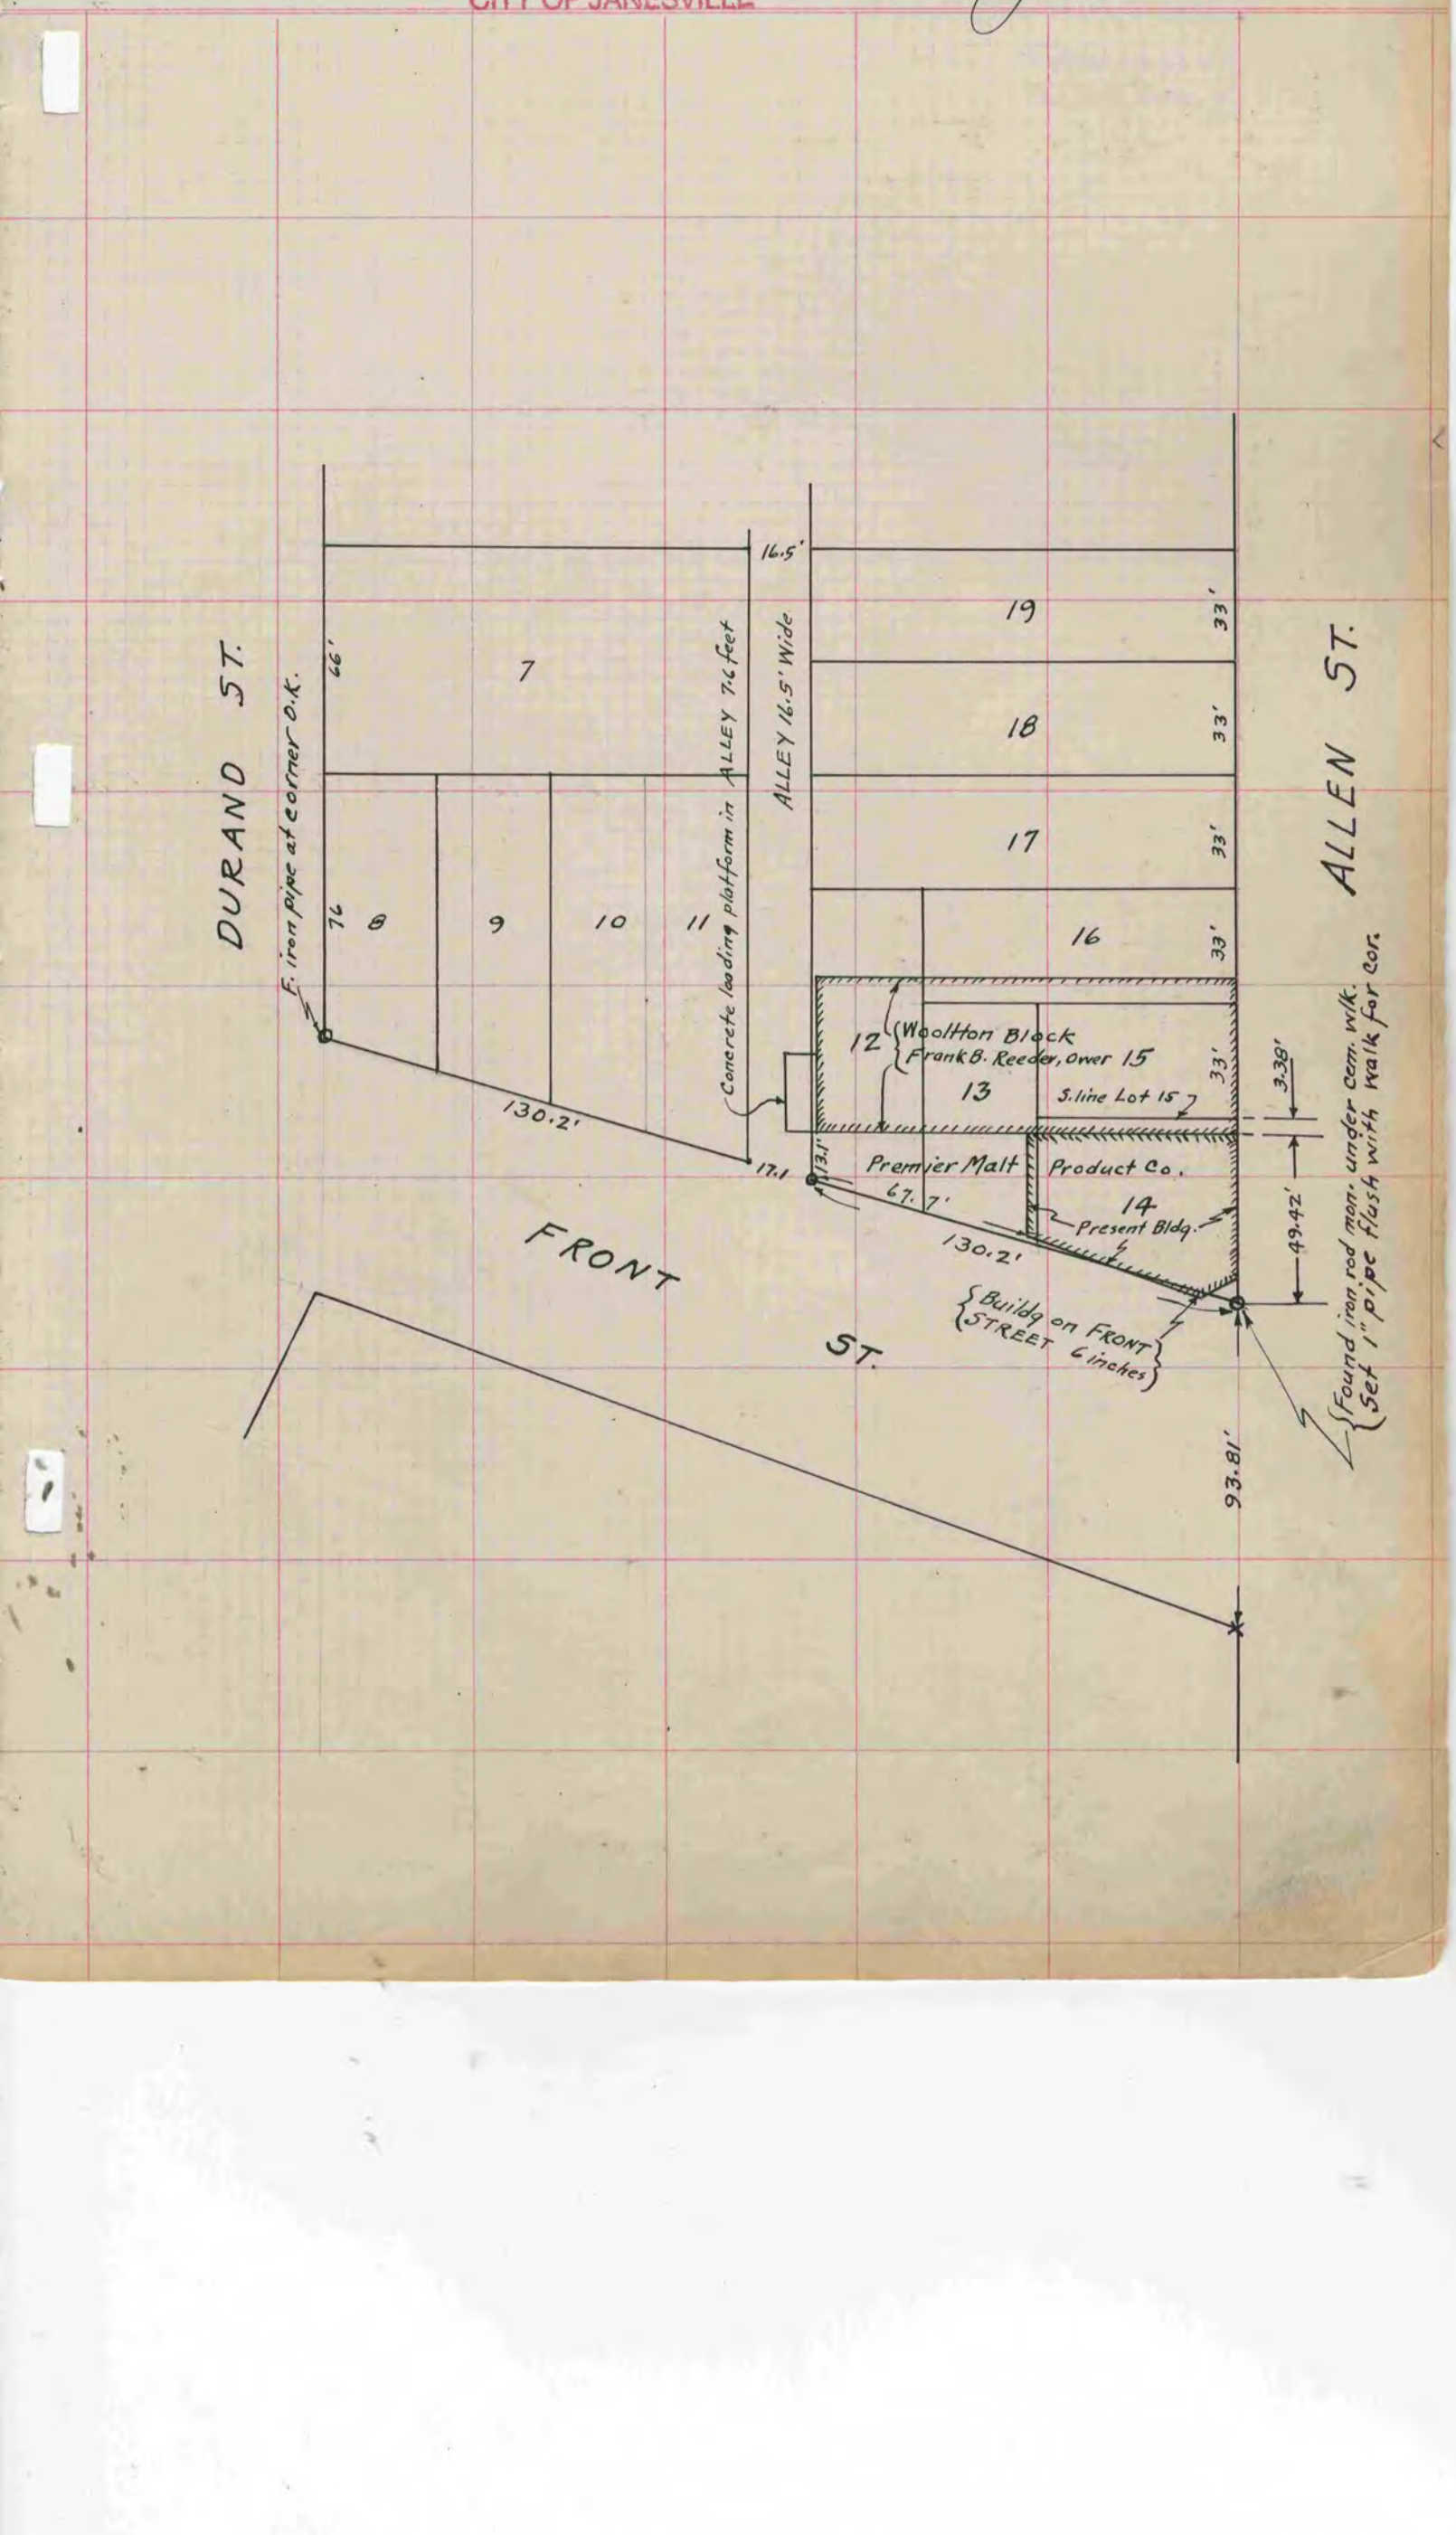
B. J. Bunny
County Surveyor.