528
V-3

PLAT AND RECORD

COUNTY BUILDING
CITY OF JANESVILLE

Of a Survey on Section 31 & 32 T 2N R 11 E. of the 4 P. M. in PLYMOUTH Township

Rock County, Wisconsin, made MARCH the 25th 1958

MICROFILMED

I hereby certify that the following is a correct record of said survey as made by me.
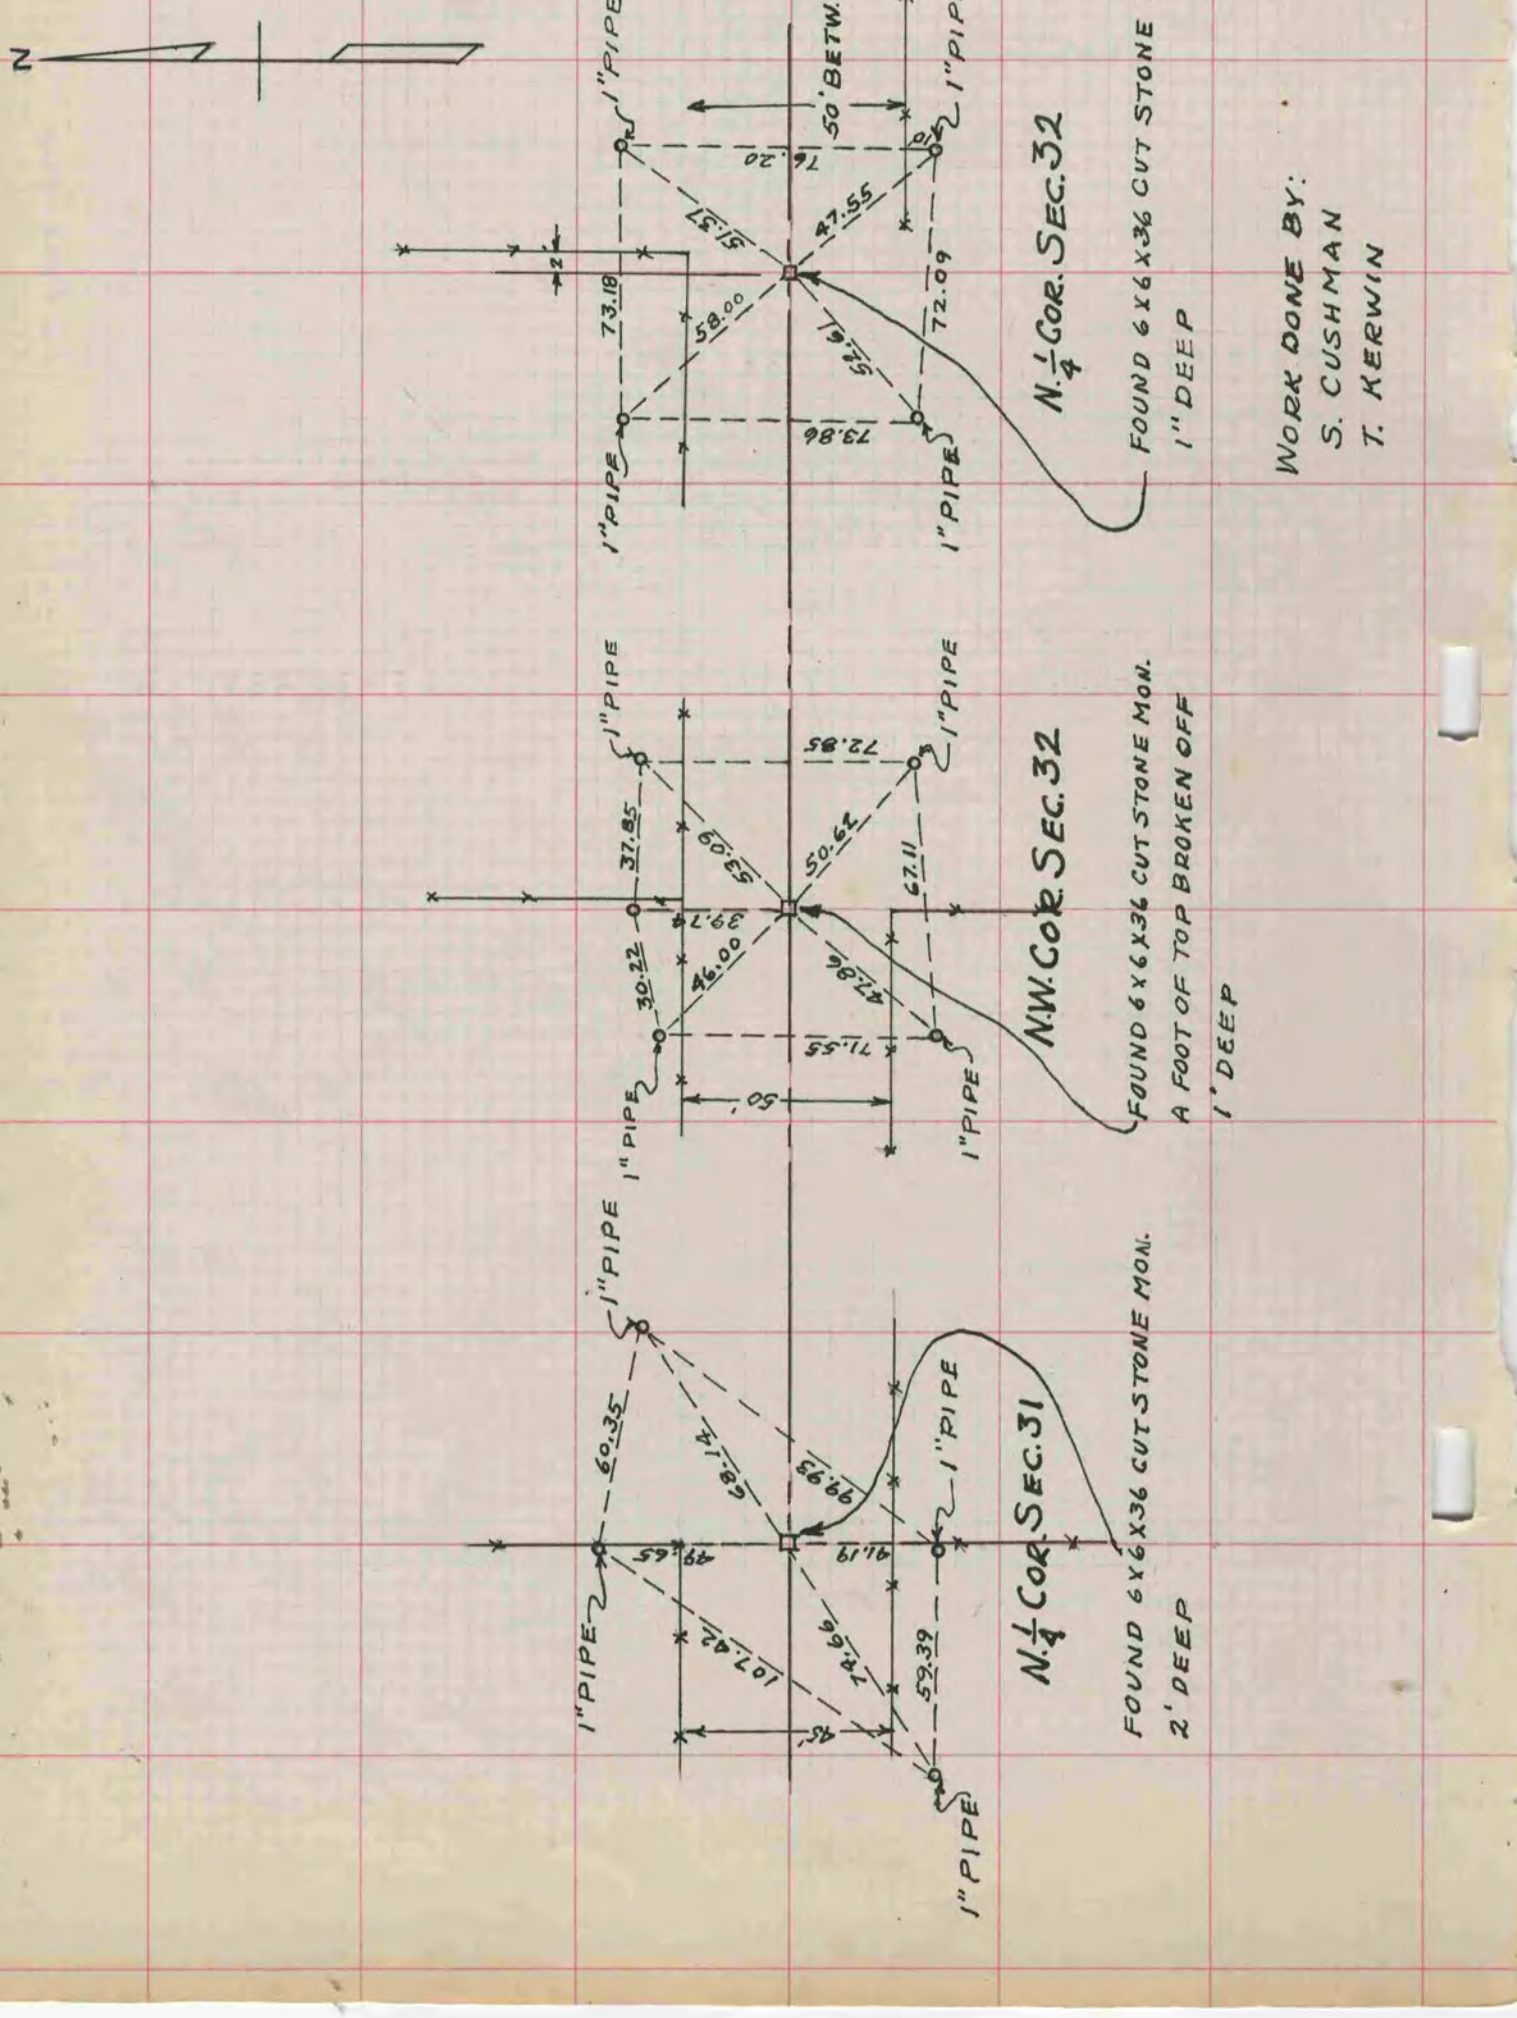
R. H. Batterman
County Surveyor.