MICROFILMED

PLAT AND RECORD

V-3 233
pg 226 BELOIT REC
12/15/75 DAB

Of a Survey on Section 27 T 4N. R 13 E. of the 4 P. M. in MILTON Township

Rock County, Wisconsin, made October the 30 & 31 1933.

I hereby certify that the following is a correct record of said survey as made by me.

COUNTY BUILDING
CITY OF JANESVILLE
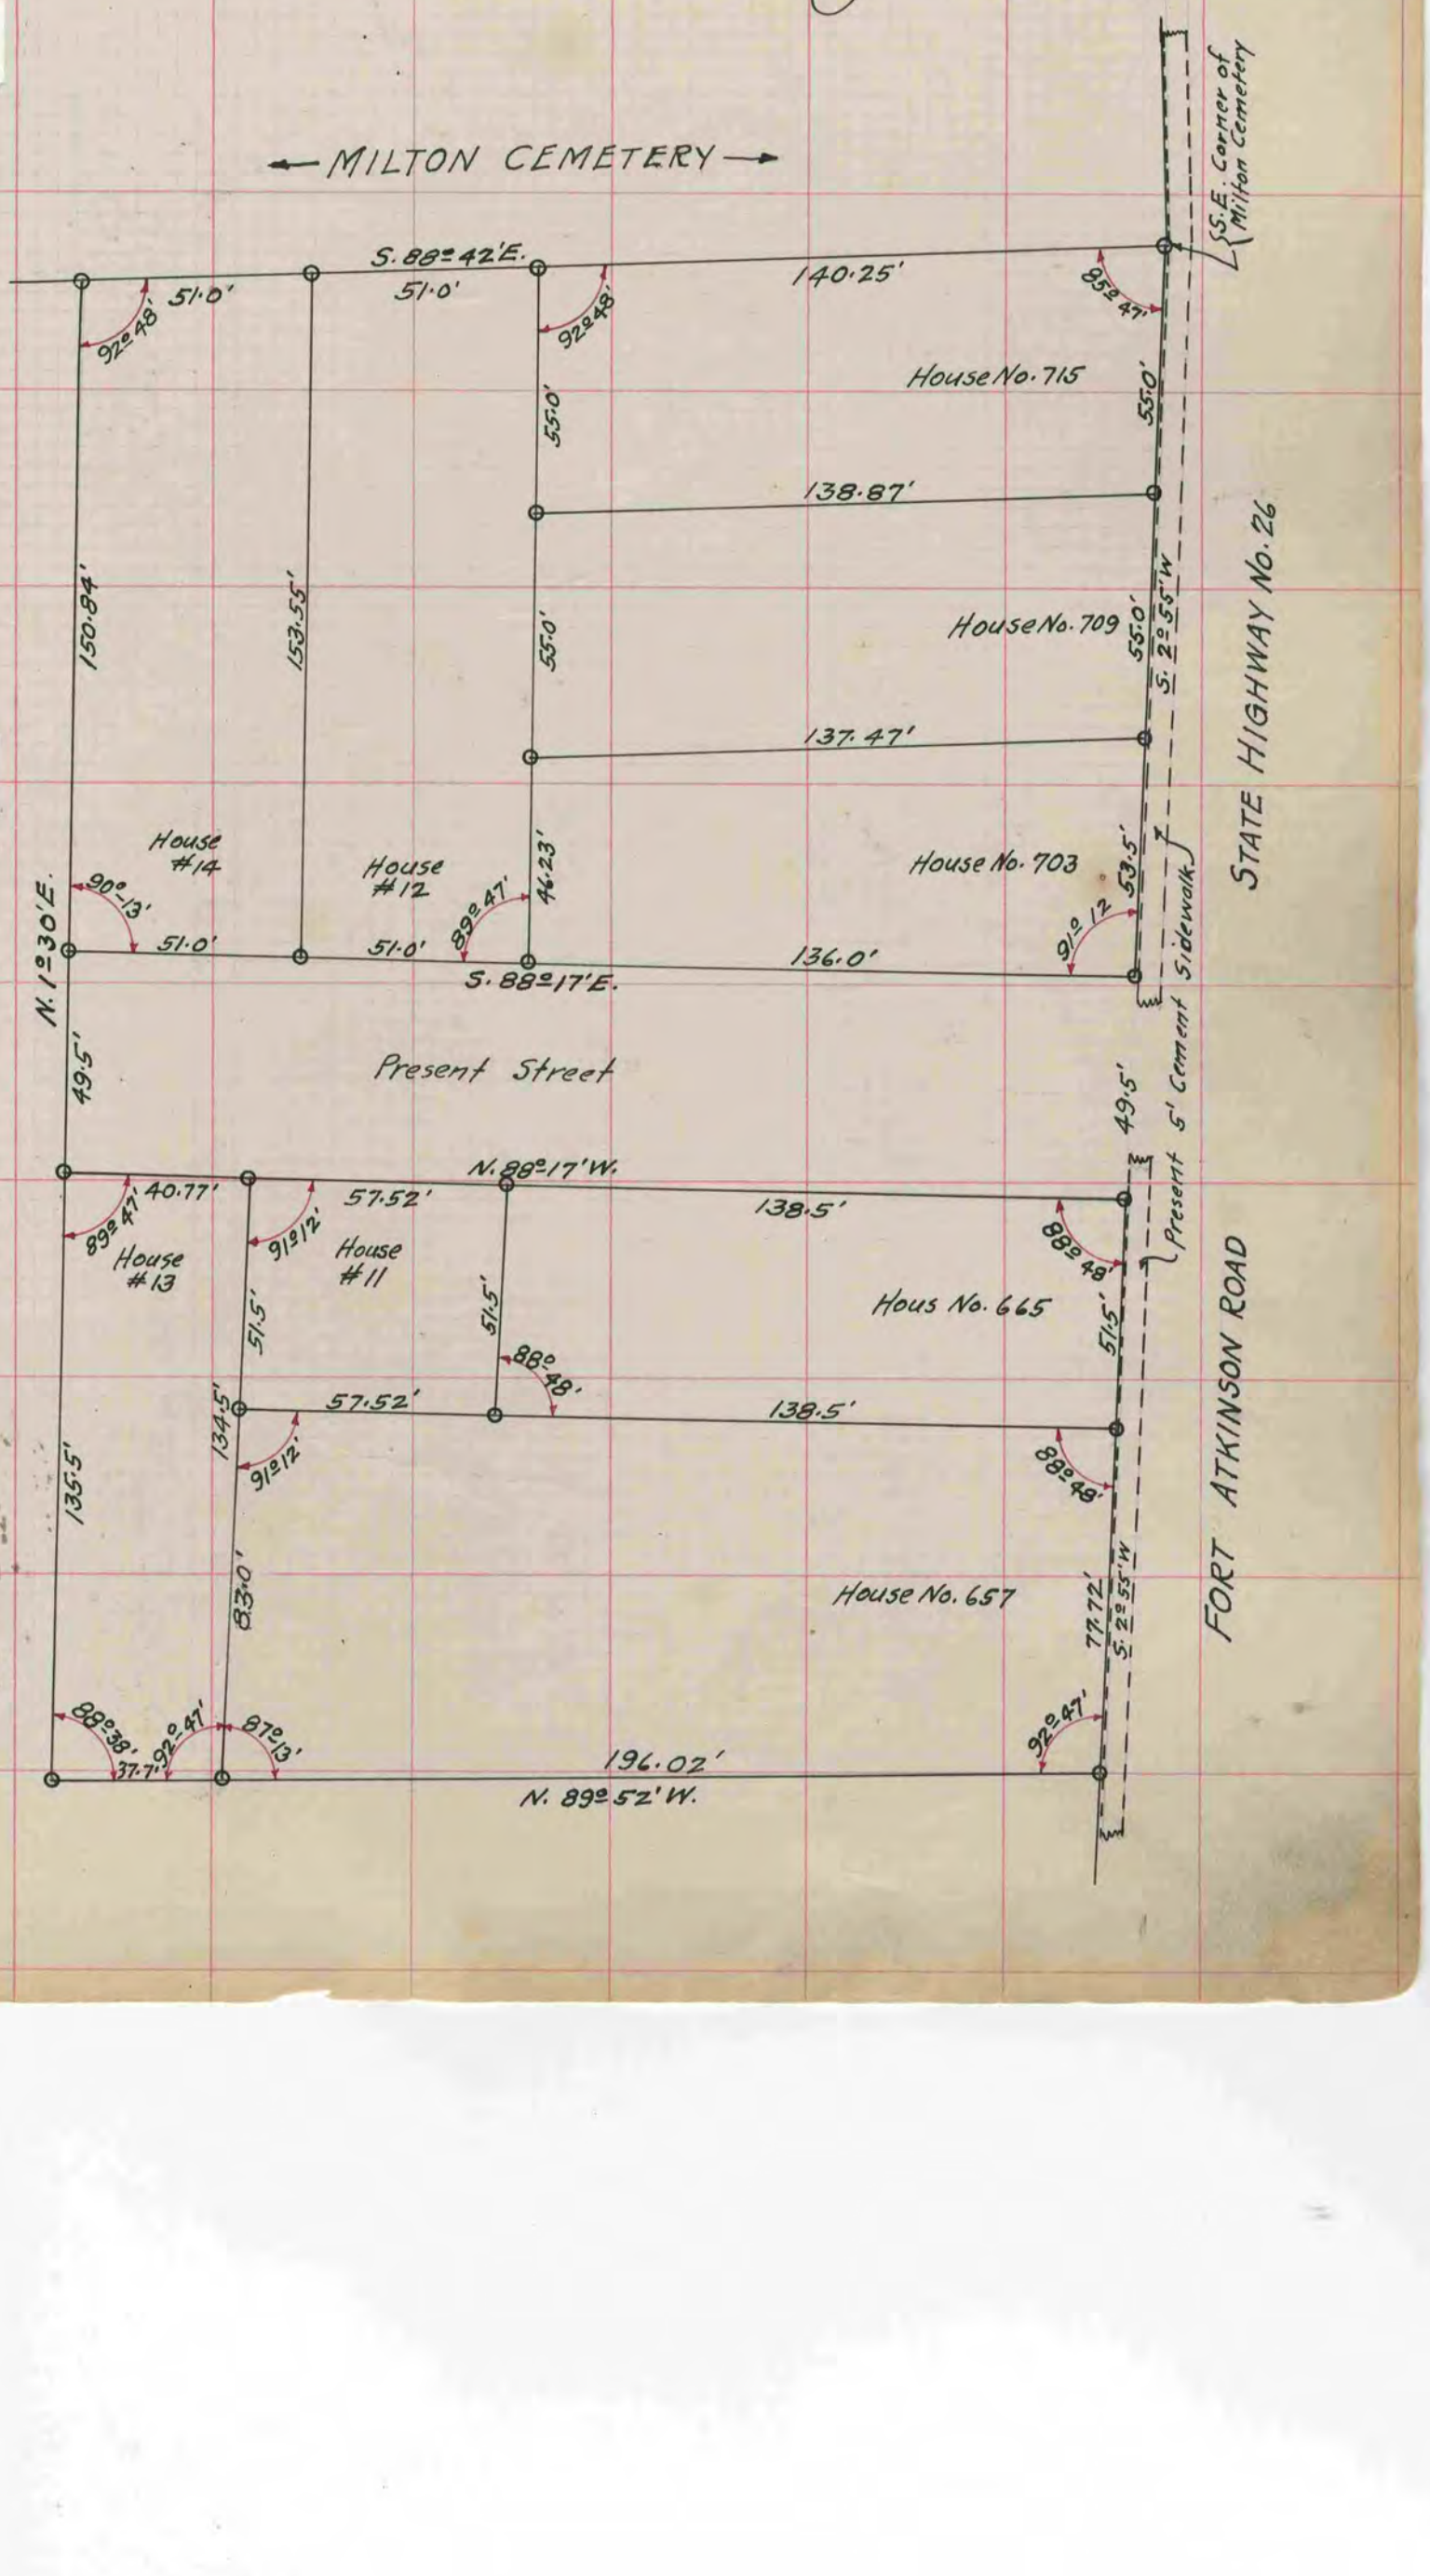
B. J. Bunny
County Surveyor.