MICROFILMED

PLAT AND RECORD

23
V-3

Of a Survey on Section 4 T 1 R 10 E. of the 4 P. M. in Avon Township

Rock County, Wisconsin, made December the 15th and 16 1905

I hereby certify that the following is a correct record of said survey as made by me.

COUNTY BUILDING
CITY OF JANESVILLE
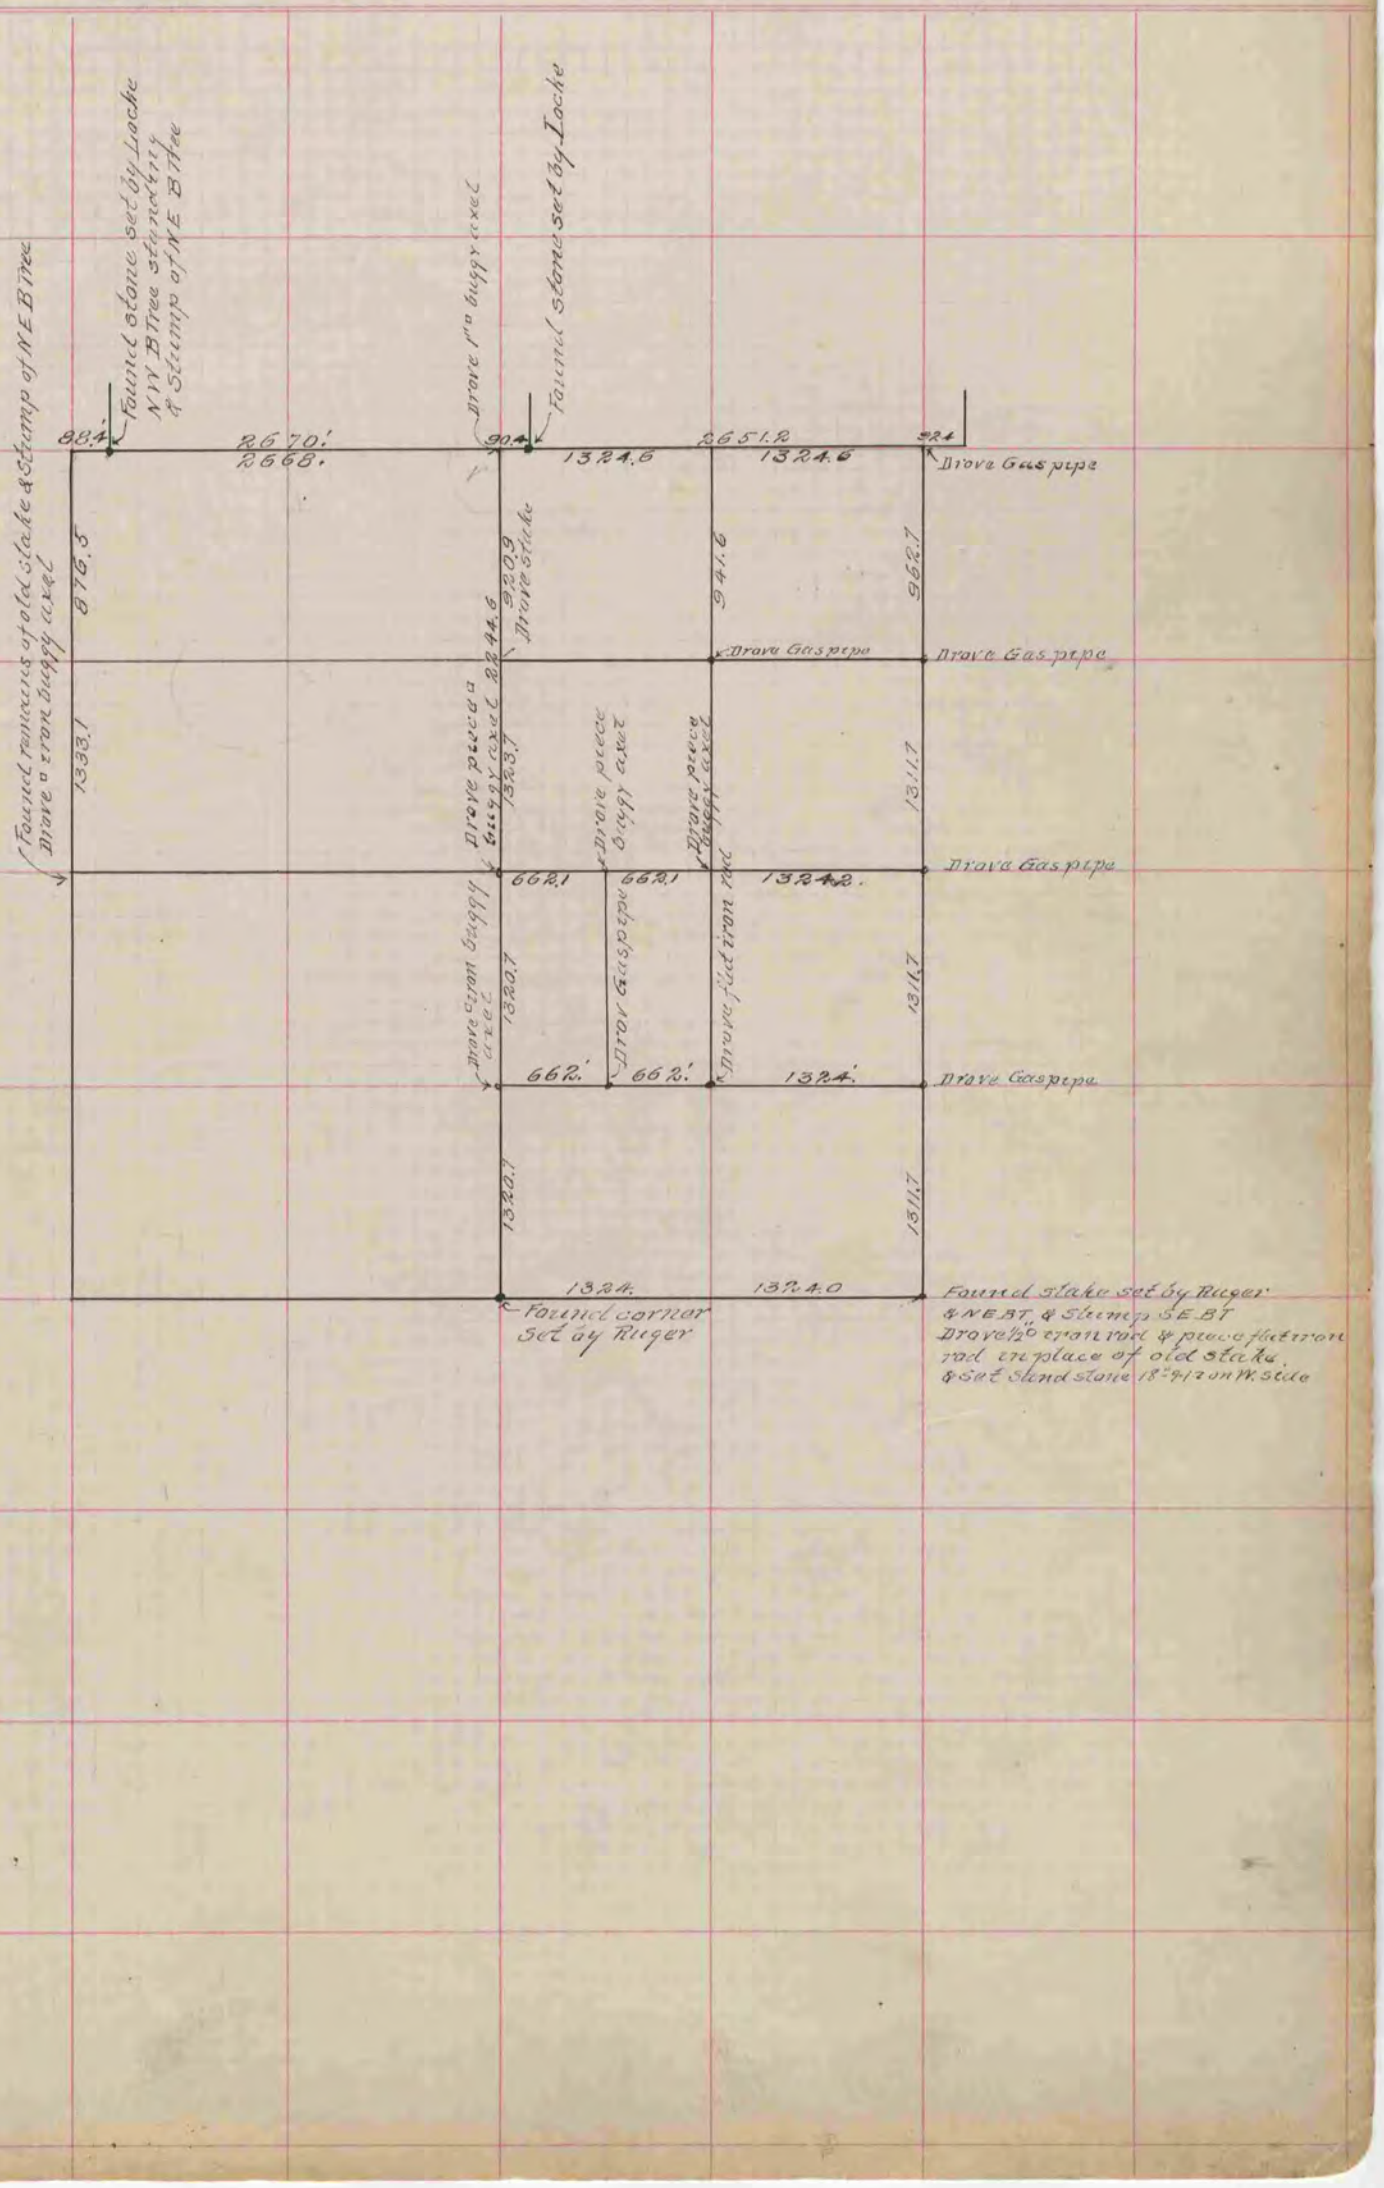
C. V. Kerch
County Surveyor.