399
VOL. 5

PLAT AND RECORD

Of a Survey on Section 14,24 3 R 12 E. of the 4 P. M. in JANESVILLE Township

Rock County, Wisconsin, made APRIL the 4 19 78

I hereby certify that the following is a correct record of said survey as made by me.

COUNTY BUILDING
CITY OF JANESVILLE

Donald Barnes County Surveyor.

THE GEO. D. BARNARD COMPANY, ST. LOUIS

SE CORNER SEC 14 T3N R12E

FOUND 2" IPO HH 0.5 DEEP

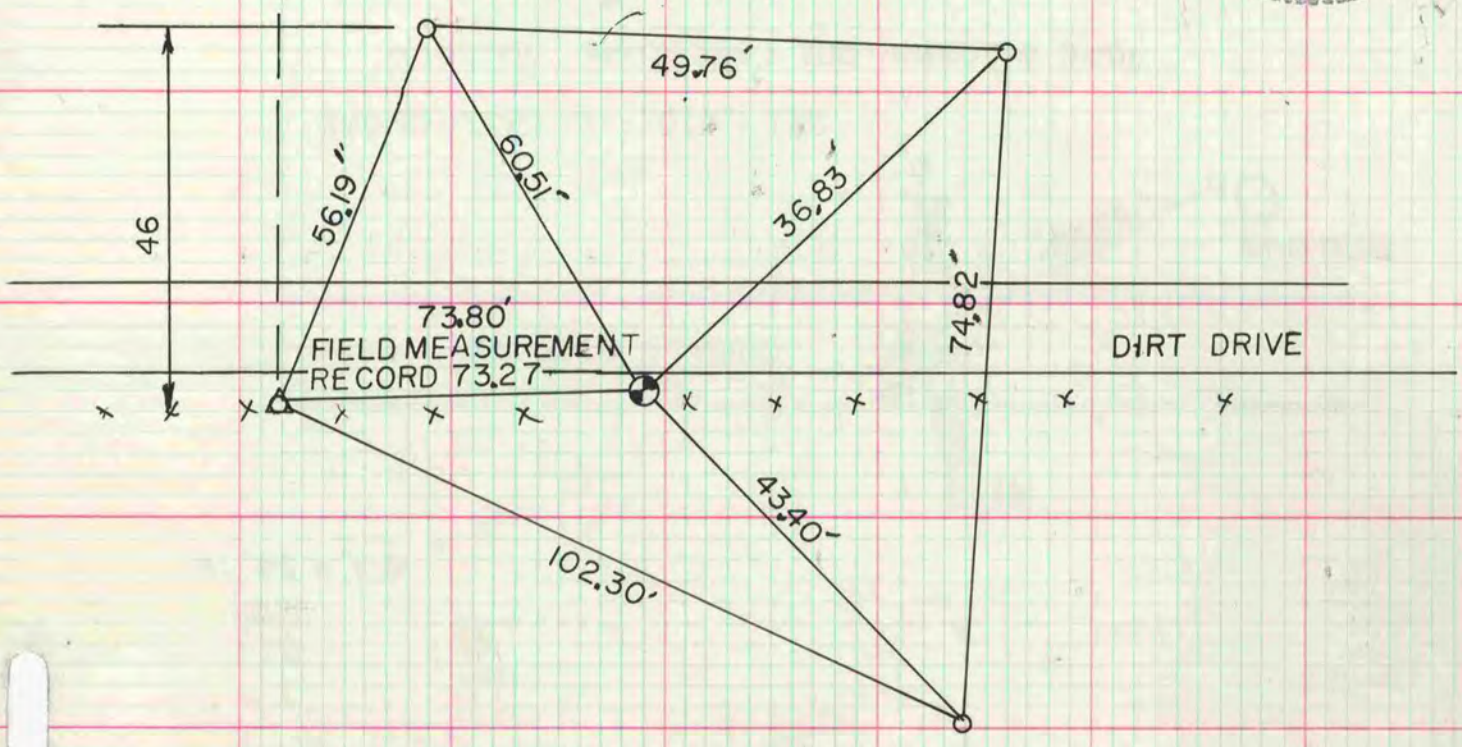

o 3/4" X 24" IP
△ FOUND 1" IP

MICROFILMED

W1/4 CORNER SEC 24 T3N R12E
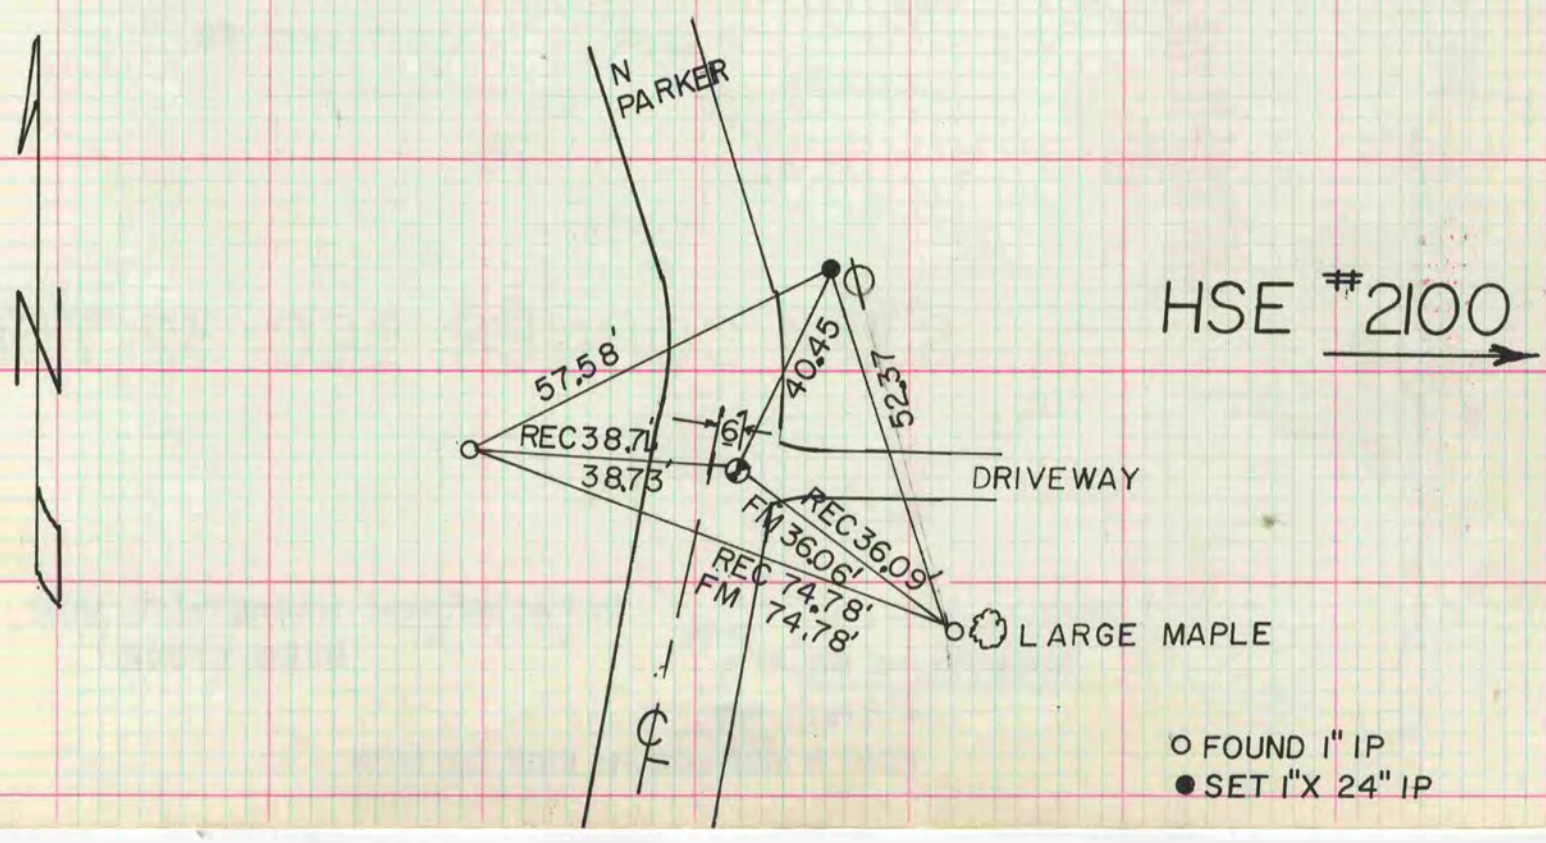
DUG & FOUND 1" X 18" IRON PIN & STONE OF RECORD UNDER PIN. SET ALUM MON OVER STONE.