143

PLAT AND RECORD

VOL. 6

Of a Survey on Section 31,32,33 4,5,6 T 1 R 12 E. of the 4TH P.M. ROCK BELOIT Township

Rock County, Wisconsin, made APRIL 7 the 1981

I hereby certify that the following is a correct record of said survey as made by me.

WISCONSIN DONALD A. BARNES S-1215 LAND SURVEYOR

COUNTY BUILDING
CITY OF JANESVILLE

Donald Barnes

County Surveyor.

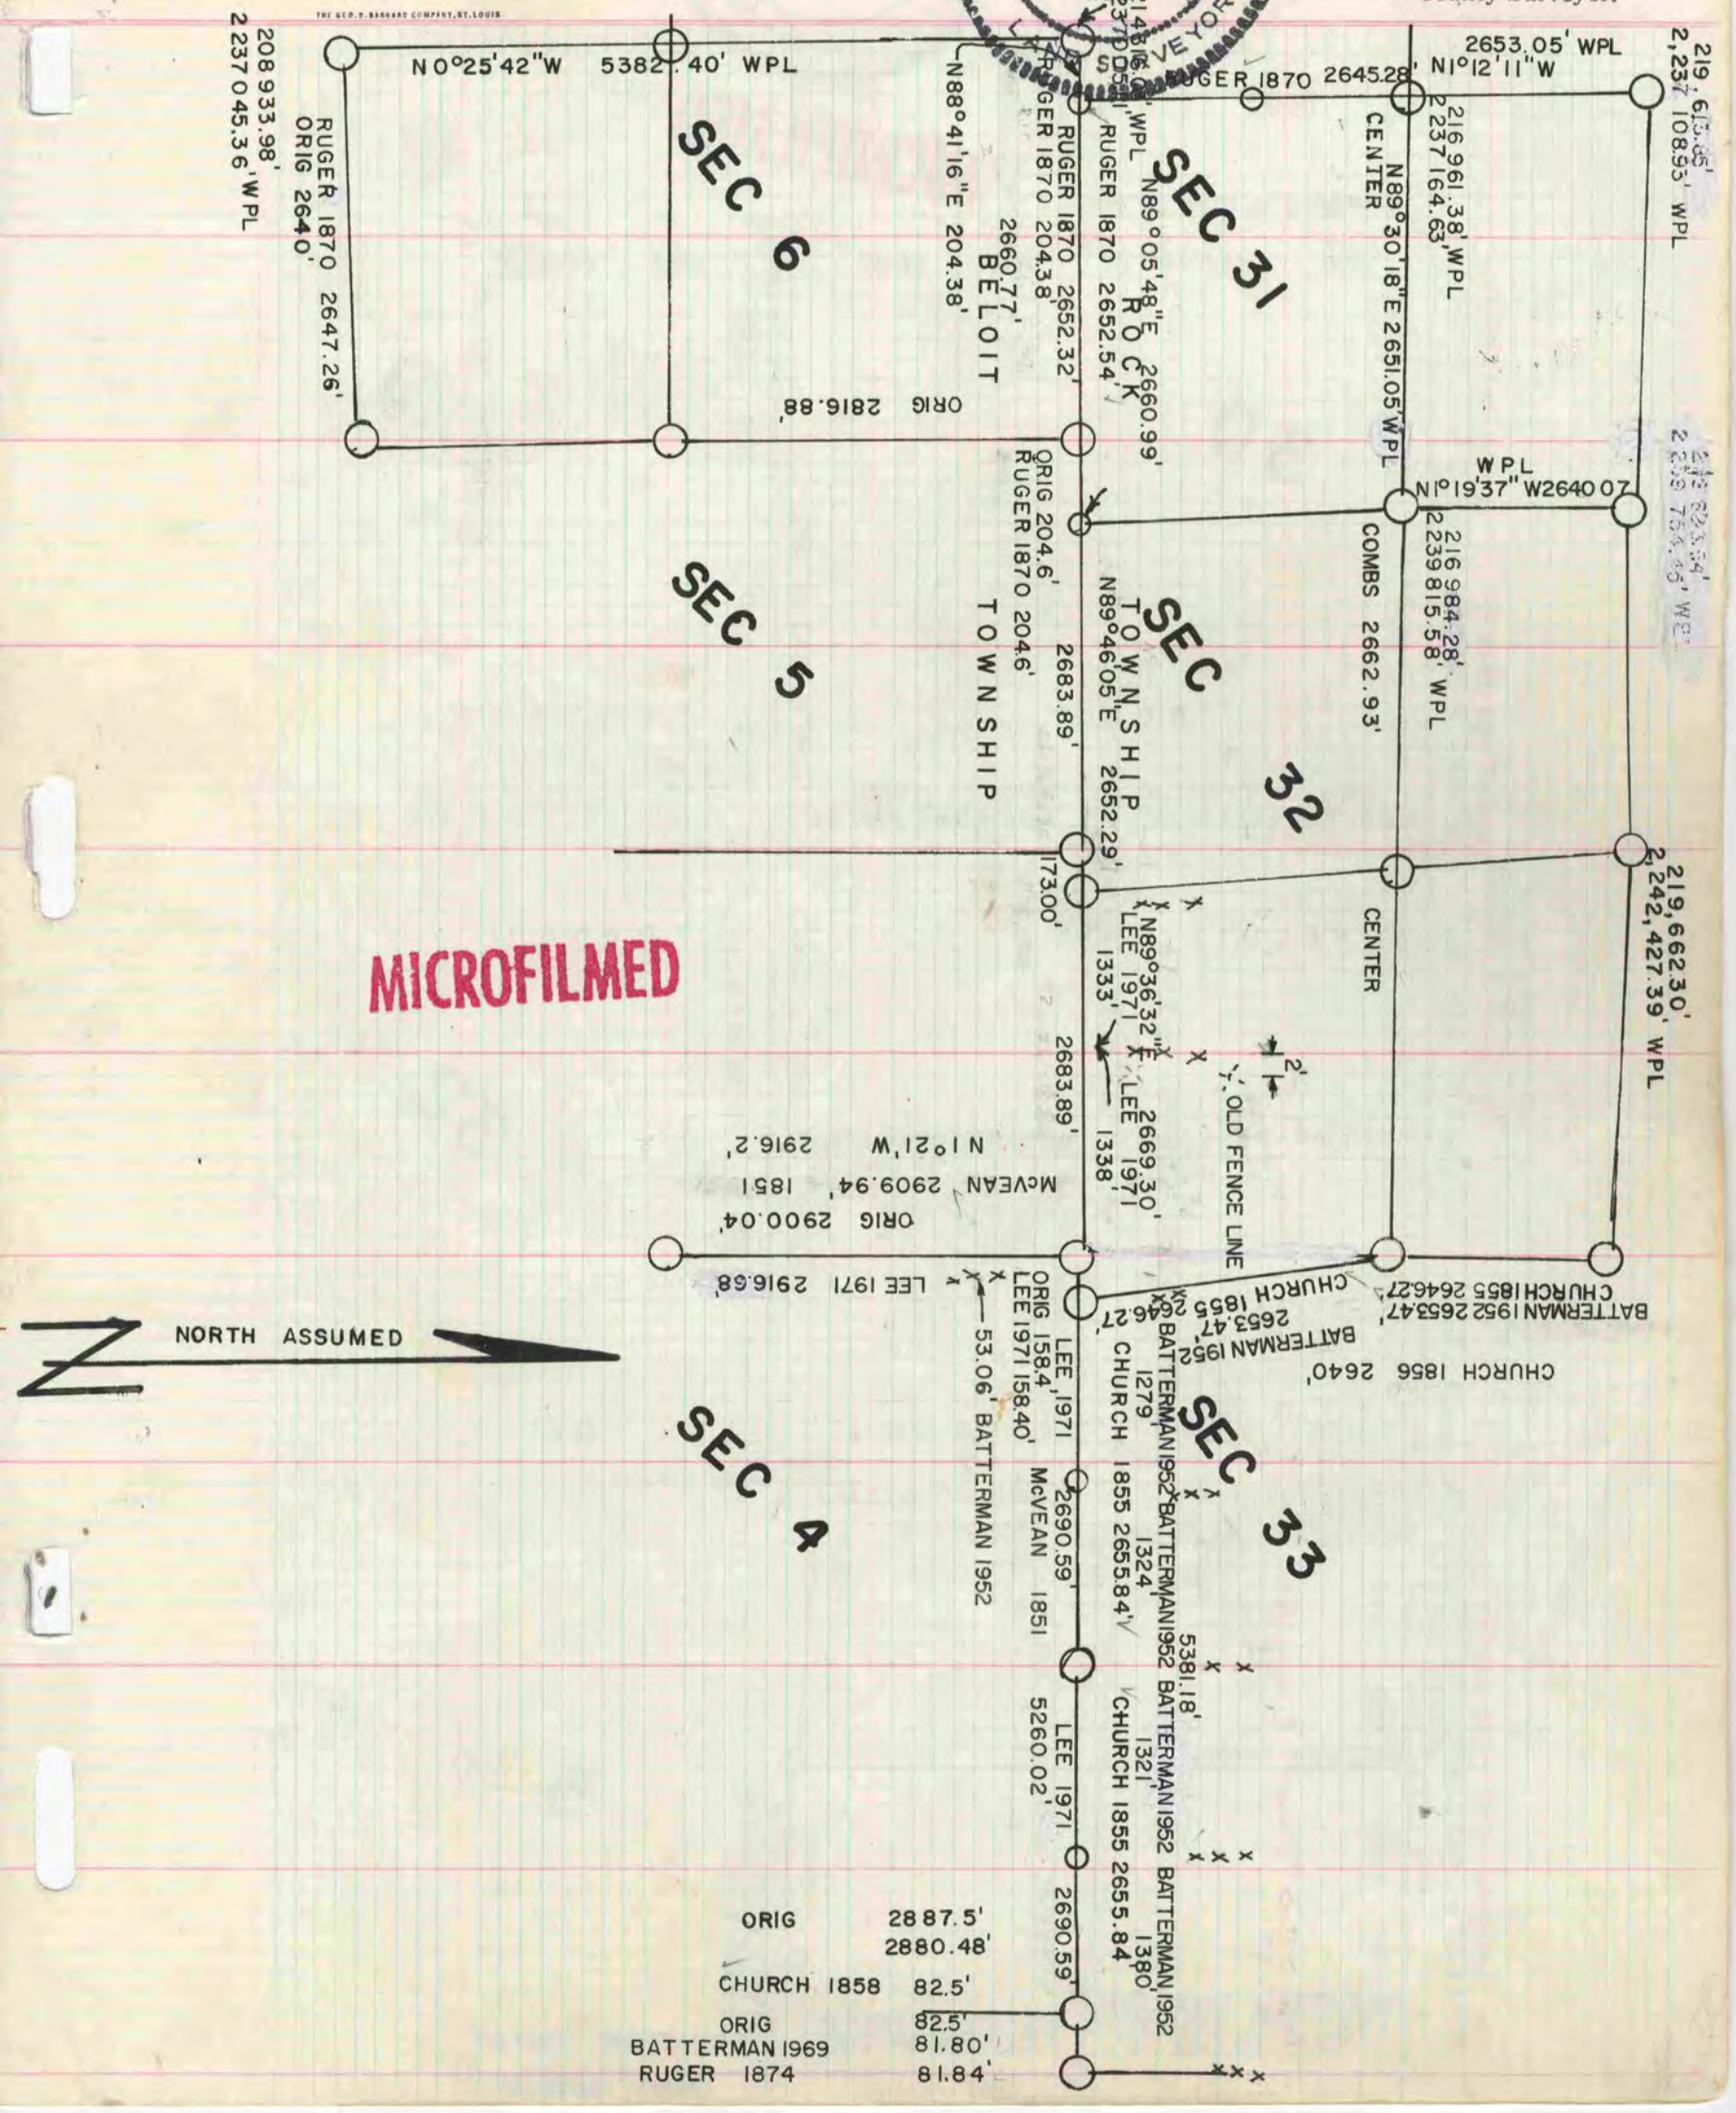

MICROFILMED