134
VOL. 6

PLAT AND RECORD

Of a Survey on Section 16, 21 T 3 R. 12 E. of the 4 P. M. in JANESVILLE Township

Rock County, Wisconsin, made ..... the 19 1847

I hereby certify that the following is a correct record of said survey as ~~made by me~~.

COUNTY BUILDING
CITY OF JANESVILLE

County Surveyor.

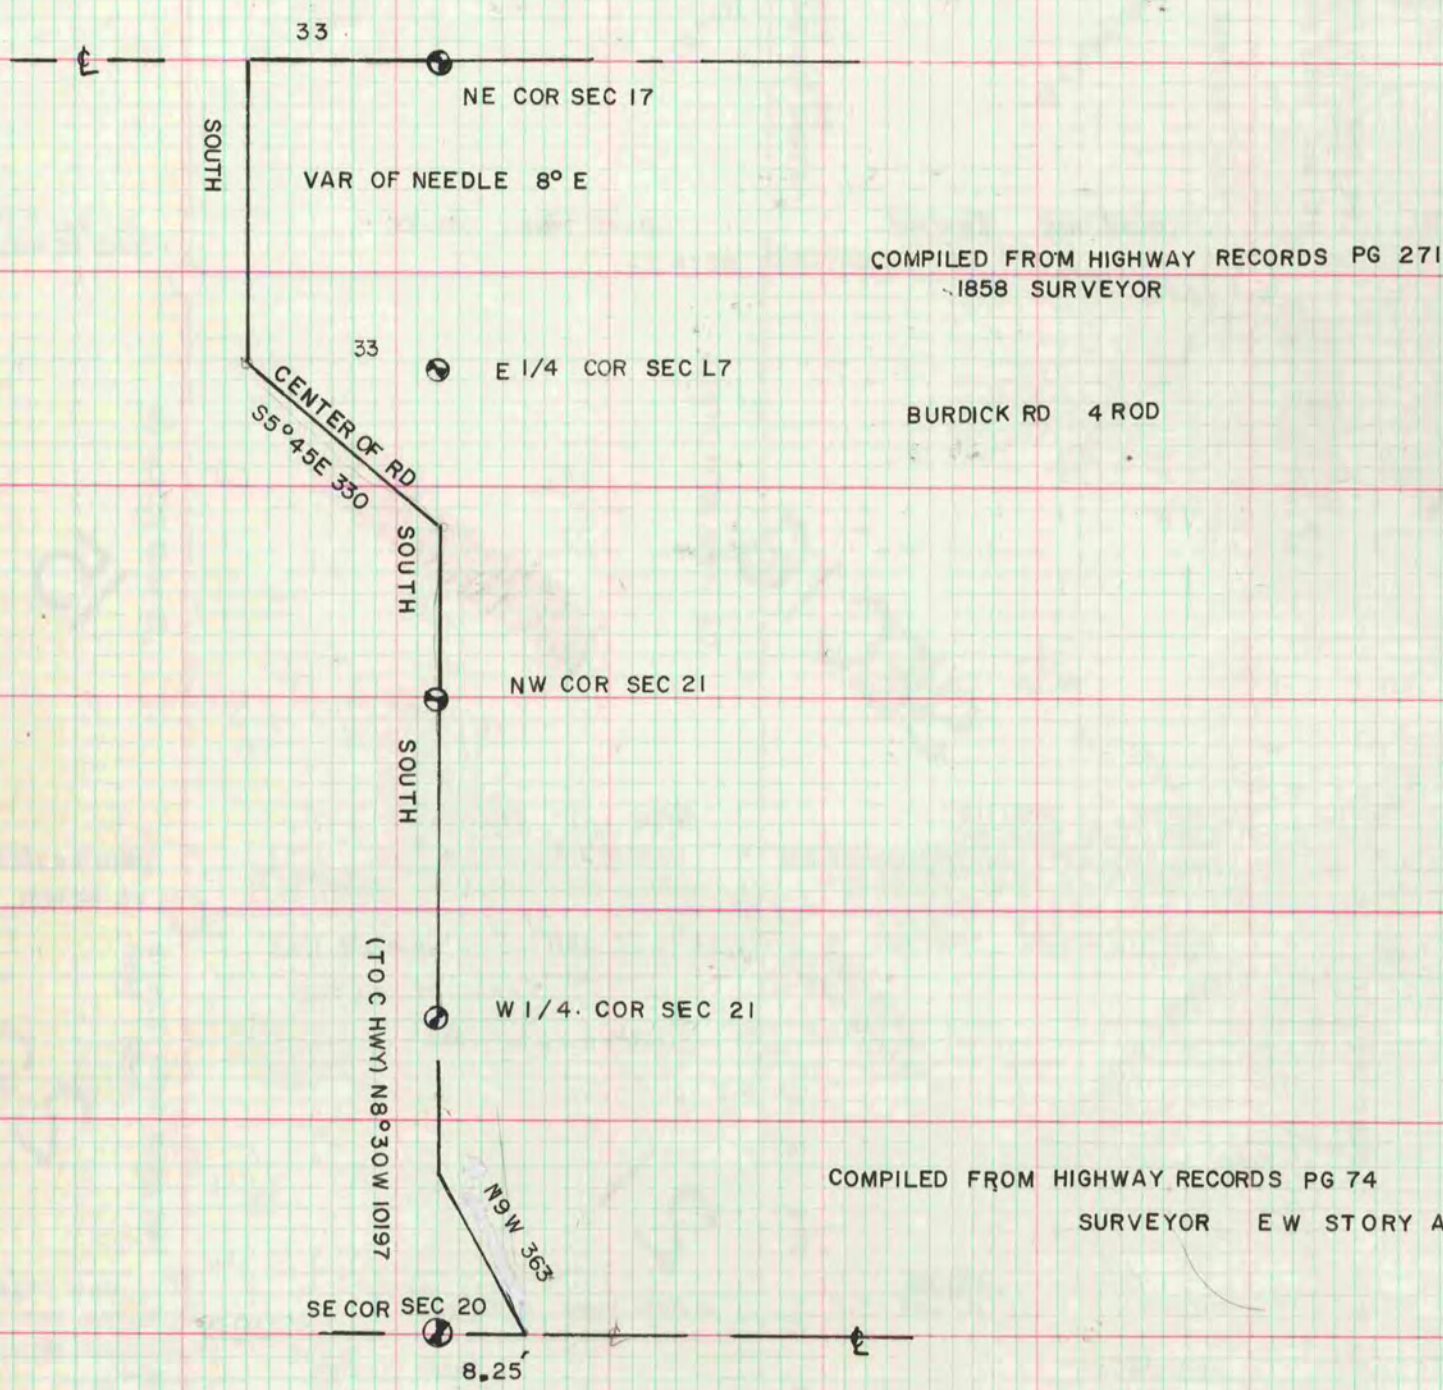

MICROFILMED