MICROFILMED

PLAT AND RECORD

37
V-3

Of a Survey on Section 23 T 1 R 12 E. of the 4 P. M. in Beloit Township

Rock County, Wisconsin, made April the 1919

I hereby certify that the following is a correct record of said survey as made by me.

COUNTY BUILDING
CITY OF JANESVILLE
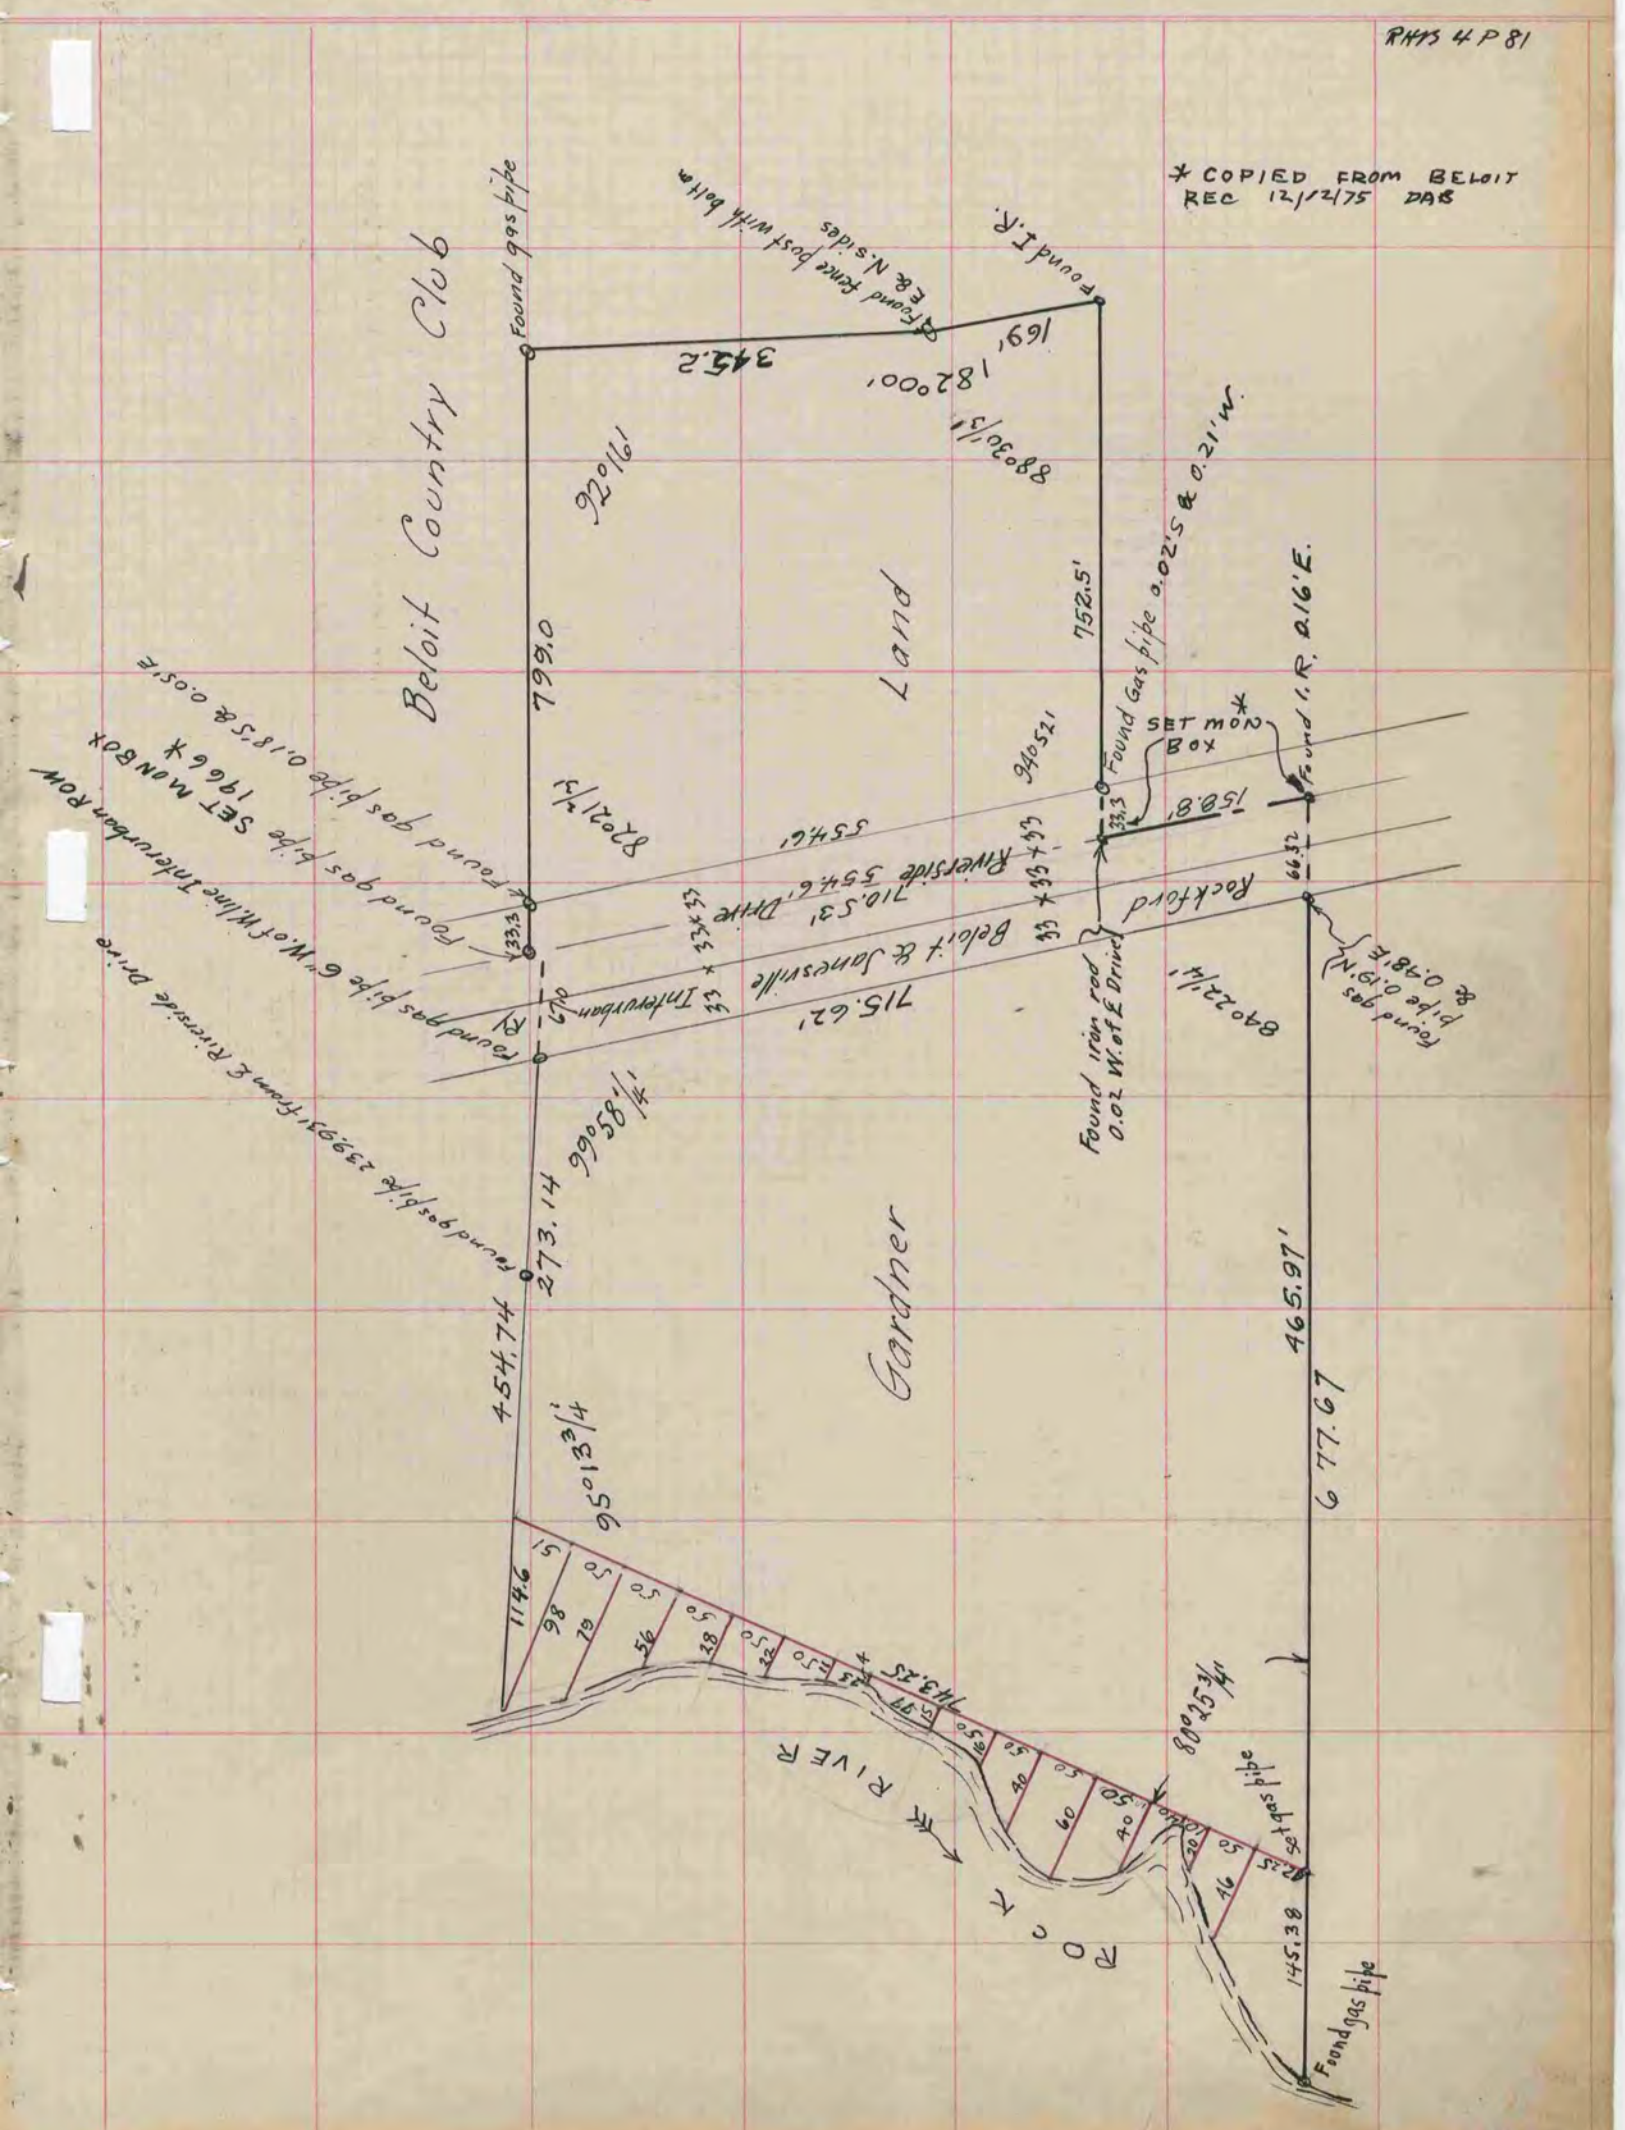
R. W. Batterman
County Surveyor.