MICROFILMED

# PLAT AND RECORD

V-3 189
PG 171 BELOIT REC
12/12/75 DAB

27,28,29,30

Of a Survey on Section 31,32,33,34 T 1 R 12 E. of the 4 P. M. in Beloit Township

Rock County, Wisconsin, made November the 12 to 16, 1931

I hereby certify that the following is a correct record of said survey as made by me.

COUNTY BUILDING
CITY OF JANESVILLE

B. J. Bunny
County Surveyor.

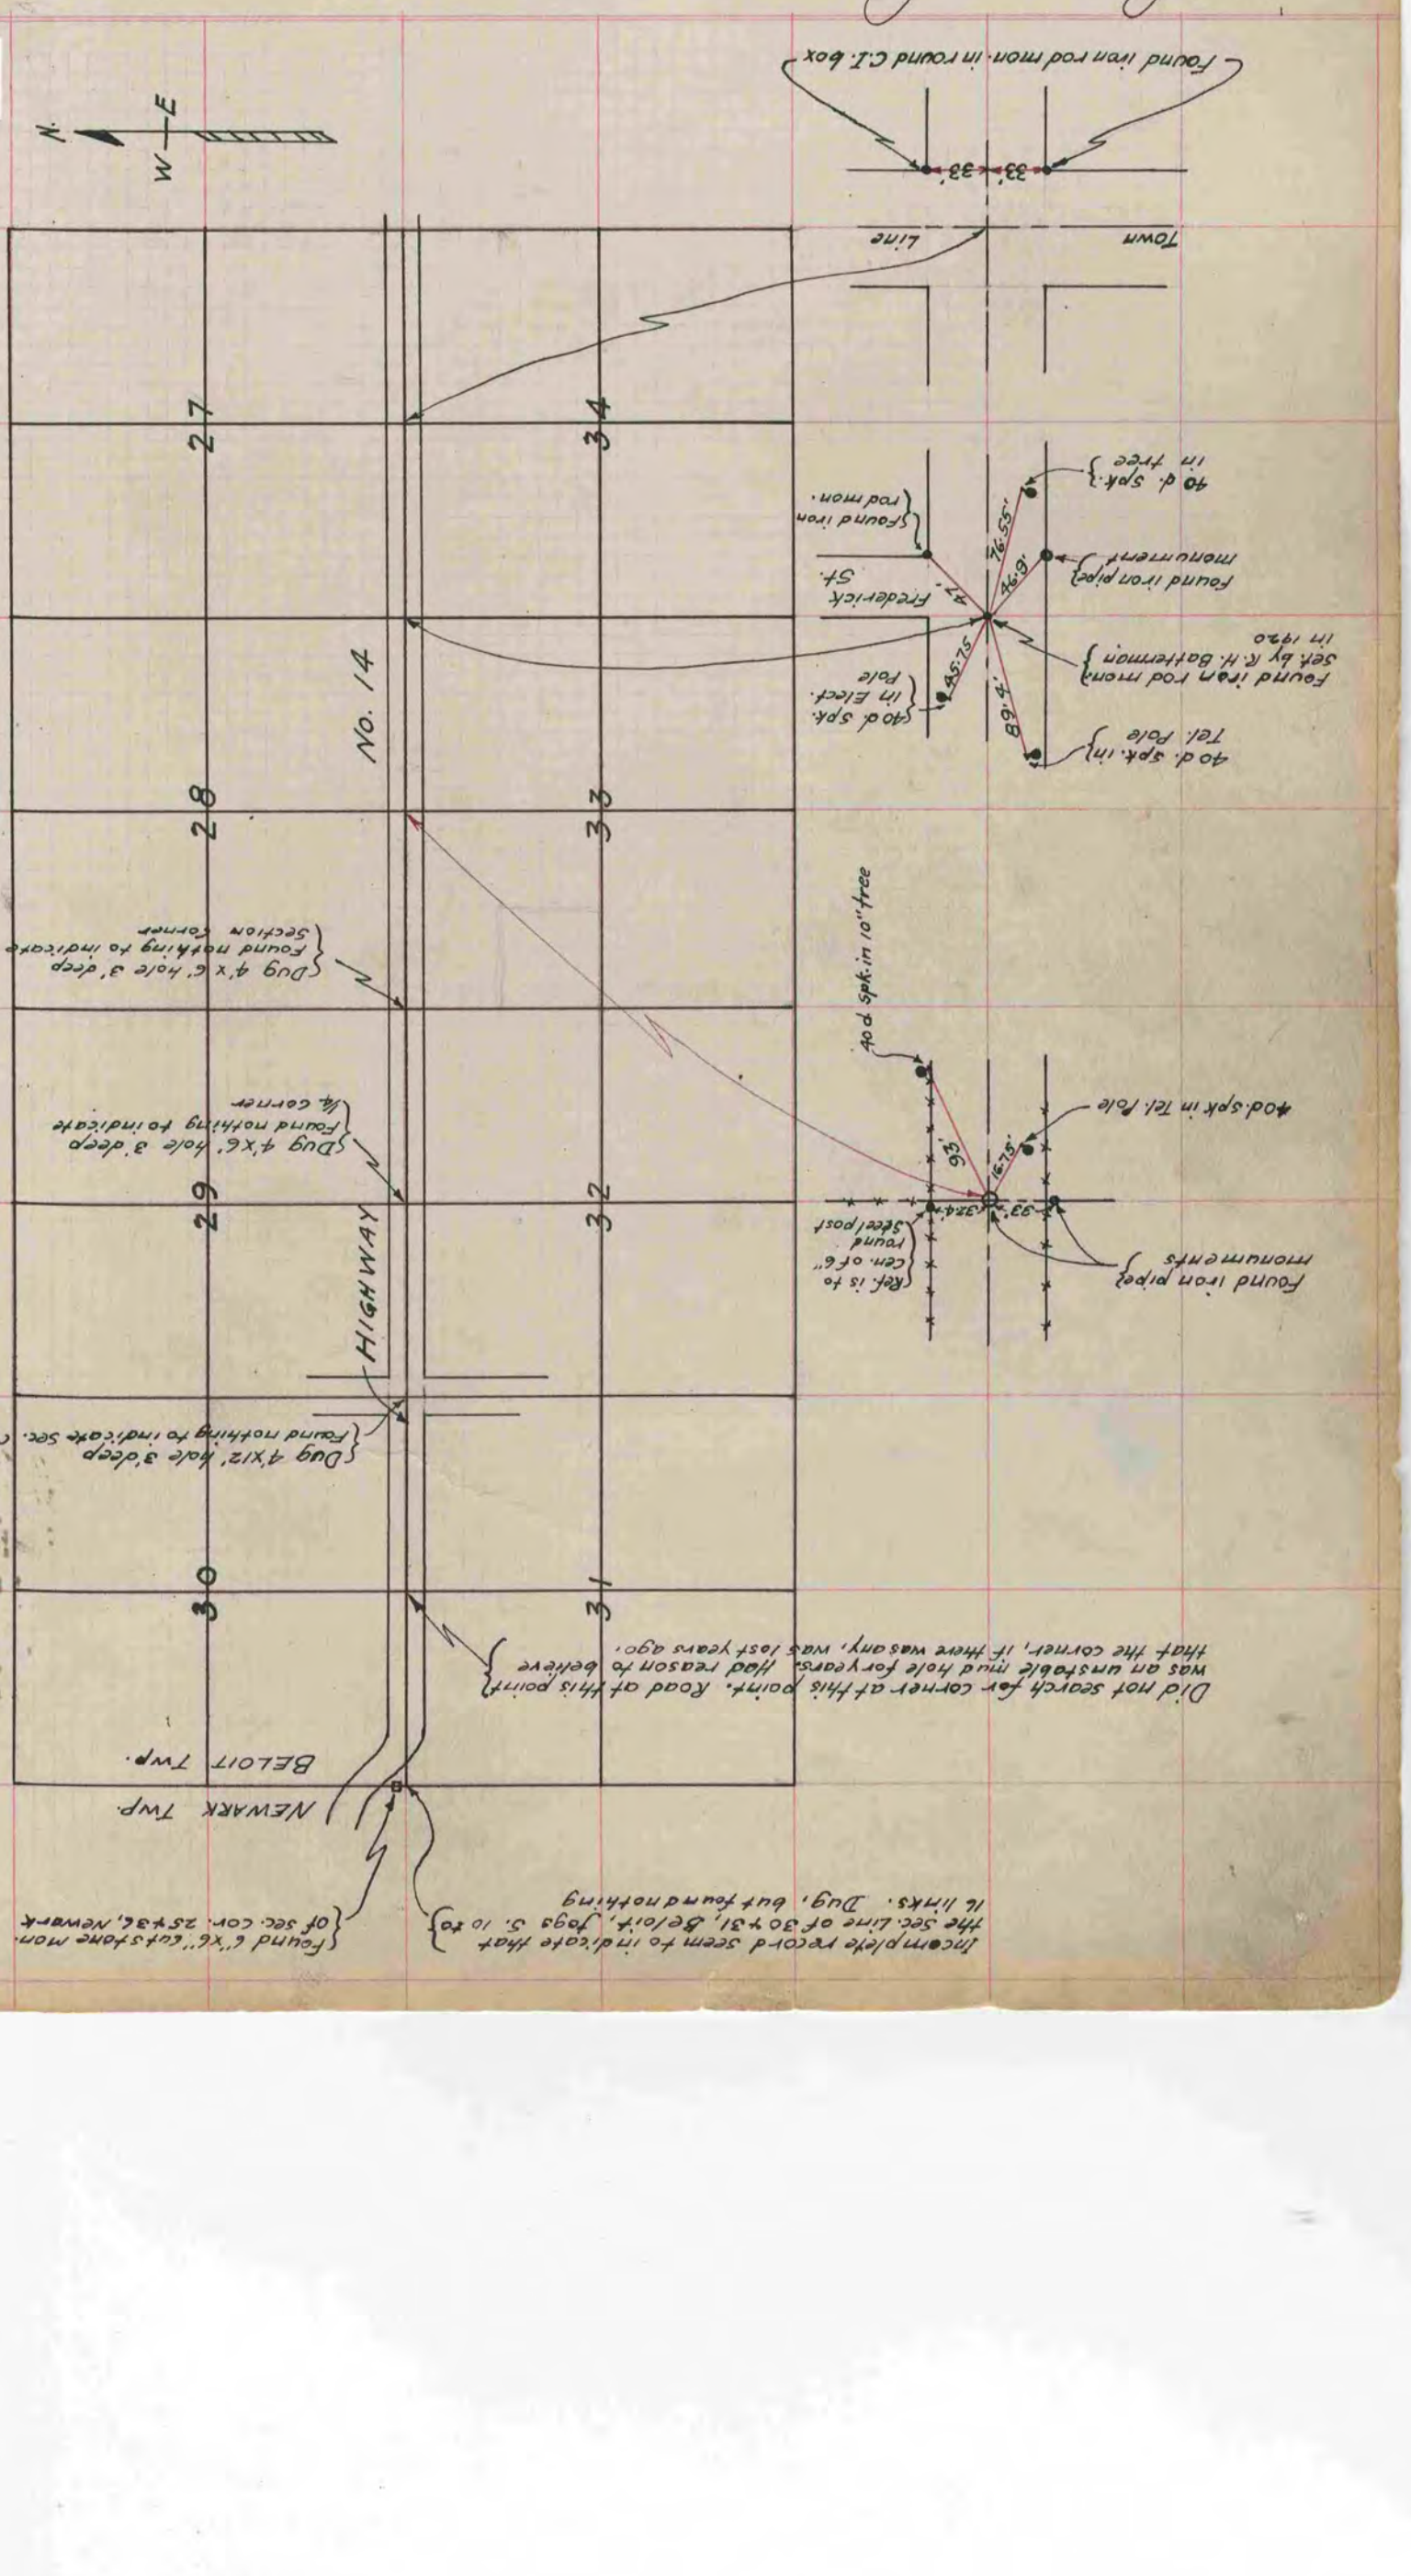


Did not search for corner at this point. Road at this point was an unstable mud hole for years. Had reason to believe that the corner, if there was any, was lost years ago.

Incomplete record seem to indicate that the sec. line of 30+31, Beloit, pogs 5. 10 to le links. Dug, but found nothing

NEWARK Twp.

BELOIT Twp.