MICROFILMED

COUNTY BUILDING
CITY OF JANESVILLE

77
V-1

PLAT AND RECORD

Of a Survey on Section 22 T 4 R 12 E. of the 4 P. M. in Fulton Township

Rock County, Wisconsin, made February the 3rd 1858

I hereby certify that the following is a correct record of said survey as made by me.

(Signed) Joseph Church
R.H.B. County Surveyor.

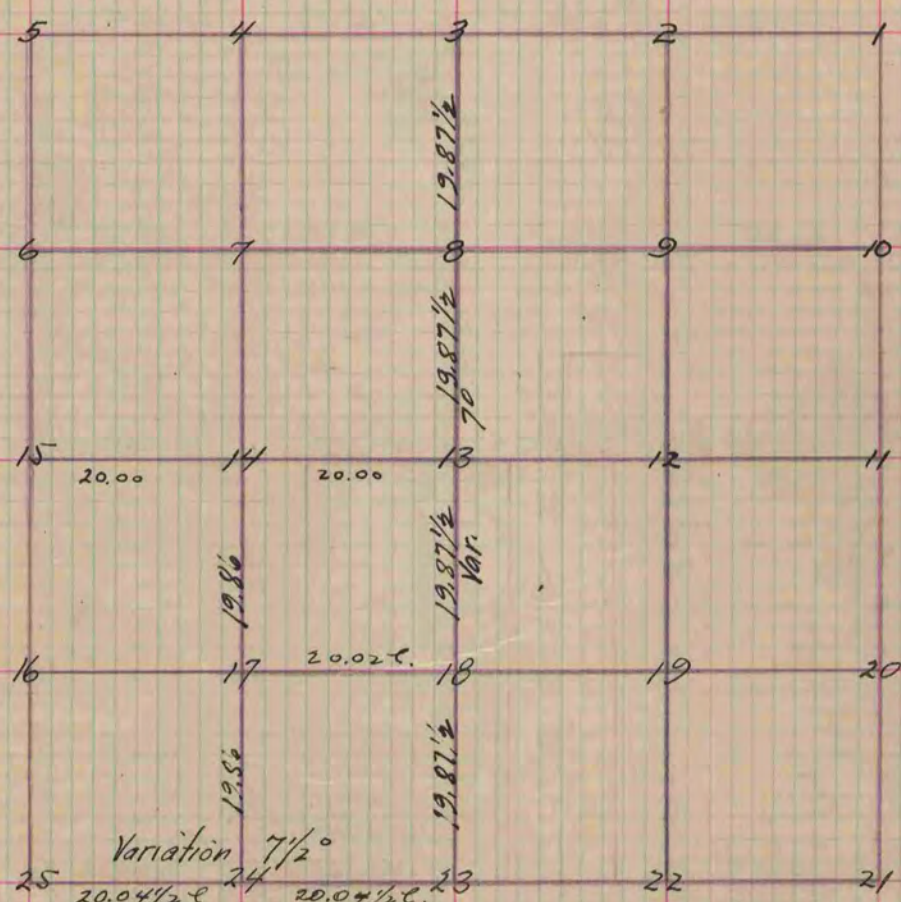

Fig 13 Br.O. 20 N 56½ E 37 links
" " 12 N 39 E 25 "
" 8 " 18 N 39½ W. 27 "
" 24 " 8 S 58 W 28 "
Hickory 8 N. 5 E 37 "
" 17 Br.O. 12 S. 14 E 87 "
" " 12 S. 85 W. 56 "
" 18 Hickory 6 N. 44½ E. 11 "
Br.O. 10 S 3 E 9 "

Copied from Page 78 Vol. 1. Original County Surveyors Record