13
V-4

# PLAT AND RECORD

COUNTY BUILDING
CITY OF JANESVILLE

Of a Survey on Section 19 T 4N R 12 E. of the 4 P. M. in FULTON Township

Rock County, Wisconsin, made JANUARY the 27th 1960

I hereby certify that the following is a correct record of said survey as made by me.

R H Battleman
County Surveyor.
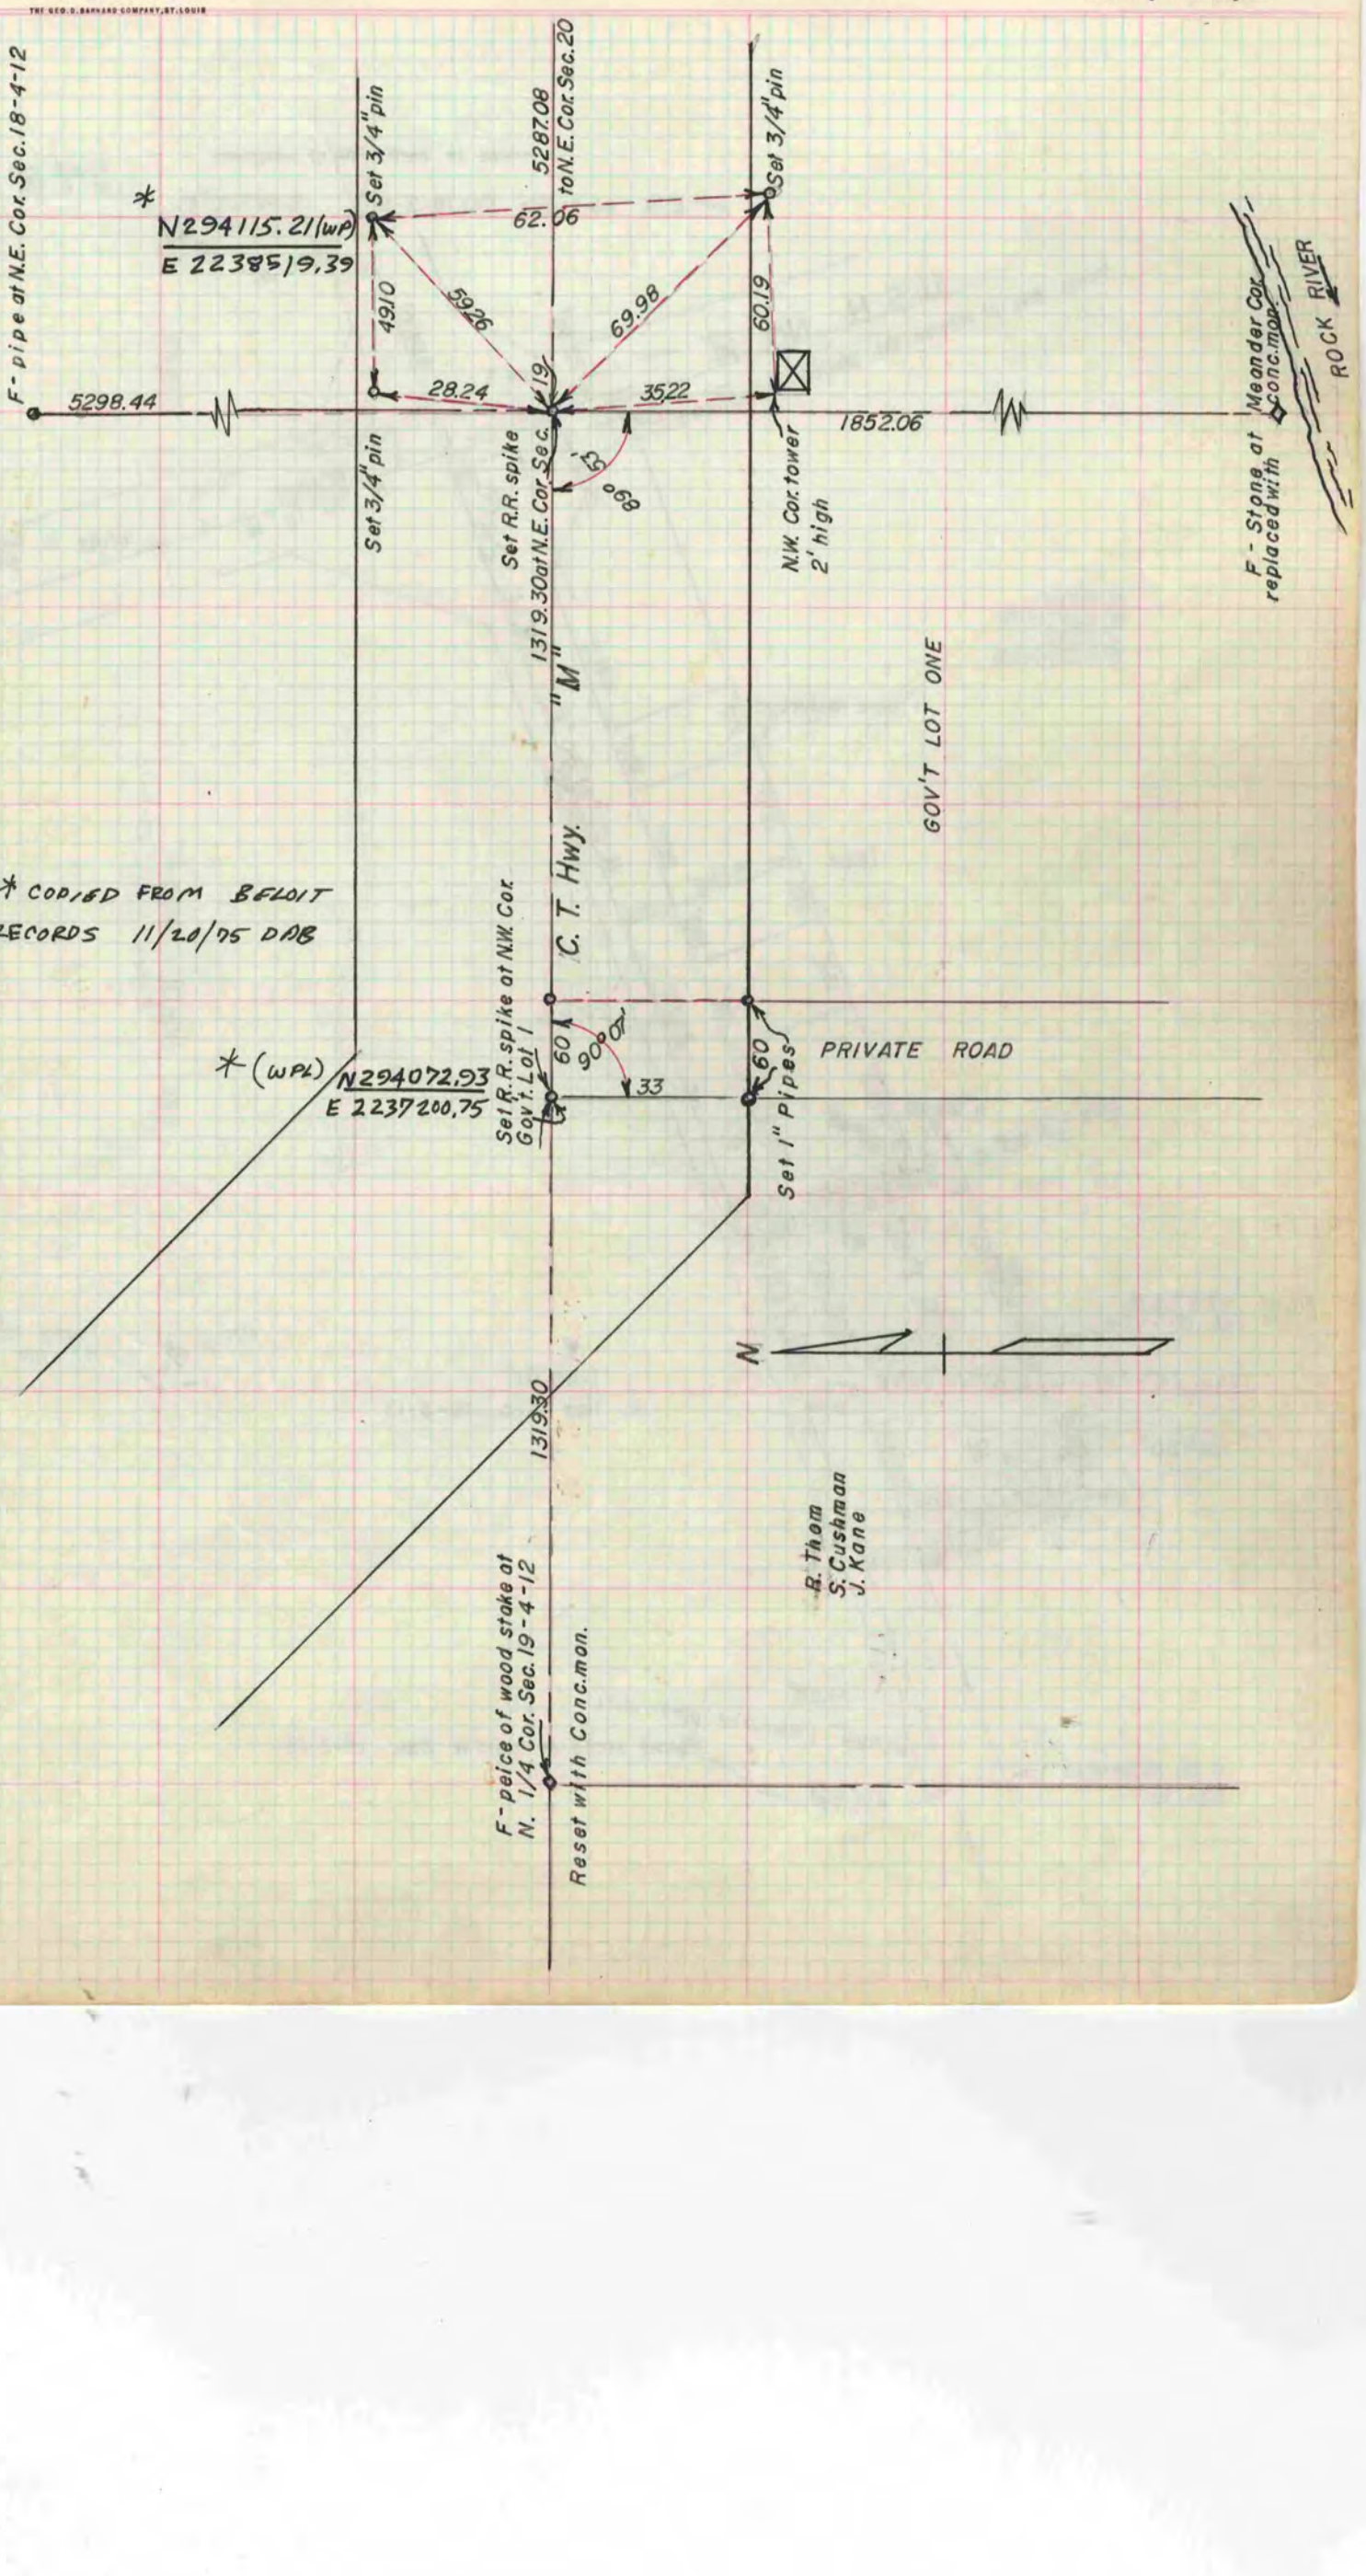
MICROFILMED
THE GEO. D. BARNARD COMPANY, ST. LOUIS