COUNTY BUILDING
CITY OF JANESVILLE

# PLAT AND RECORD

Janes.

437
V-4

Of a Survey on Section 19 T 1 R 11 E. of the 4 P. M. in NEWARK Township

Rock County, Wisconsin, made JUNE the 15 1970

I hereby certify that the following is a correct record of said survey as made by me.

MICROFILMED

R H Batterman Jr
County Surveyor.
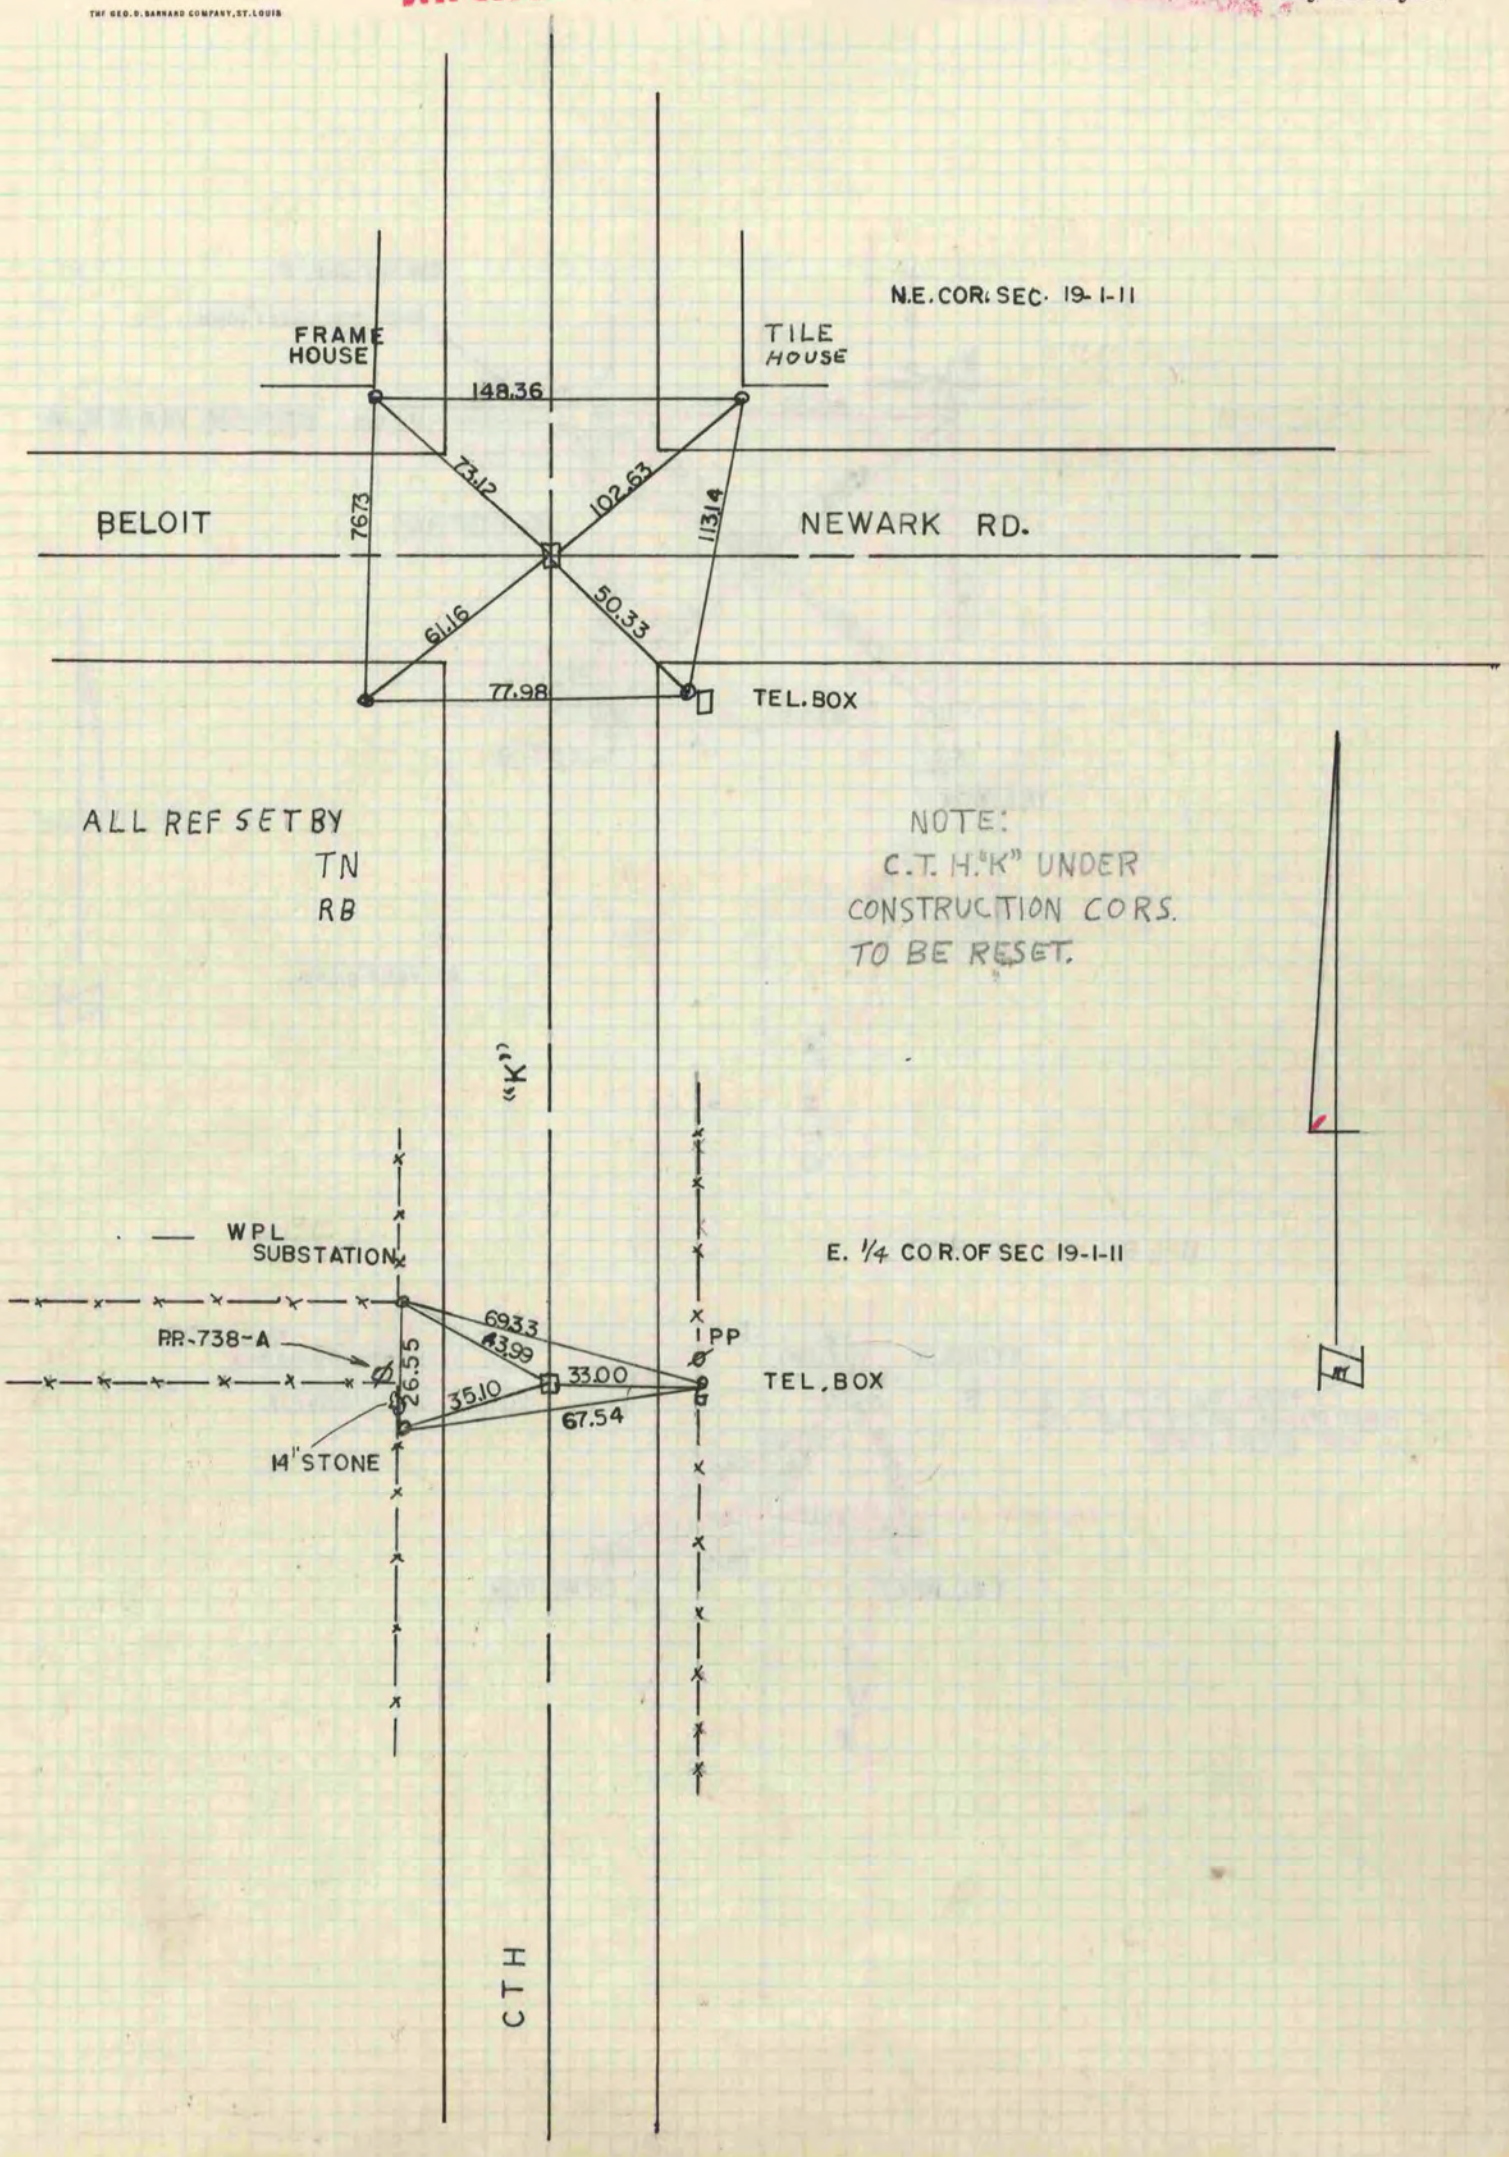
THE GEO. D. BARNARD COMPANY, ST. LOUIS