V-4 179

PG 141 BELOIT REC.
12/8/75 DAB

PLAT AND RECORD

COUNTY BUILDING
CITY OF JANESVILLE

Of a Survey on Section 17 T 1 R 13 E. of the 4 P. M. in TURTLE Township

Rock County, Wisconsin, made MARCH the 7th. 1962

I hereby certify that the following is a correct record of said survey as made by me.

MICROFILMED

R. H. Bettleman Jr.
County Surveyor.

THE GEO. D. BARNARD COMPANY, ST. LOUIS

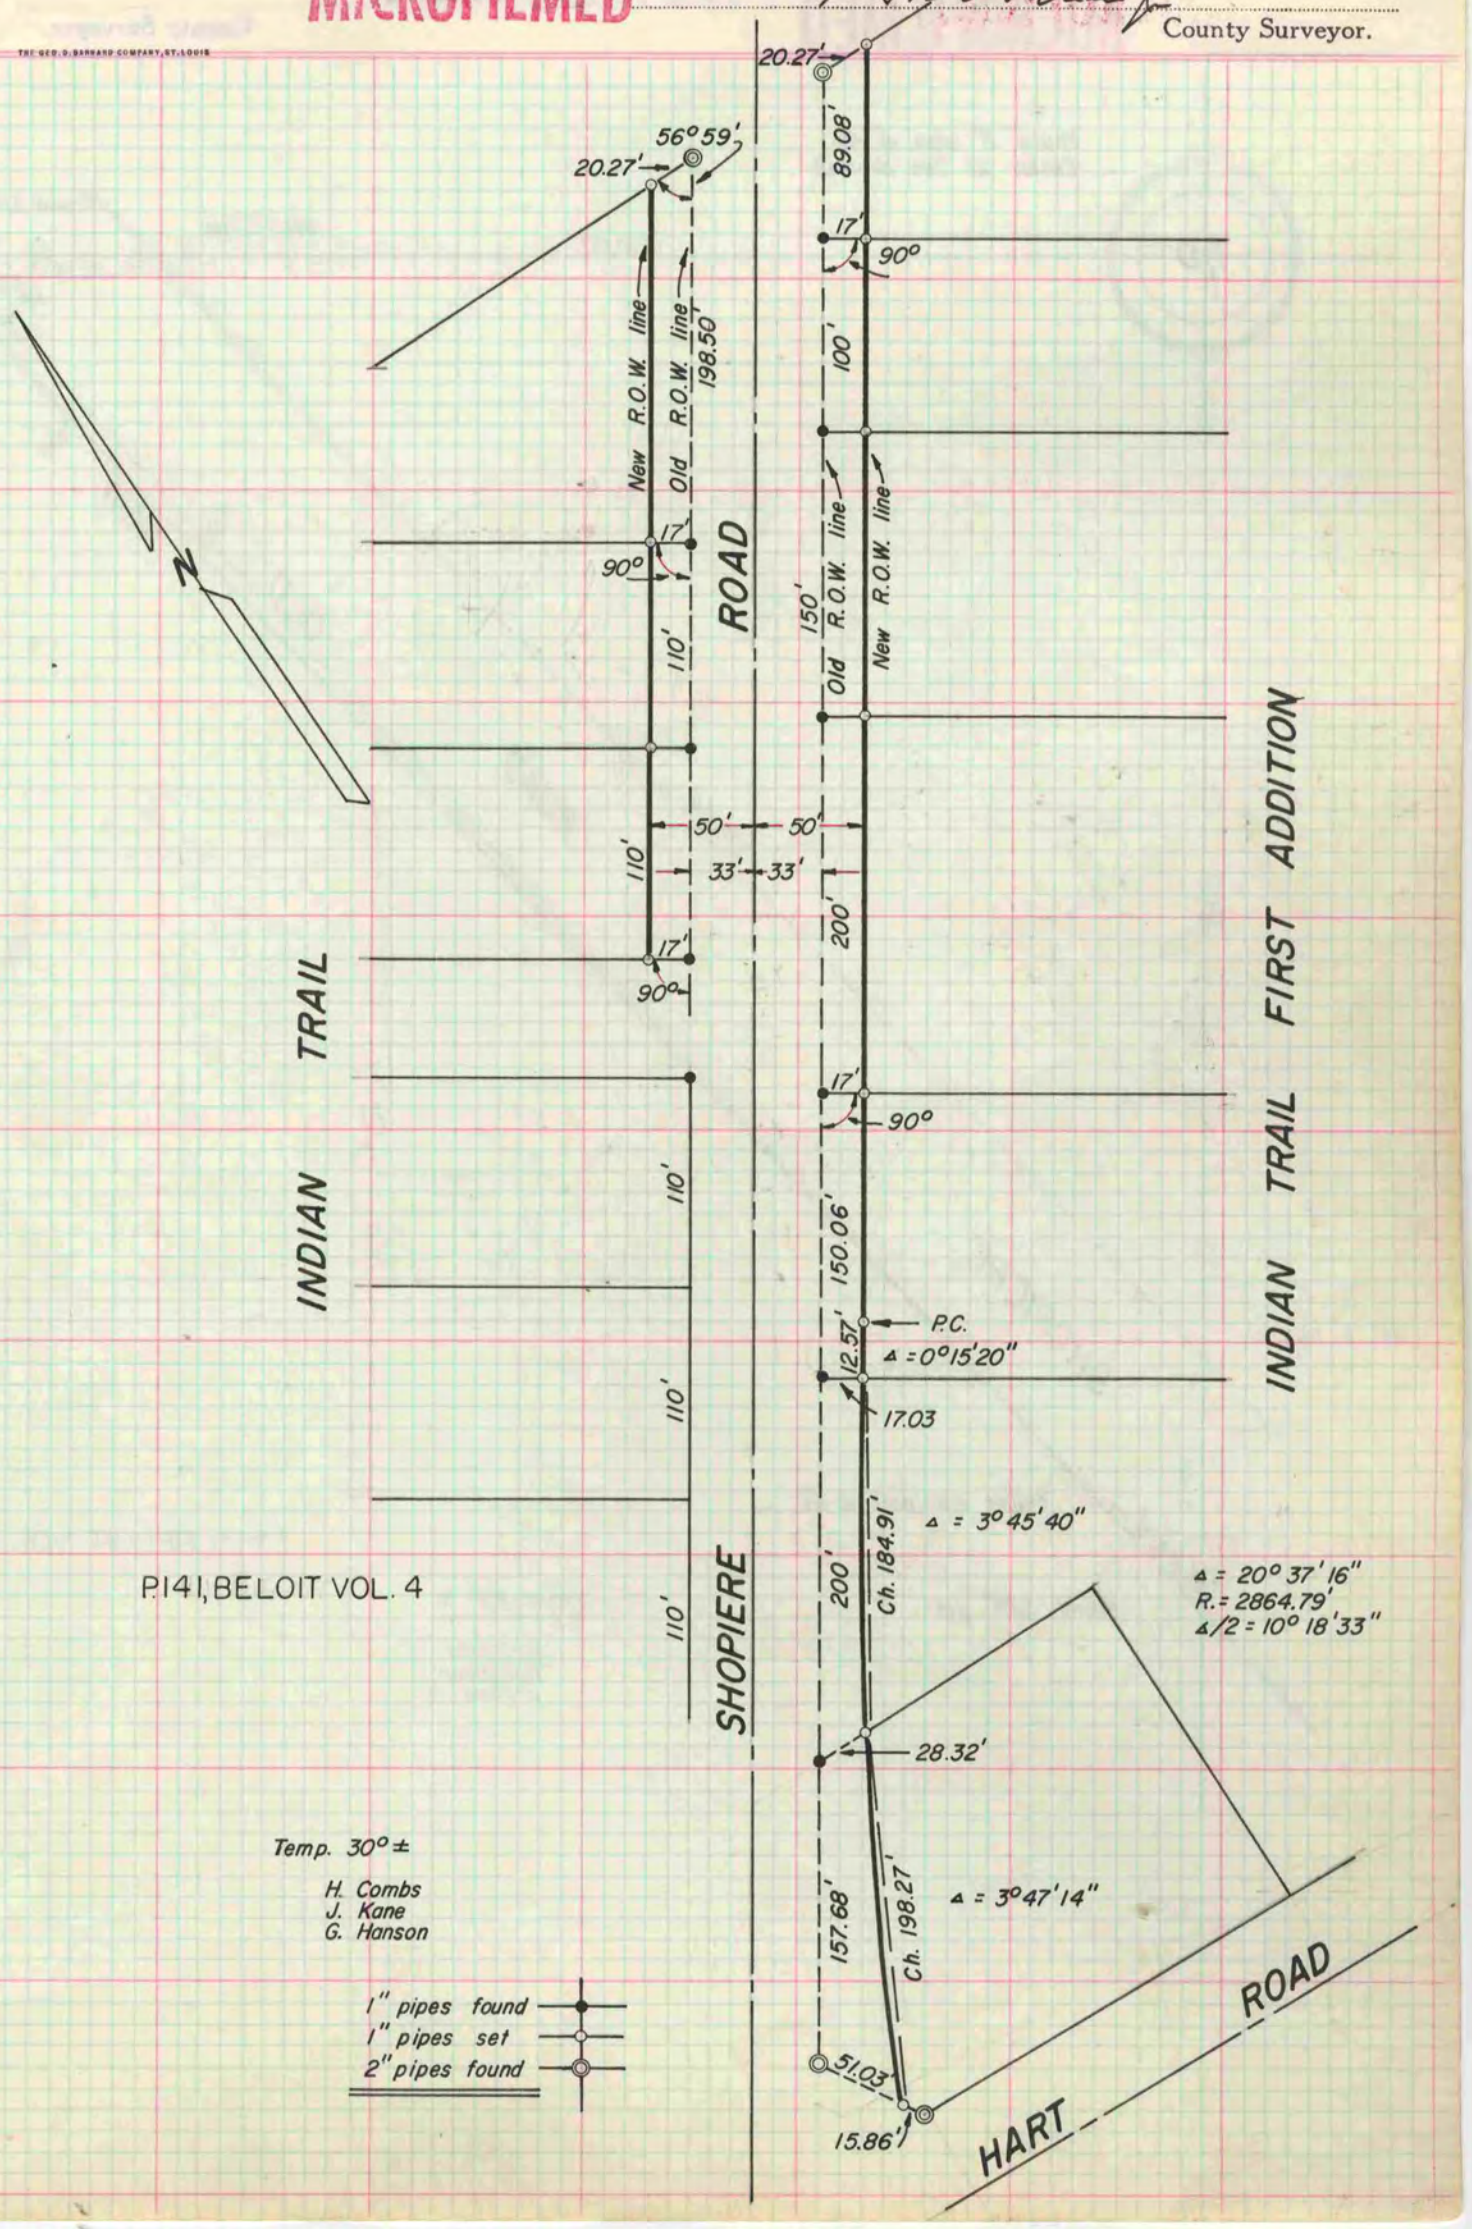

P.141, BELOIT VOL. 4

Temp. 30° ±

H. Combs
J. Kane
G. Hanson

1" pipes found
1" pipes set
2" pipes found