V-3
4.5

PLAT AND RECORD

PG 467 BELOIT REC
12/16/75 DAB

Of a Survey on Section S.E.¼ of S.E.¼ 21 T 3N. R 13 E. of the 4 P. M. in Harmony Township

Rock County, Wisconsin, made July the 12th & 13 1951

I hereby certify that the following is a correct record of said survey as made by me.

MICROFILMED
COUNTY BUILDING
CITY OF JANESVILLE
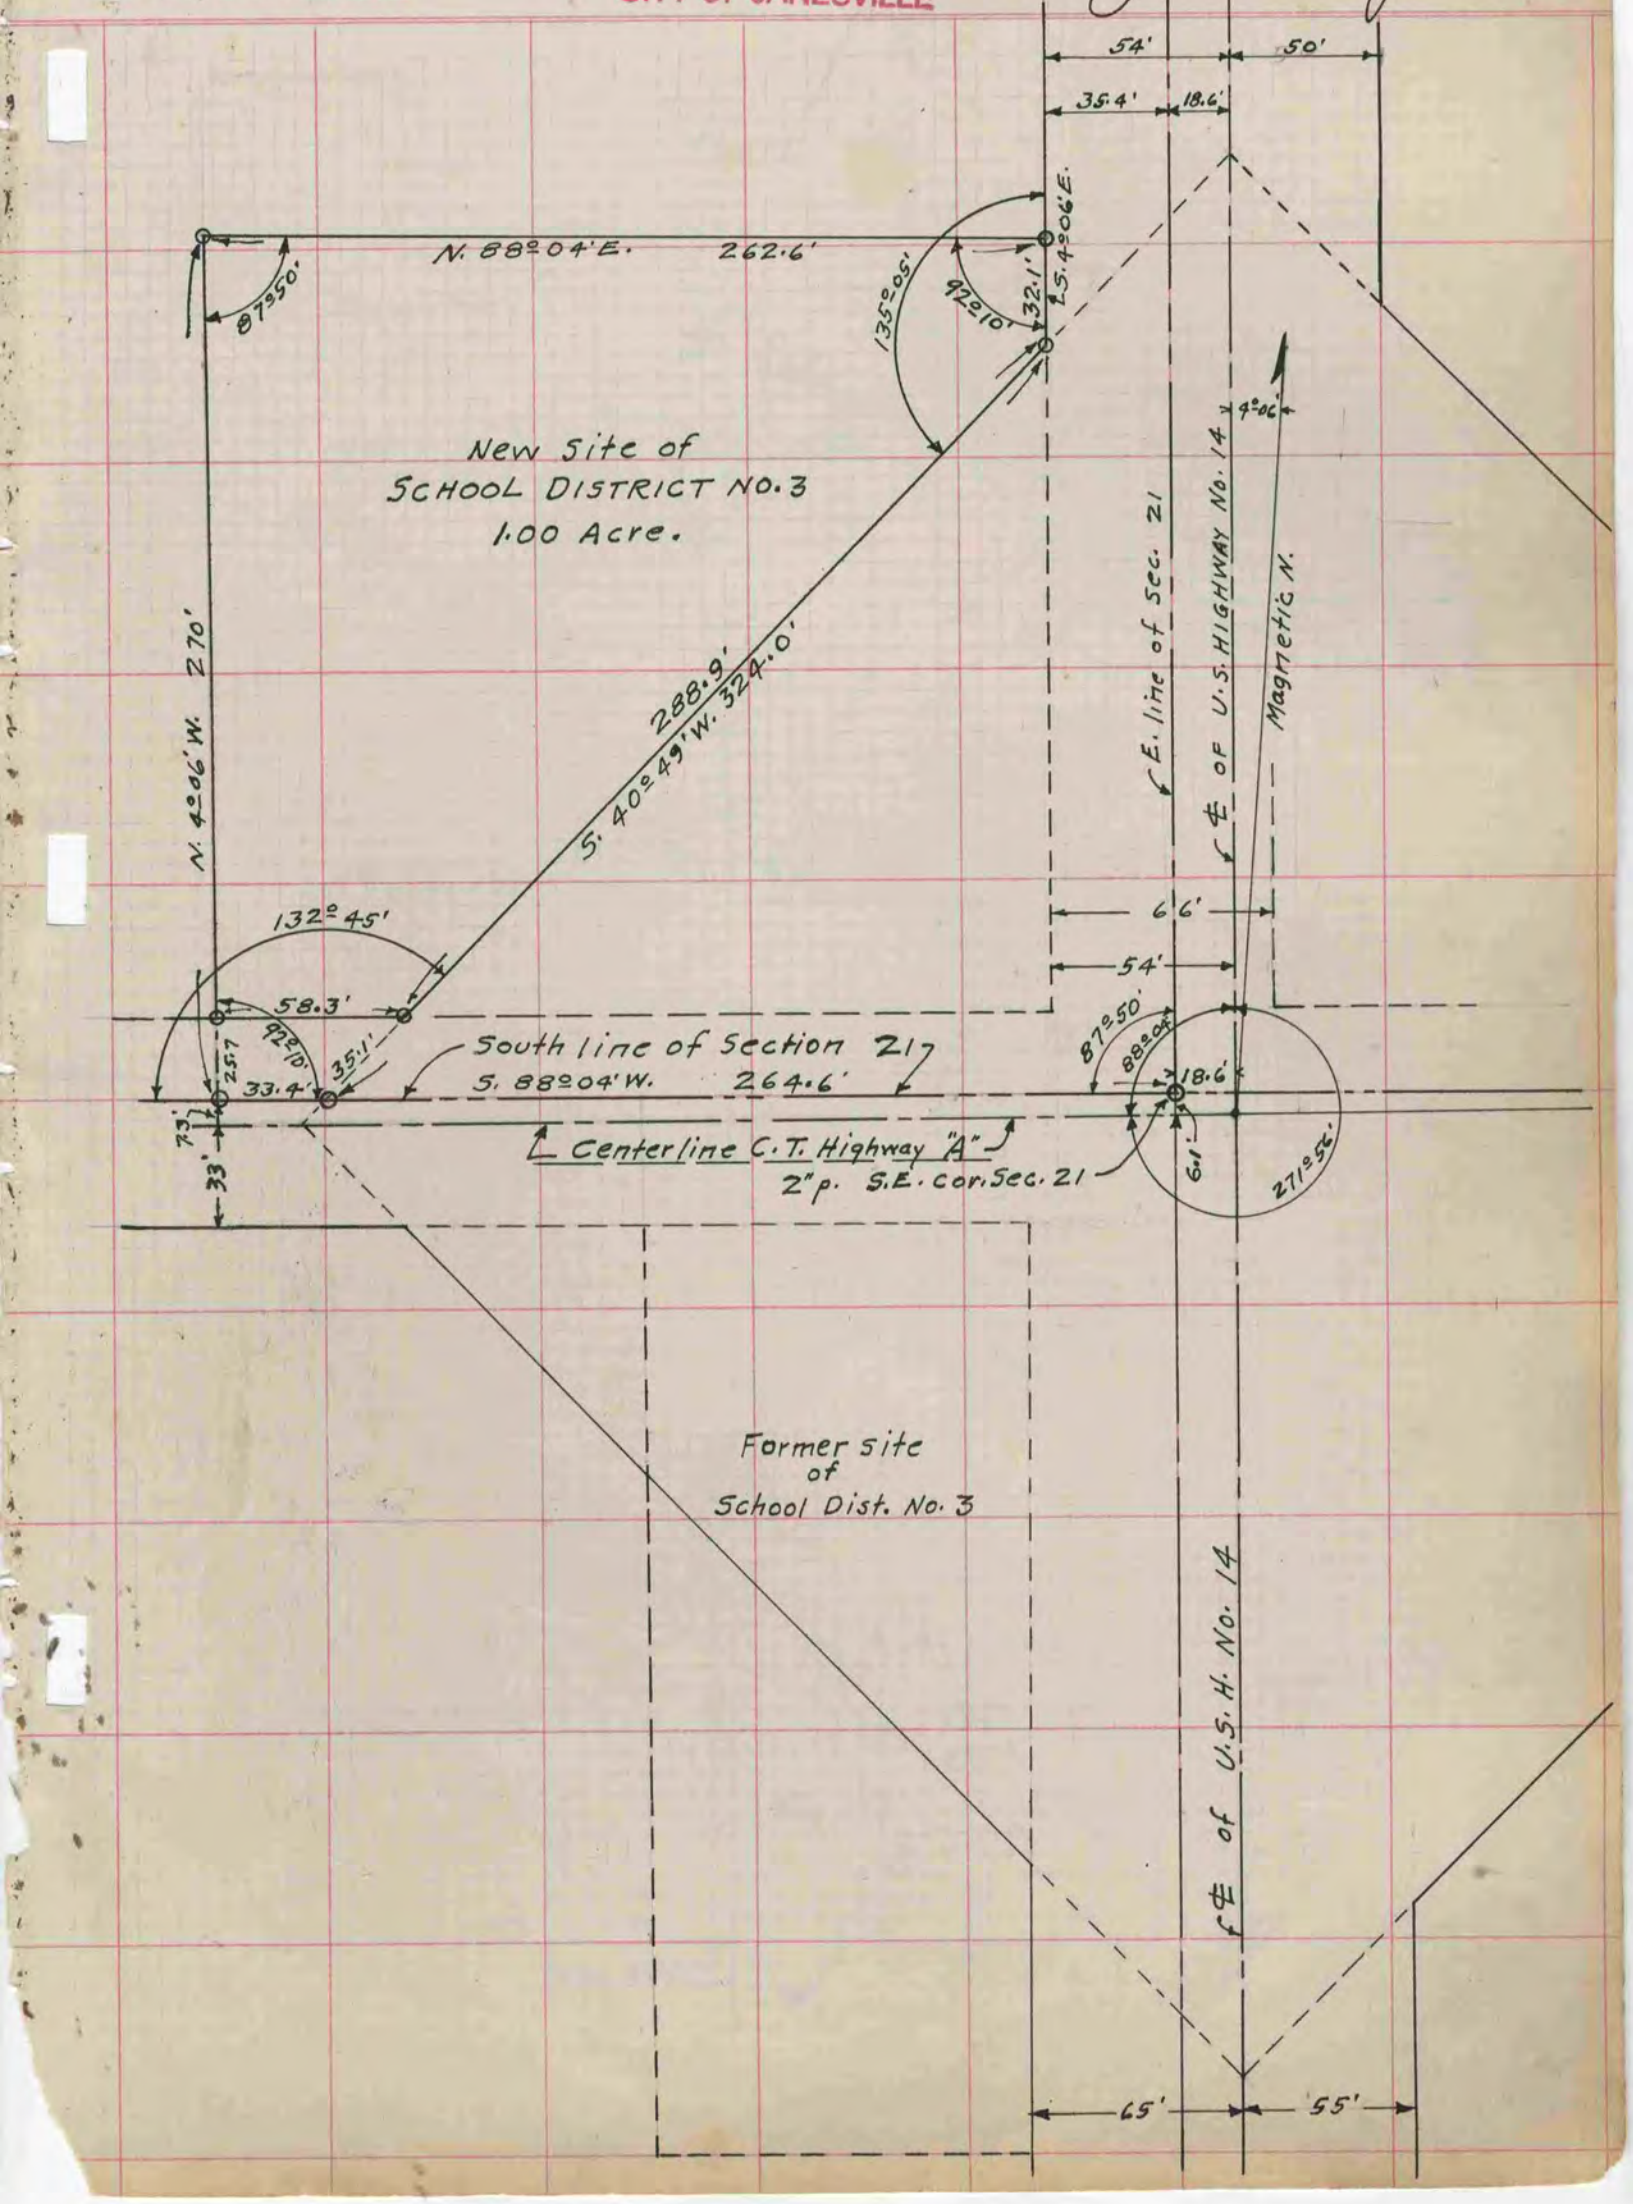
B. J. Tunney
County Surveyor.