PLAT AND RECORD

51
V-4

COUNTY BUILDING
CITY OF JANESVILLE

Of a Survey on Section 18 T 3 R 12 E. of the 4 P. M. in JANESVILLE Township

Rock County, Wisconsin, made SEPTEMBER the 15 1960

I hereby certify that the following is a correct record of said survey as made by me.

MICROFILMED
THE GEO. D. BARNARD COMPANY, ST. LOUIS
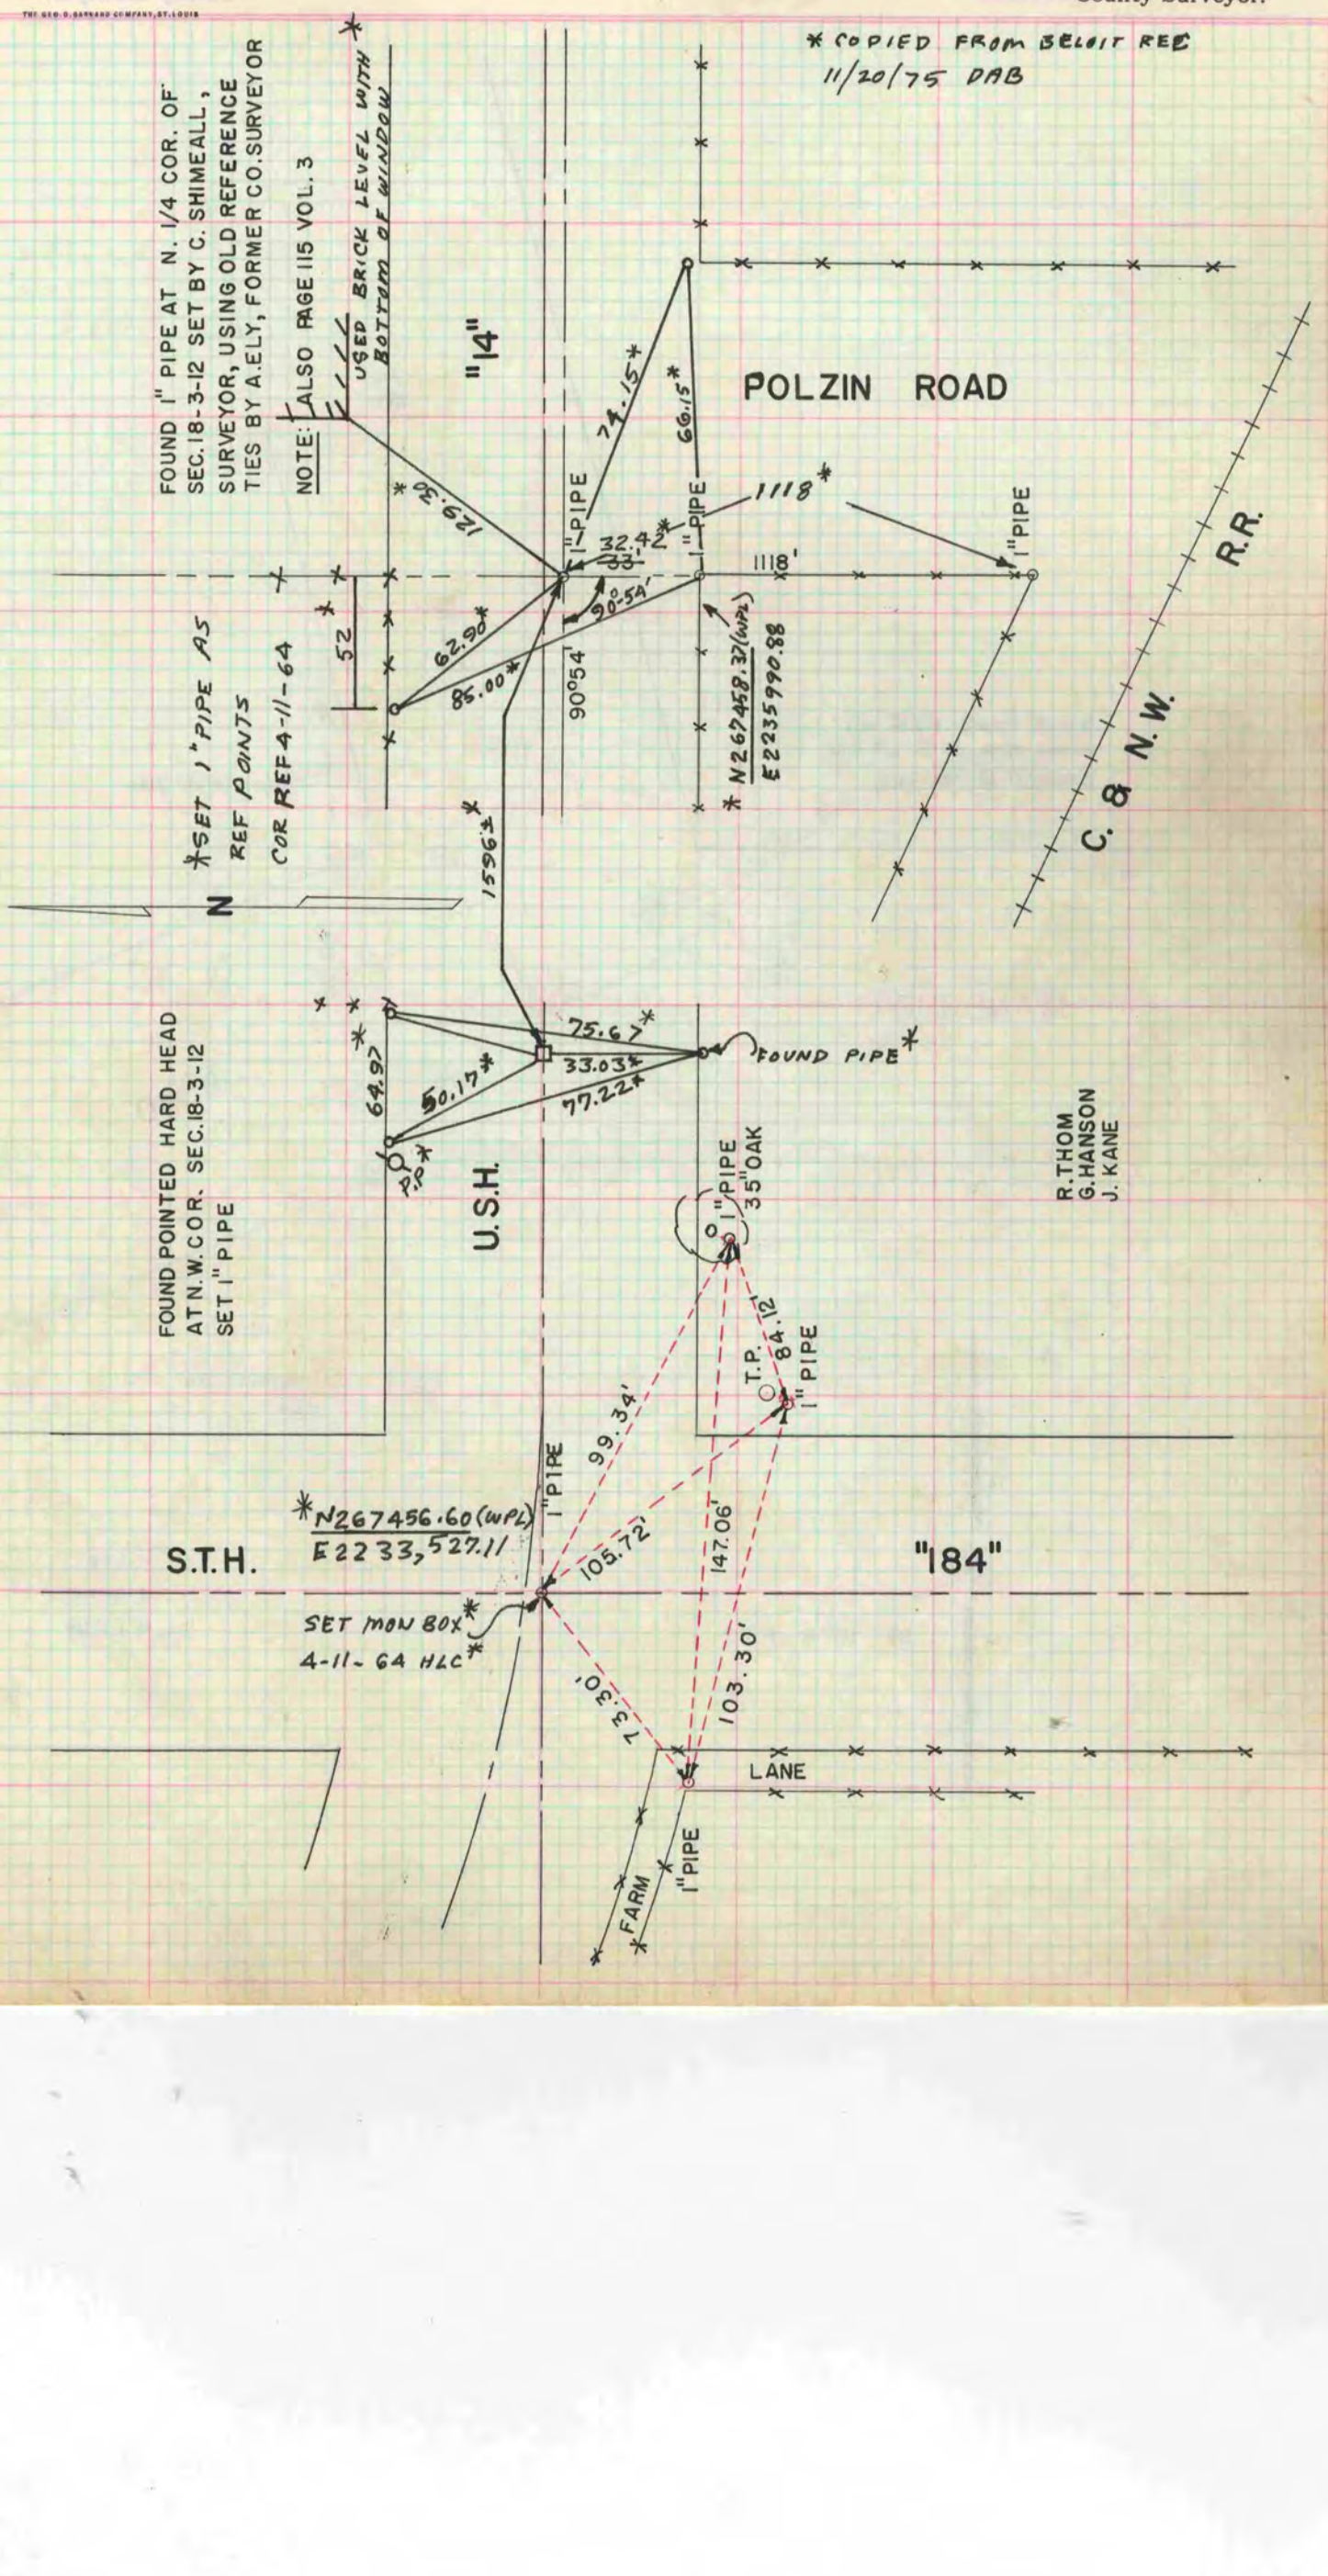
Robert Kuman
County Surveyor.