105
V-4

PLAT AND RECORD

COUNTY BUILDING
CITY OF JANESVILLE
COUNTY BUILDING
CITY OF JANESVILLE

Of a Survey on Section 2 T 3 R 12 E. of the 4 P. M. in JANESVILLE Township

Rock County, Wisconsin, made APRIL the 24th 1964

I hereby certify that the following is a correct record of said survey as made by me.

MICROFILMED
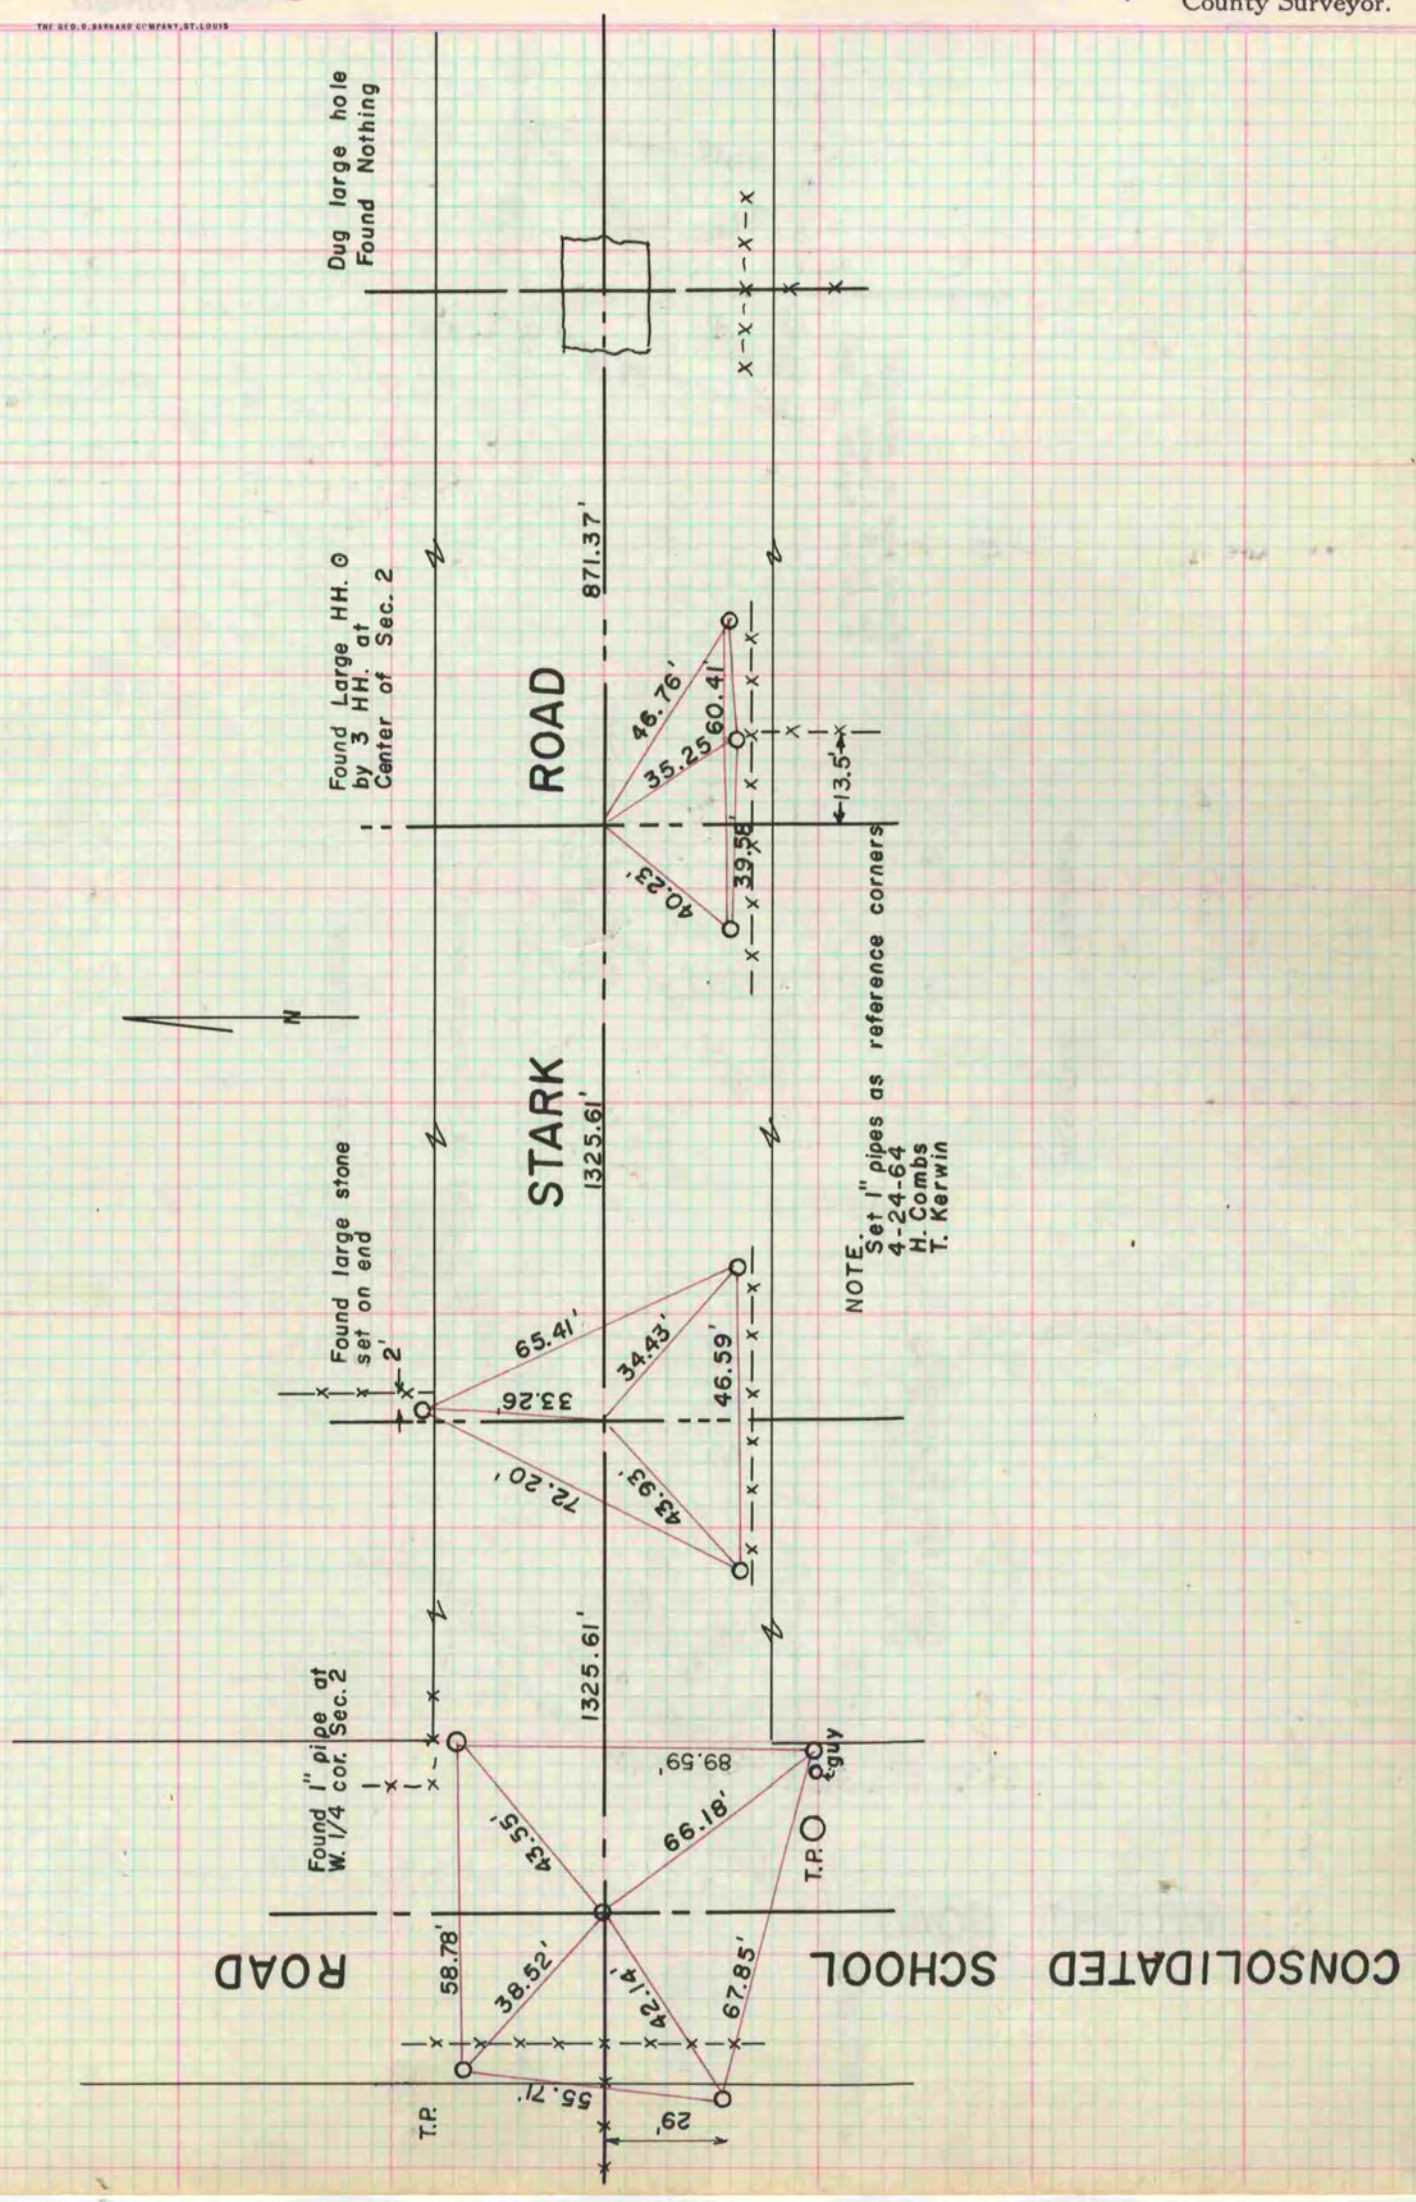
R. H. Batt Eman Jr.
County Surveyor.