493

PLAT AND RECORD

COUNTY BUILDING
CITY OF JANESVILLE

VOL. 5

Of a Survey on Section 22,23 27,26 T 4 R 13 E. of the 4 P. M. in MILTON Township

Rock County, Wisconsin, made ..... the 19

I hereby certify that the following is a correct record of said survey UNKNOWN

THE INFORMATION WAS COPIED FROM PAGE 580 OF COUNTY SURVEYORS RECORDS. THIS PAGE IS FILED IN MILTON TWP SEC 28 B-I FILES

County Surveyor.

THE W. D. BARNARD COMPANY, ST. LOUIS

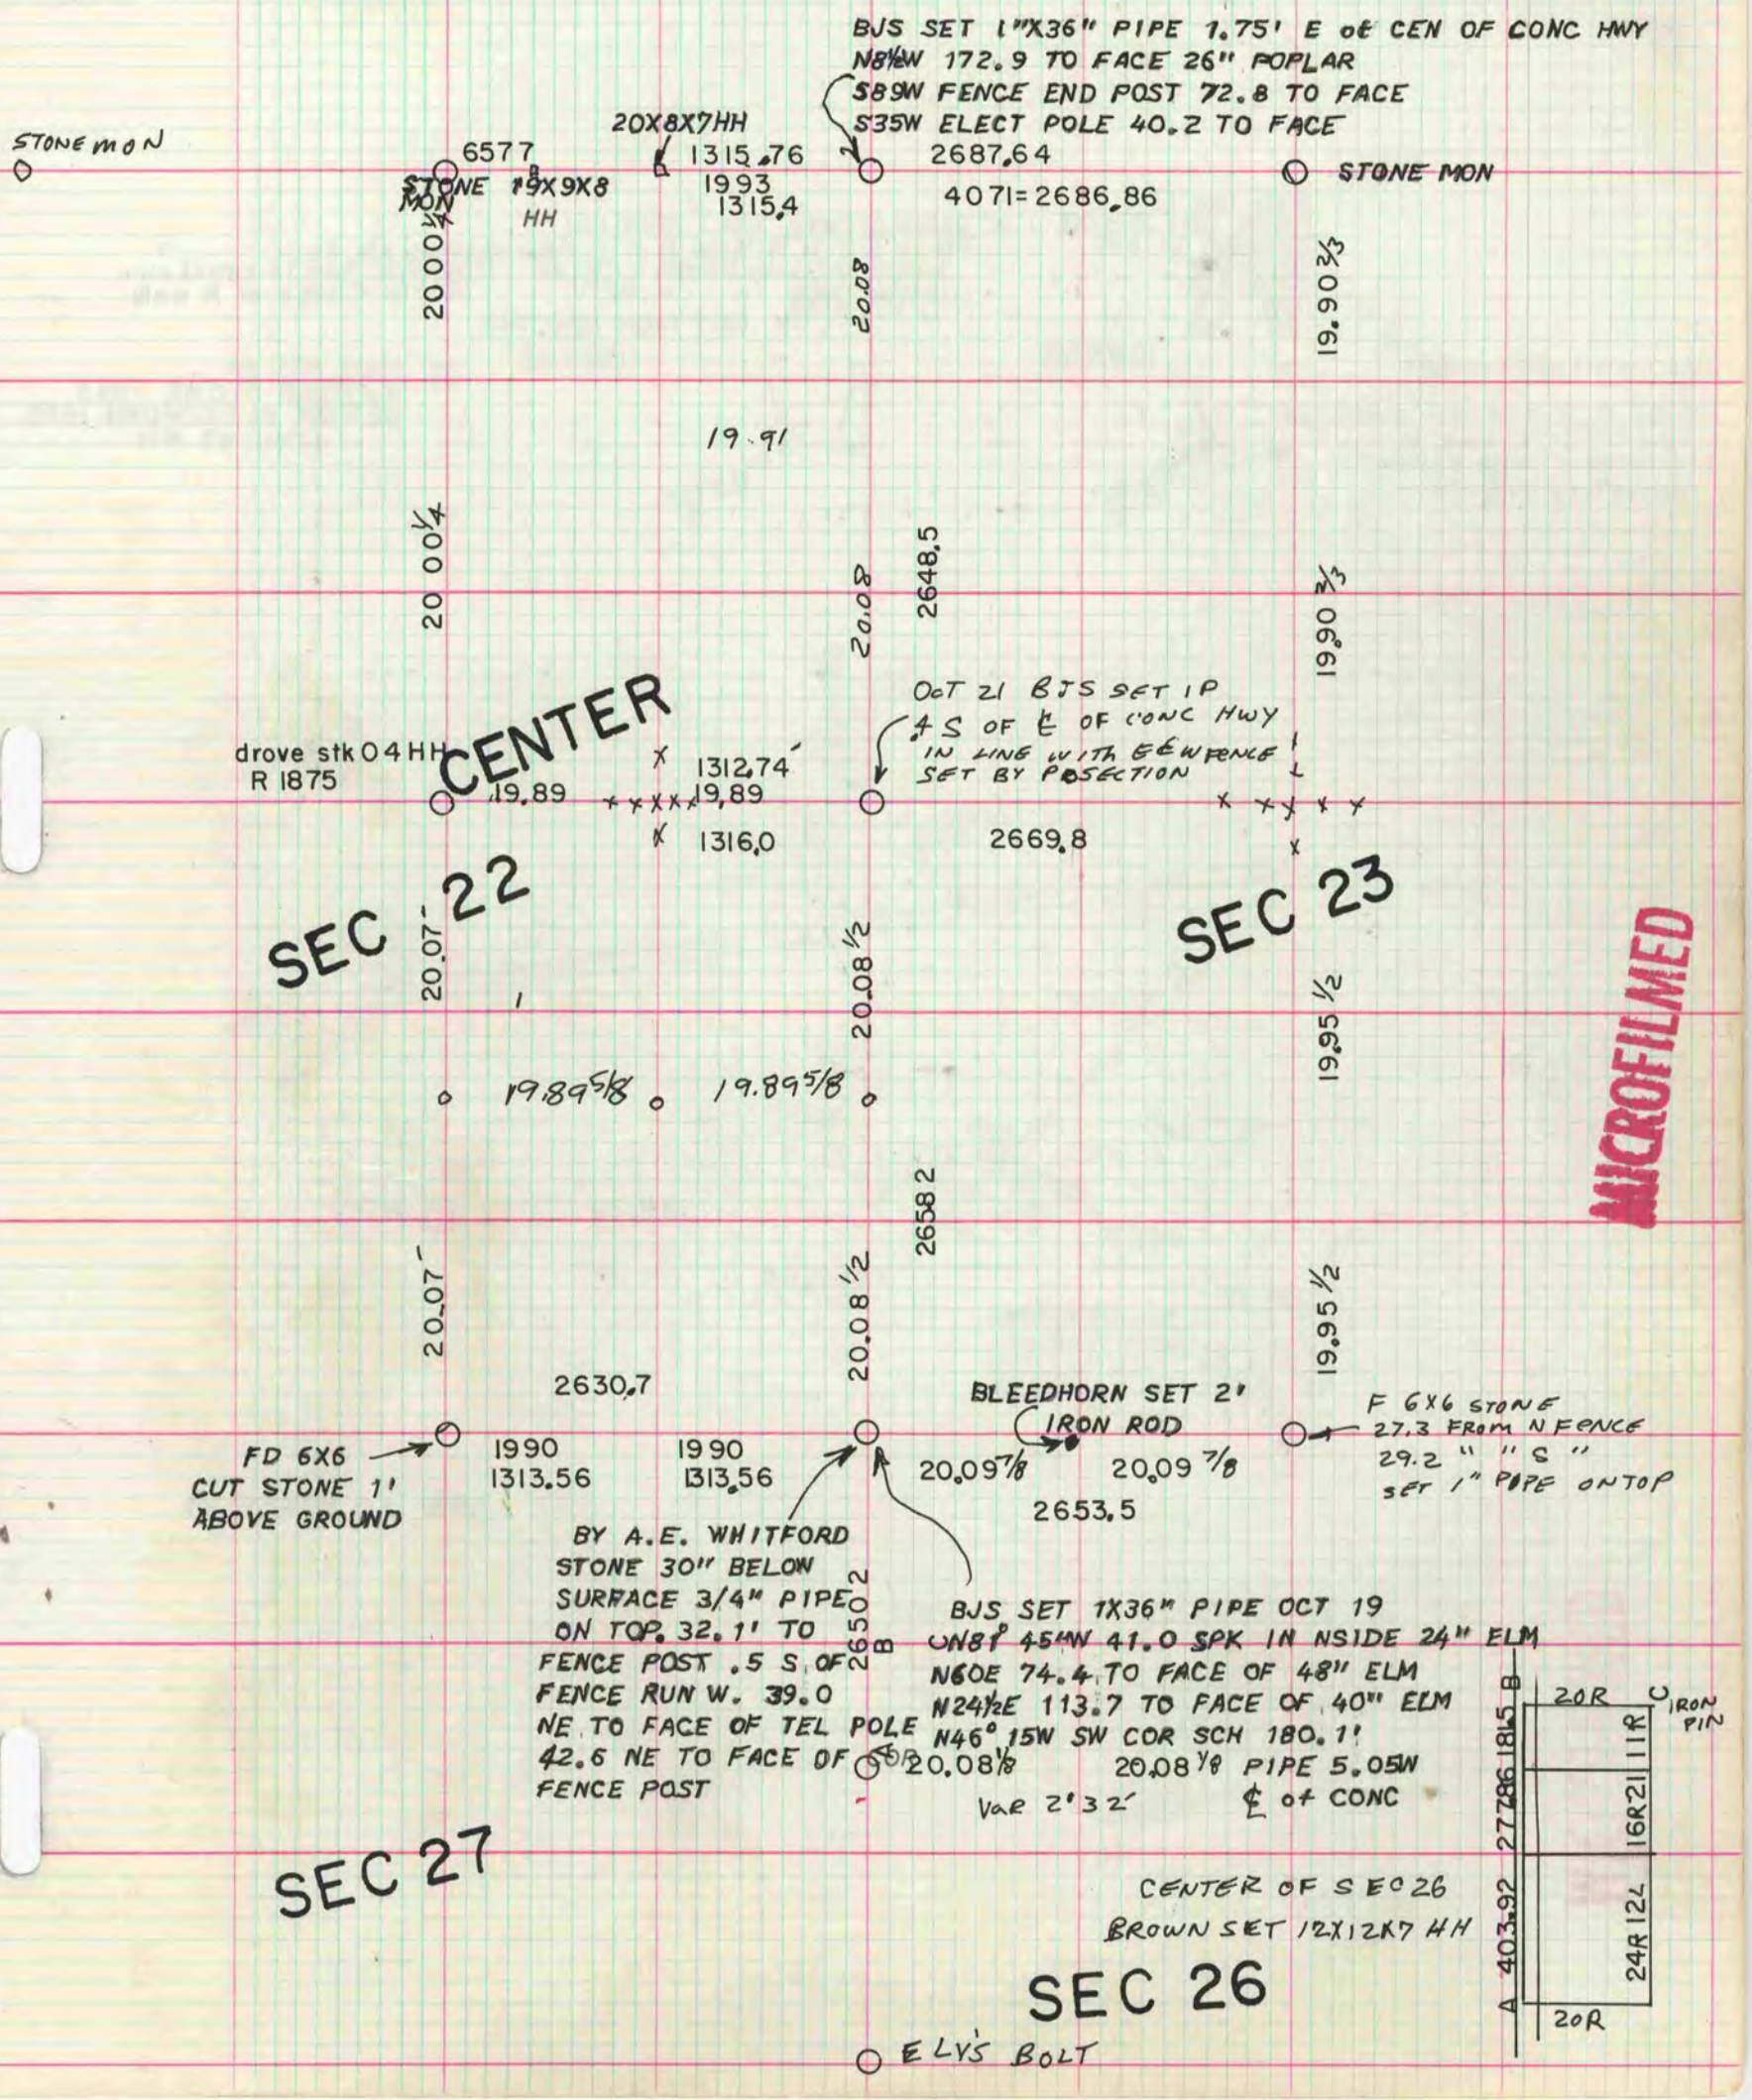

MICROFILMED