368

VOL. 6

PLAT AND RECORD

Of a Survey on Section 15, 22 T 2 R 10 E. of the 4 P. M. in SPRING VALLEY Township

Rock County, Wisconsin, made June the 2 1987

I hereby certify that the following is a correct record of said survey as made by me.

COUNTY BUILDING
CITY OF JANESVILLE

Donald Barnes
County Surveyor.

THE GEO. F. BARNARD COMPANY, ST. LOUIS
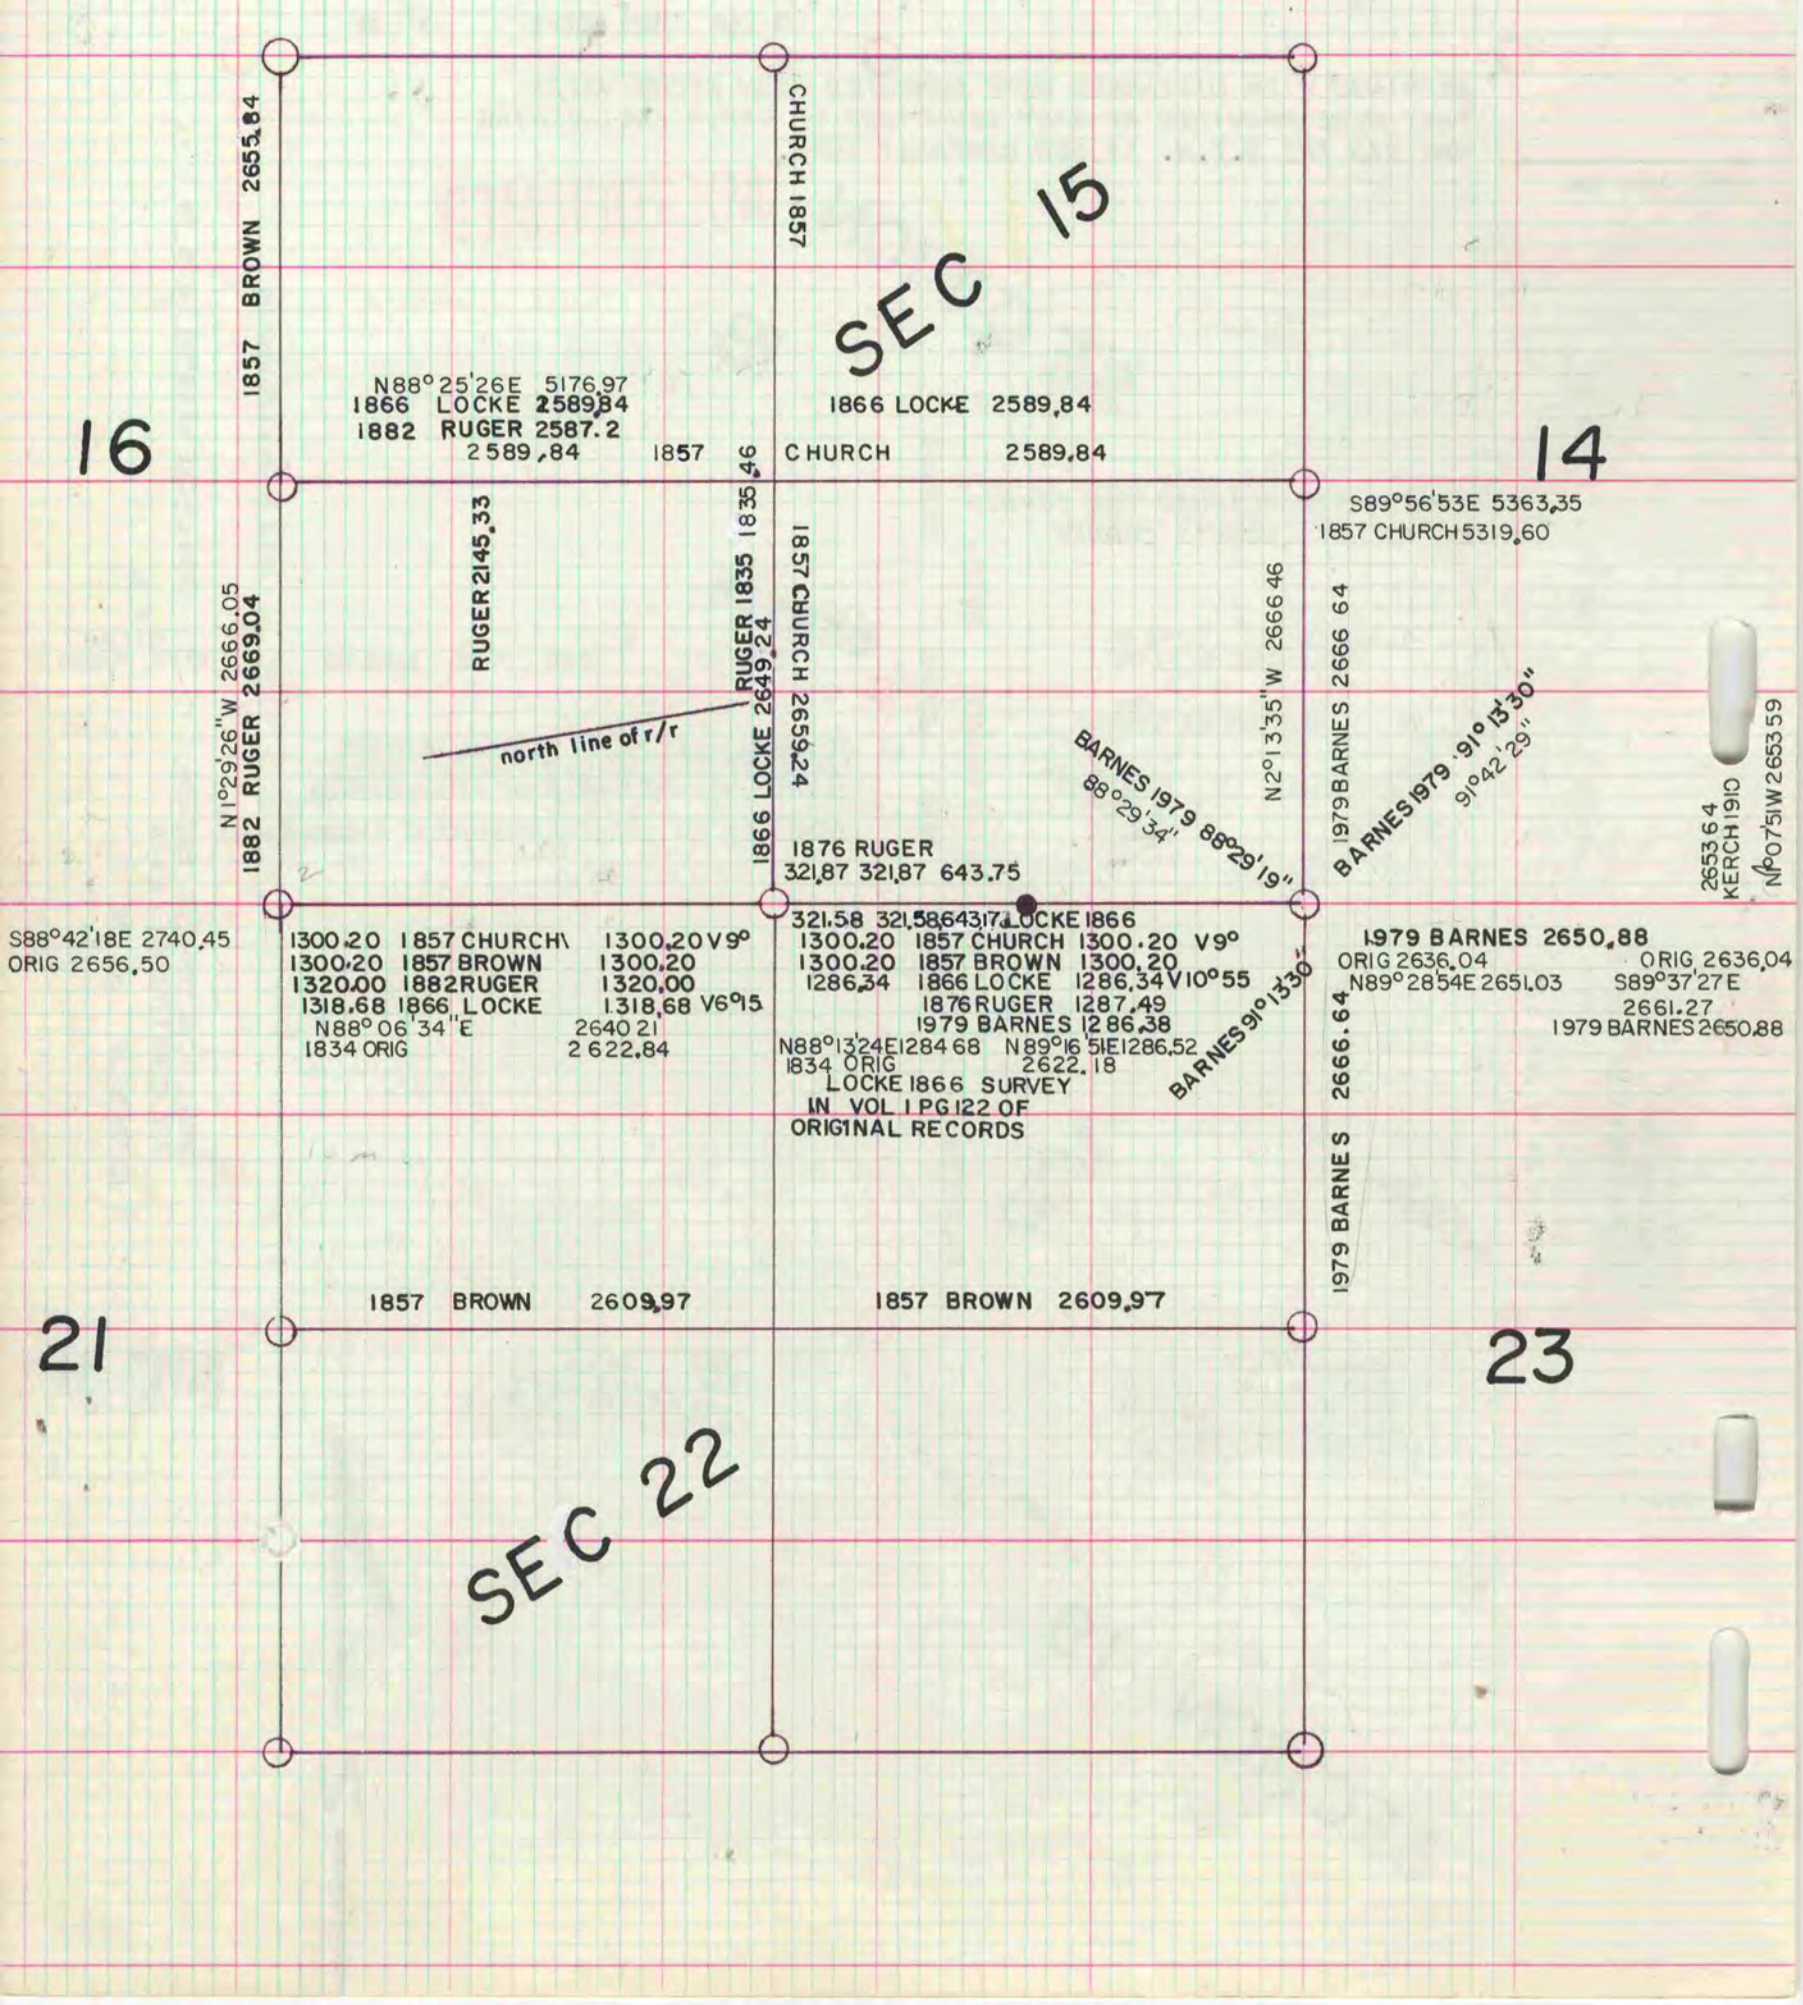
MICROFILMED