434

VOL. 6

PLAT AND RECORD

Of a Survey on Section 28 - 33 T 1 N. R 15 E. of the 4 P. M. in SHARON Township

~~Rock~~ County, Wisconsin, made DECEMBER the 13 th 19 93

WALWORTH

I hereby certify that the following is a correct record of said survey as made by me.

COUNTY BUILDING
CITY OF JANESVILLE

County Surveyor.

THE GEO. D. BARNARD COMPANY, ST. LOUIS

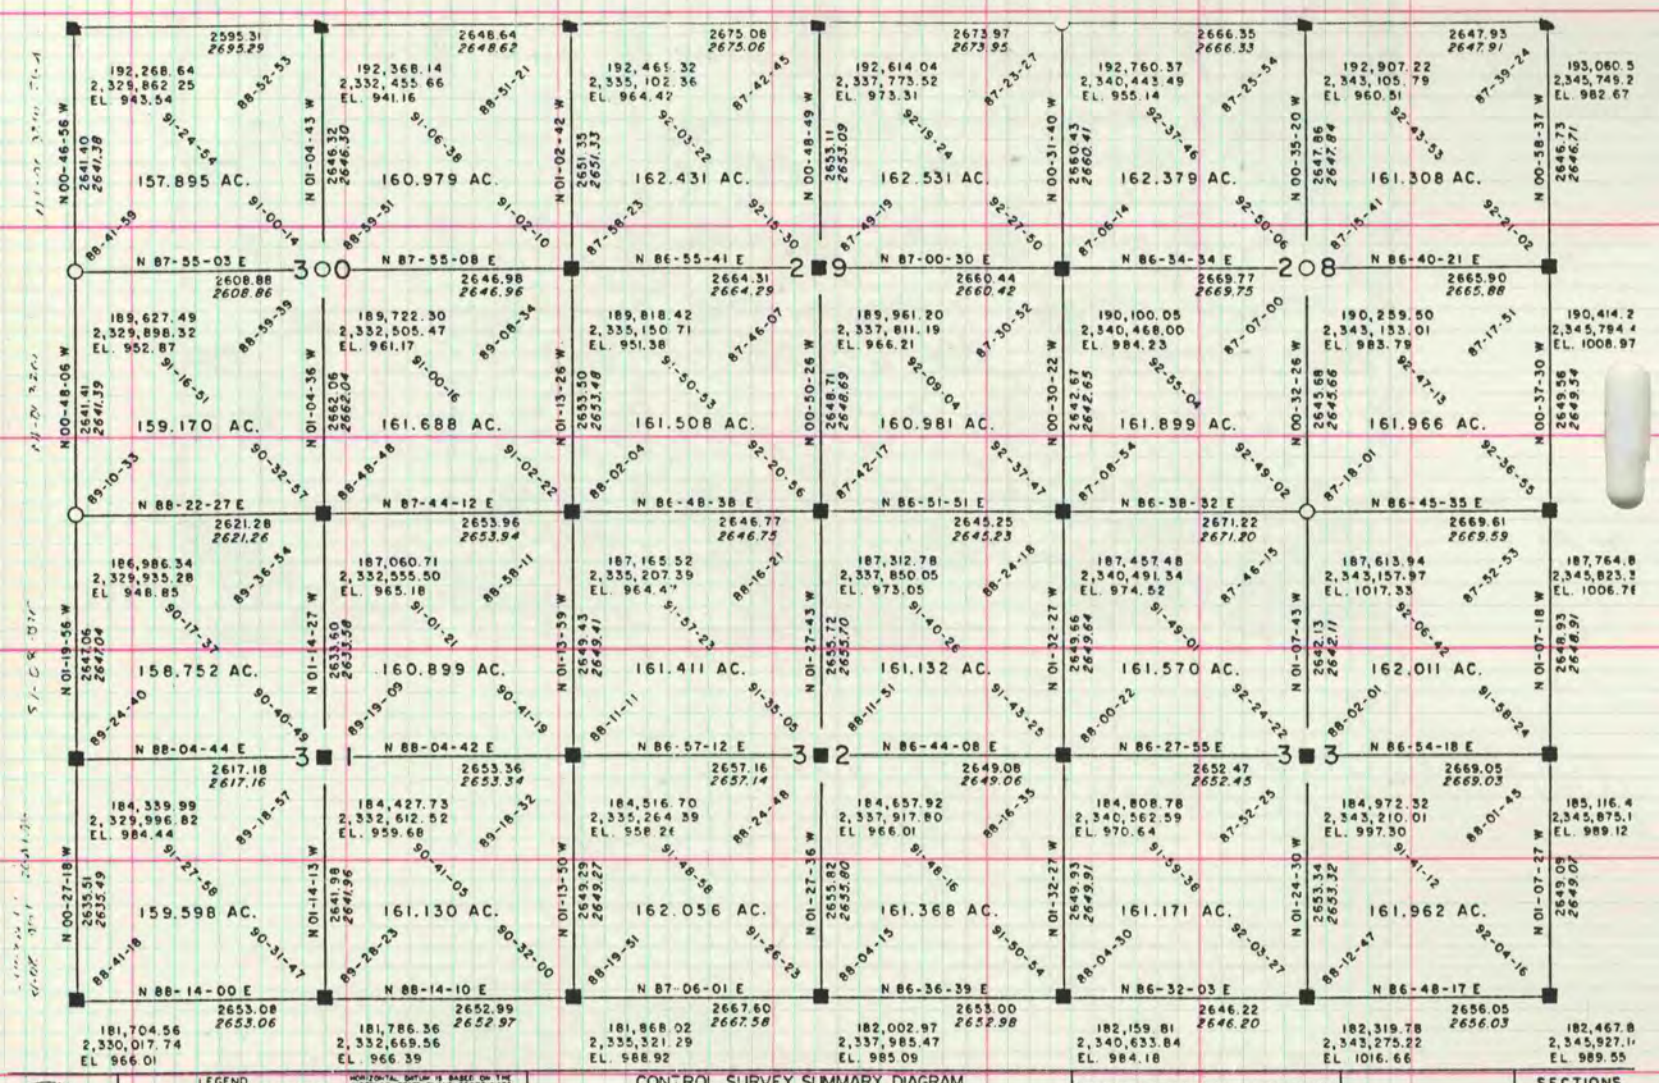

LEGEND

- ○ U.S. PUBLIC LAND SURVEY CORNER MARKED BY 5/8" x 36" STEEL CONC MONUMENT WITH BRASS CAP.
- ■ U.S. PUBLIC LAND SURVEY CORNER, MARKED BY 6"x6"x36" CONC MONUMENT WITH BRASS CAP
- ○ U.S. PUBLIC LAND SURVEY CORNER, MARKED BY OTHER MONUMENTATION.
- △ N.G.S. HORIZONTAL CONTROL STATION.

HORIZONTAL DATUM IS BASED ON THE WISCONSIN STATE PLANE COORDINATE SYSTEM, 1983, SOUTH ZONE. ALL BEARINGS ARE REFERRED TO GRID NORTH

COMBINATION SCALE AND SEA LEVEL REDUCTION FACTOR 1.0000067

DIMENSIONS SHOWN IN ITALICS INDICATE GROUND LEVEL DISTANCES.

VERTICAL DATUM IS BASED ON MEAN SEA LEVEL, 1929 ADJUSTMENT.

CONTROL SURVEY SUMMARY DIAGRAM
FOR
SECTION SURVEYS
IN THE
TOWN OF SHARON
WALWORTH COUNTY, WISCONSIN

DRAWN BY: E. A. SYRRAKOS	DATE APR., 1993
CHECKED BY: L. H. KREBLIN	DATE APR., 1993
APPROVED BY: [signature]	DATE APR., 1993
REVISED	DATE

BORDER SHEETS CONTAINING ALL INFORMATION NECESSARY FOR RECOVERY AND USE OF CONTROL SURVEY STATIONS AVAILABLE FROM WALWORTH COUNTY AND NEWPFE.

SECTIONS
30, 29, 28,
31, 32, 33
T. 1 N. R. 15
WALWORTH COUNTY