436
V-4

PLAT AND RECORD

COUNTY BUILDING
CITY OF JANESVILLE

Of a Survey on Section 33 4 T 3 2 R 12 12 E. of the 4 P. M. in JANESVILLE ROCK Township

Rock County, Wisconsin, made JUNE the 2nd 1970

I hereby certify that the following is a correct record of said survey as made by me.

MICROFILMED
THE GEO. D. BARNARD COMPANY, ST. LOUIS
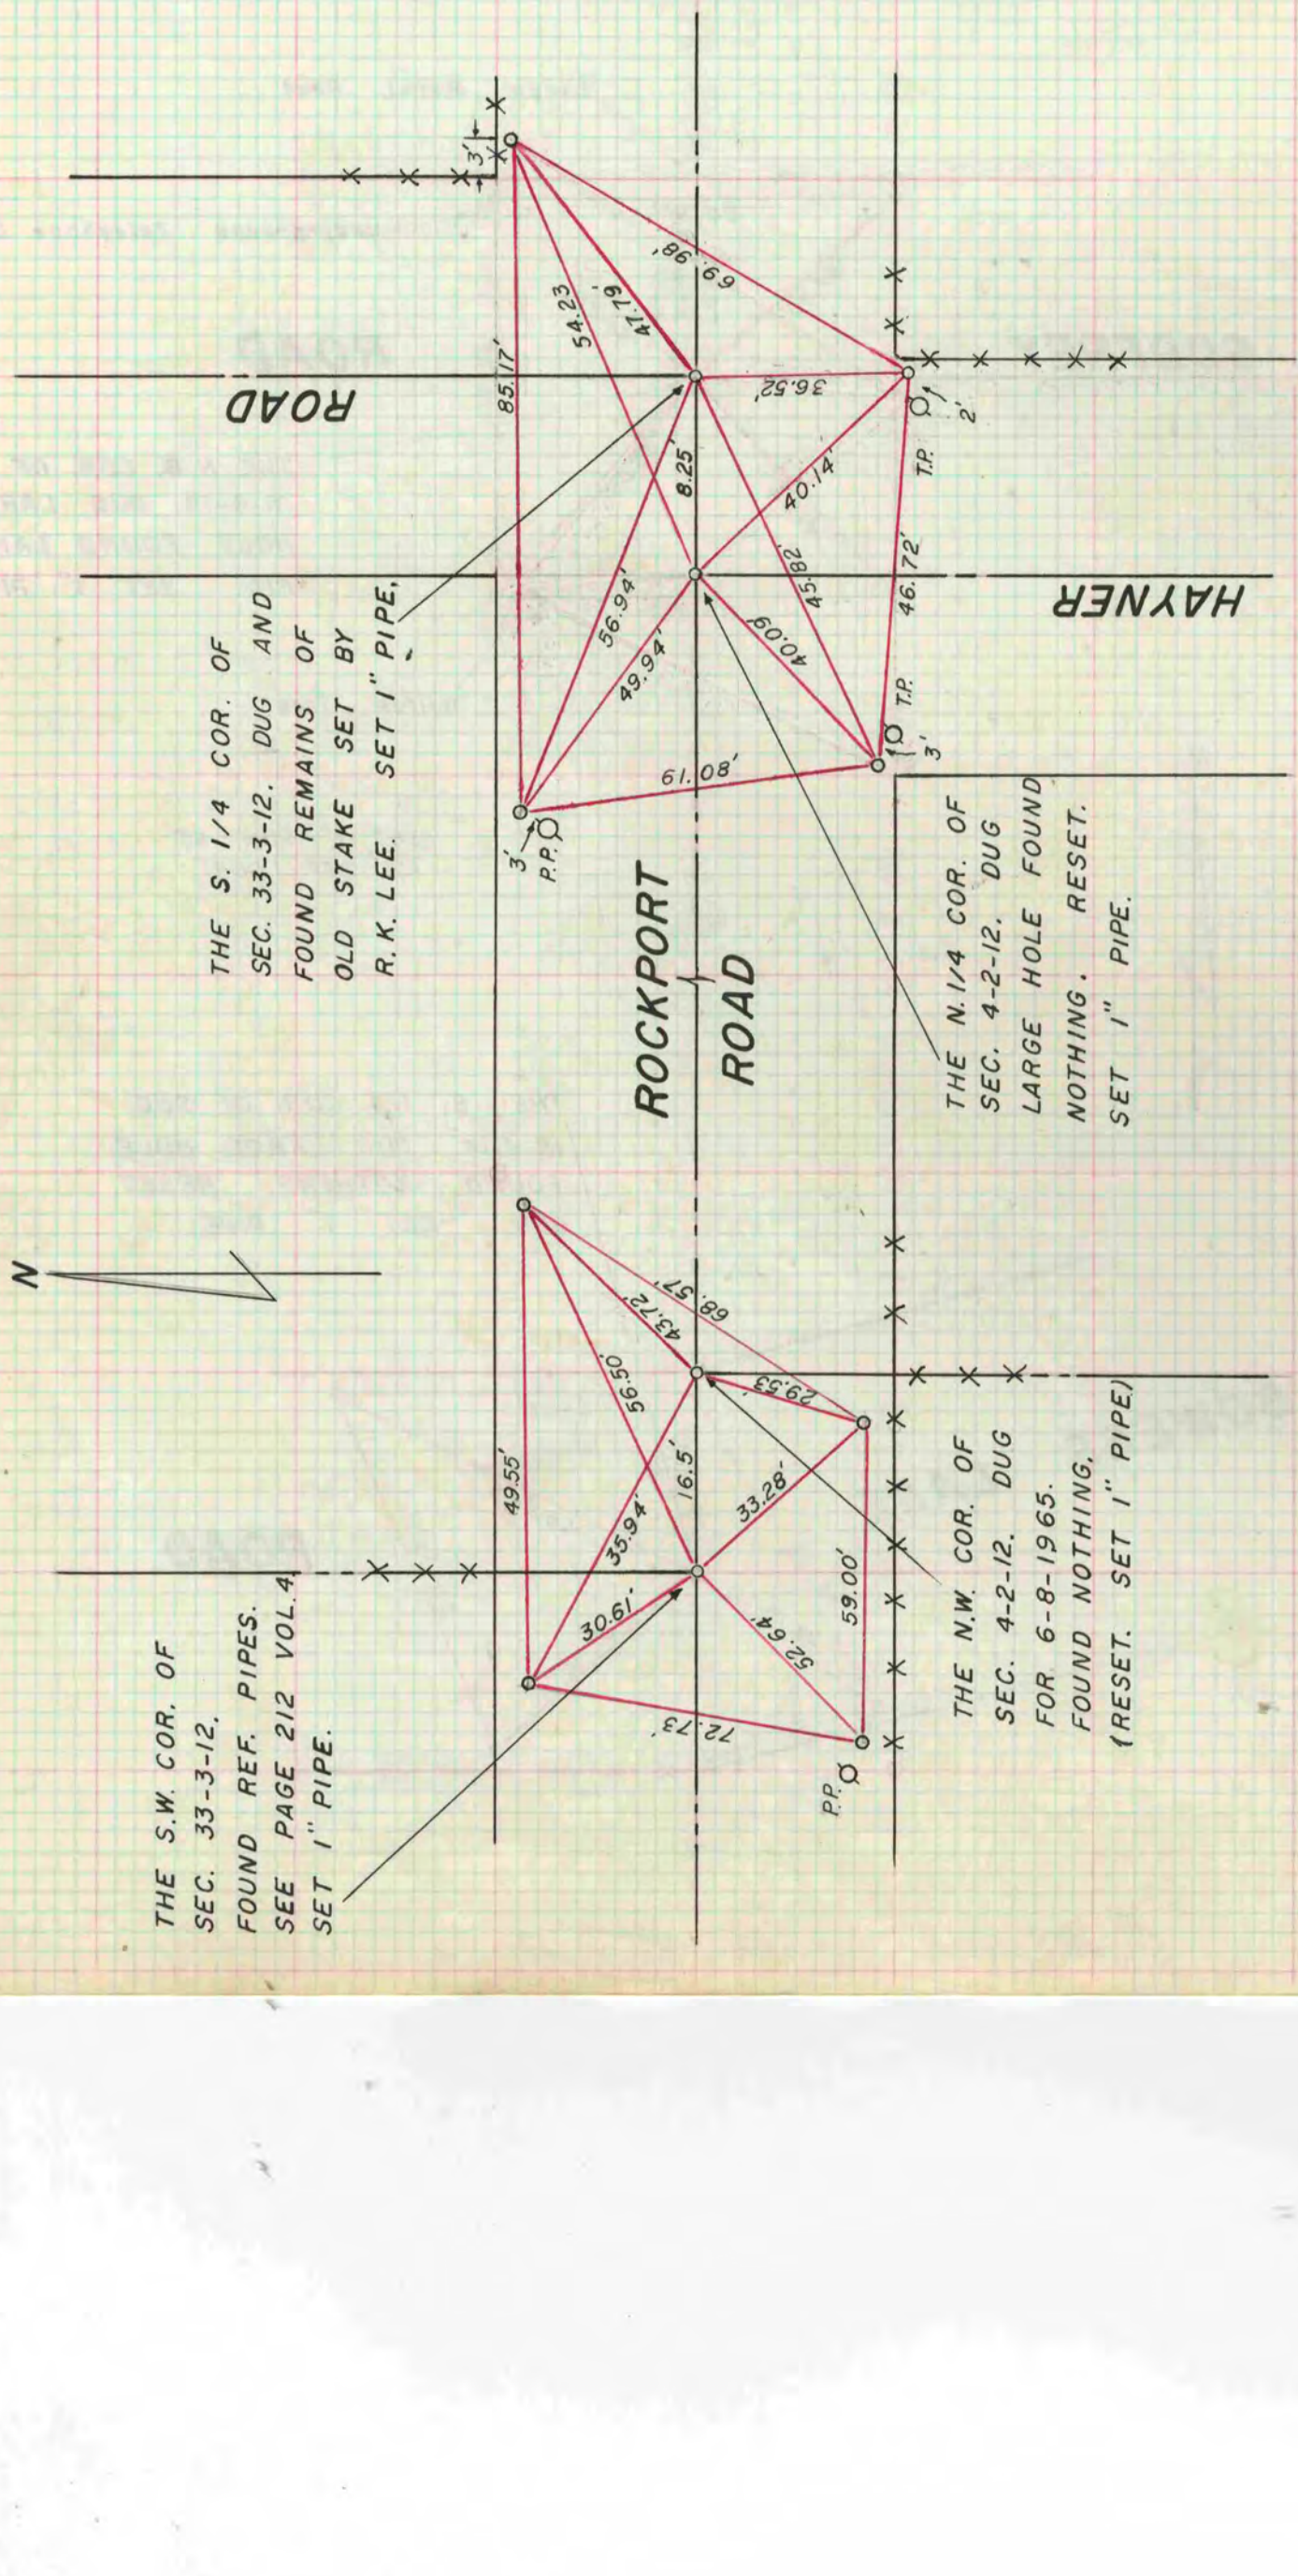
R.H. Battleman Jr
County Surveyor.