310
V-2

MICROFILMED

PLAT AND RECORD

Of a Survey on Section 28 T 2 R 12 E. of the 4 P. M. in Rock Township

Rock County, Wisconsin, made August the 27th & 28th 1880

I hereby certify that the following is a correct record of said survey as made by me.

COUNTY BUILDING
CITY OF JANESVILLE

(Signed) R. K. Lee Dept.
R.H.B. County Surveyor.

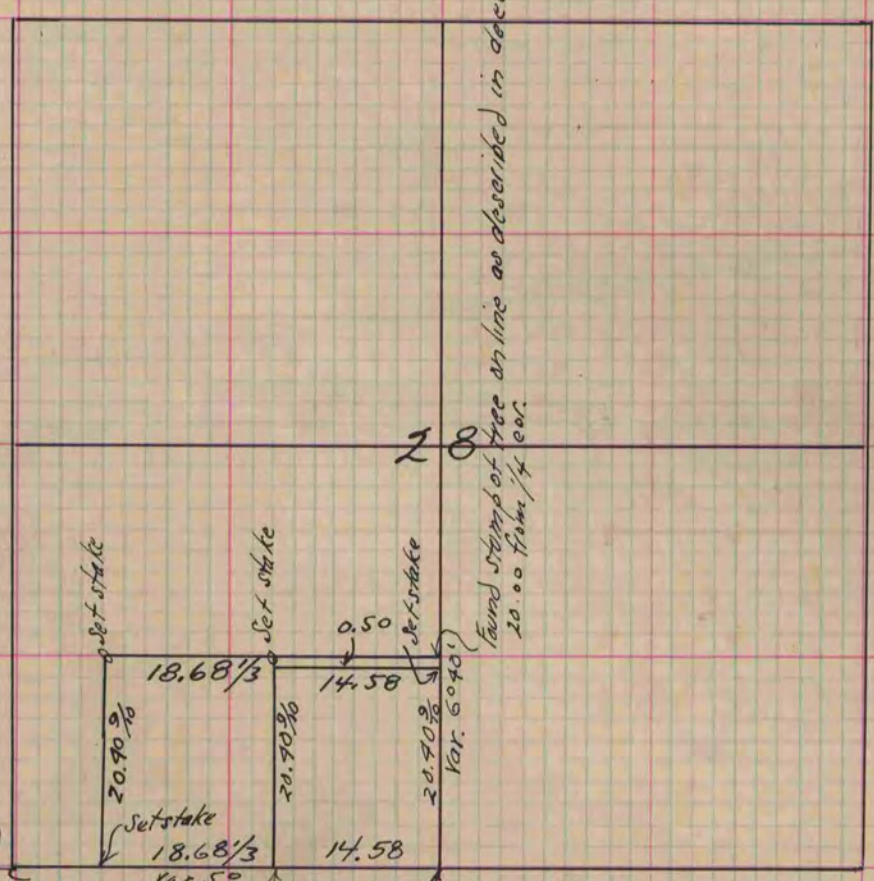

Copied from page 258 Vol. 2 County Surveyors Record