MICROFILMED
COUNTY BUILDING
CITY OF JANESVILLE

PLAT AND RECORD

Of a Survey on Section 18 T 3 R 10 E. of the 4 P. M. in Magnolia Township

Rock County, Wisconsin, made September the 2nd, 3rd & 4th 1873

I hereby certify that the following is a correct record of said survey as made by me.

(Signed) Edward Ruger
R.H.B.
County Surveyor.

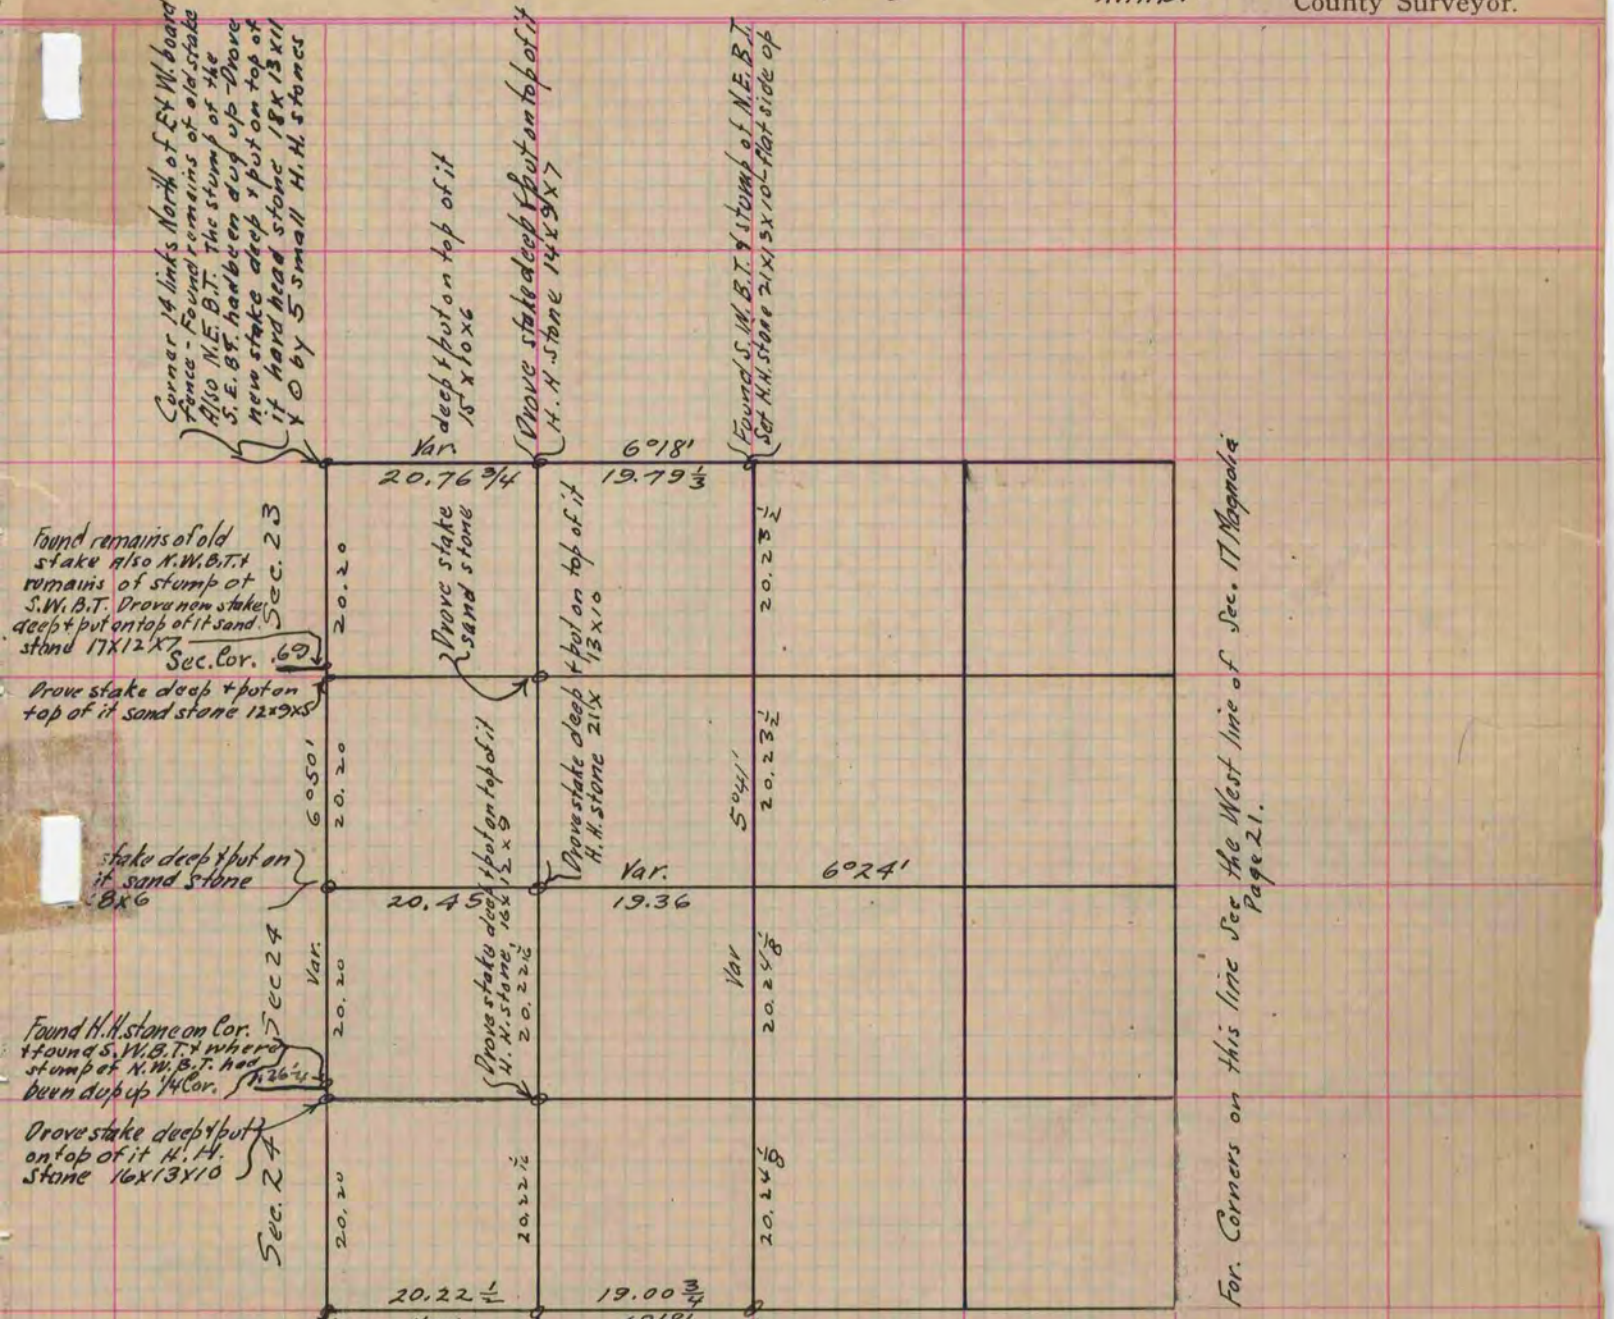

Copied from page 67 Vol. 2. Original County Surveyors Record.