MICROFILMED

PLAT AND RECORD

203
V-2

Of a Survey on Section 9 T 3 R 13 E. of the 4 P. M. in Harmony Township

Rock County, Wisconsin, made January the 20 + 21 1876

I hereby certify that the following is a correct record of said survey as made by me.

COUNTY BUILDING
CITY OF JANESVILLE

(Signed) ROGER DAB 5/01/89

County Surveyor.

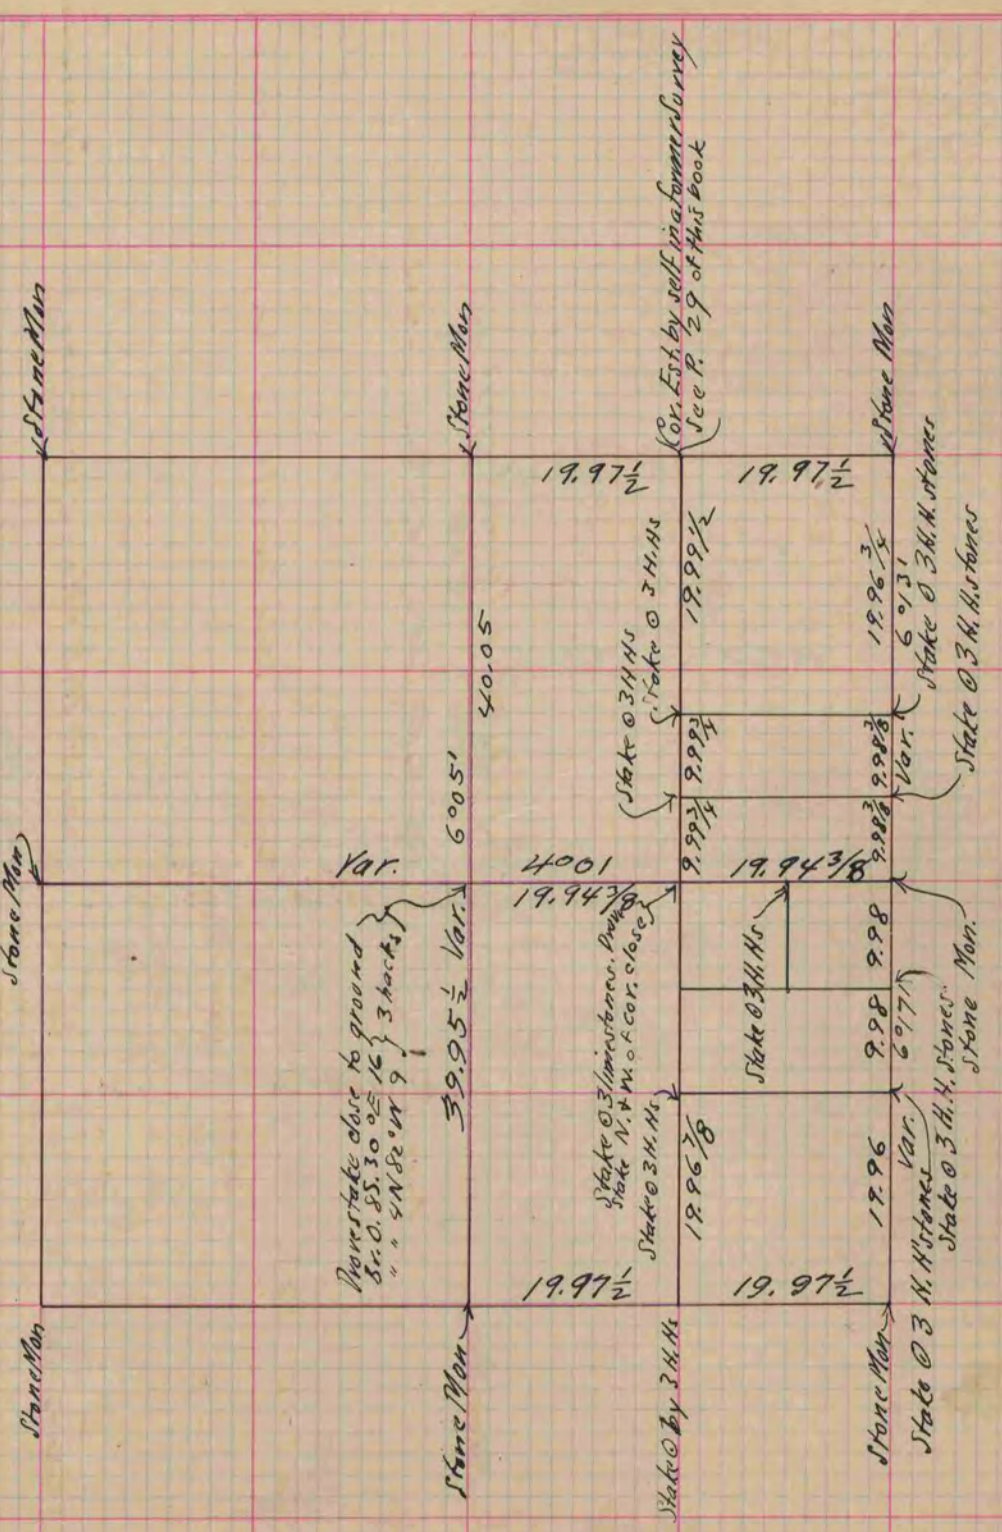

Copied from P. 157 Vol. 2 Original County Surveyors Record.