MICROFILMED
COUNTY BUILDING
CITY OF JANESVILLE

PLAT AND RECORD

Of a Survey on Section 8-11-18 T 2 R 13 E. of the 4 P. M. in Harmony Township

Rock County, Wisconsin, made ..... the 19

I hereby certify that the following is a correct record of said survey as made by me.

..... County Surveyor.

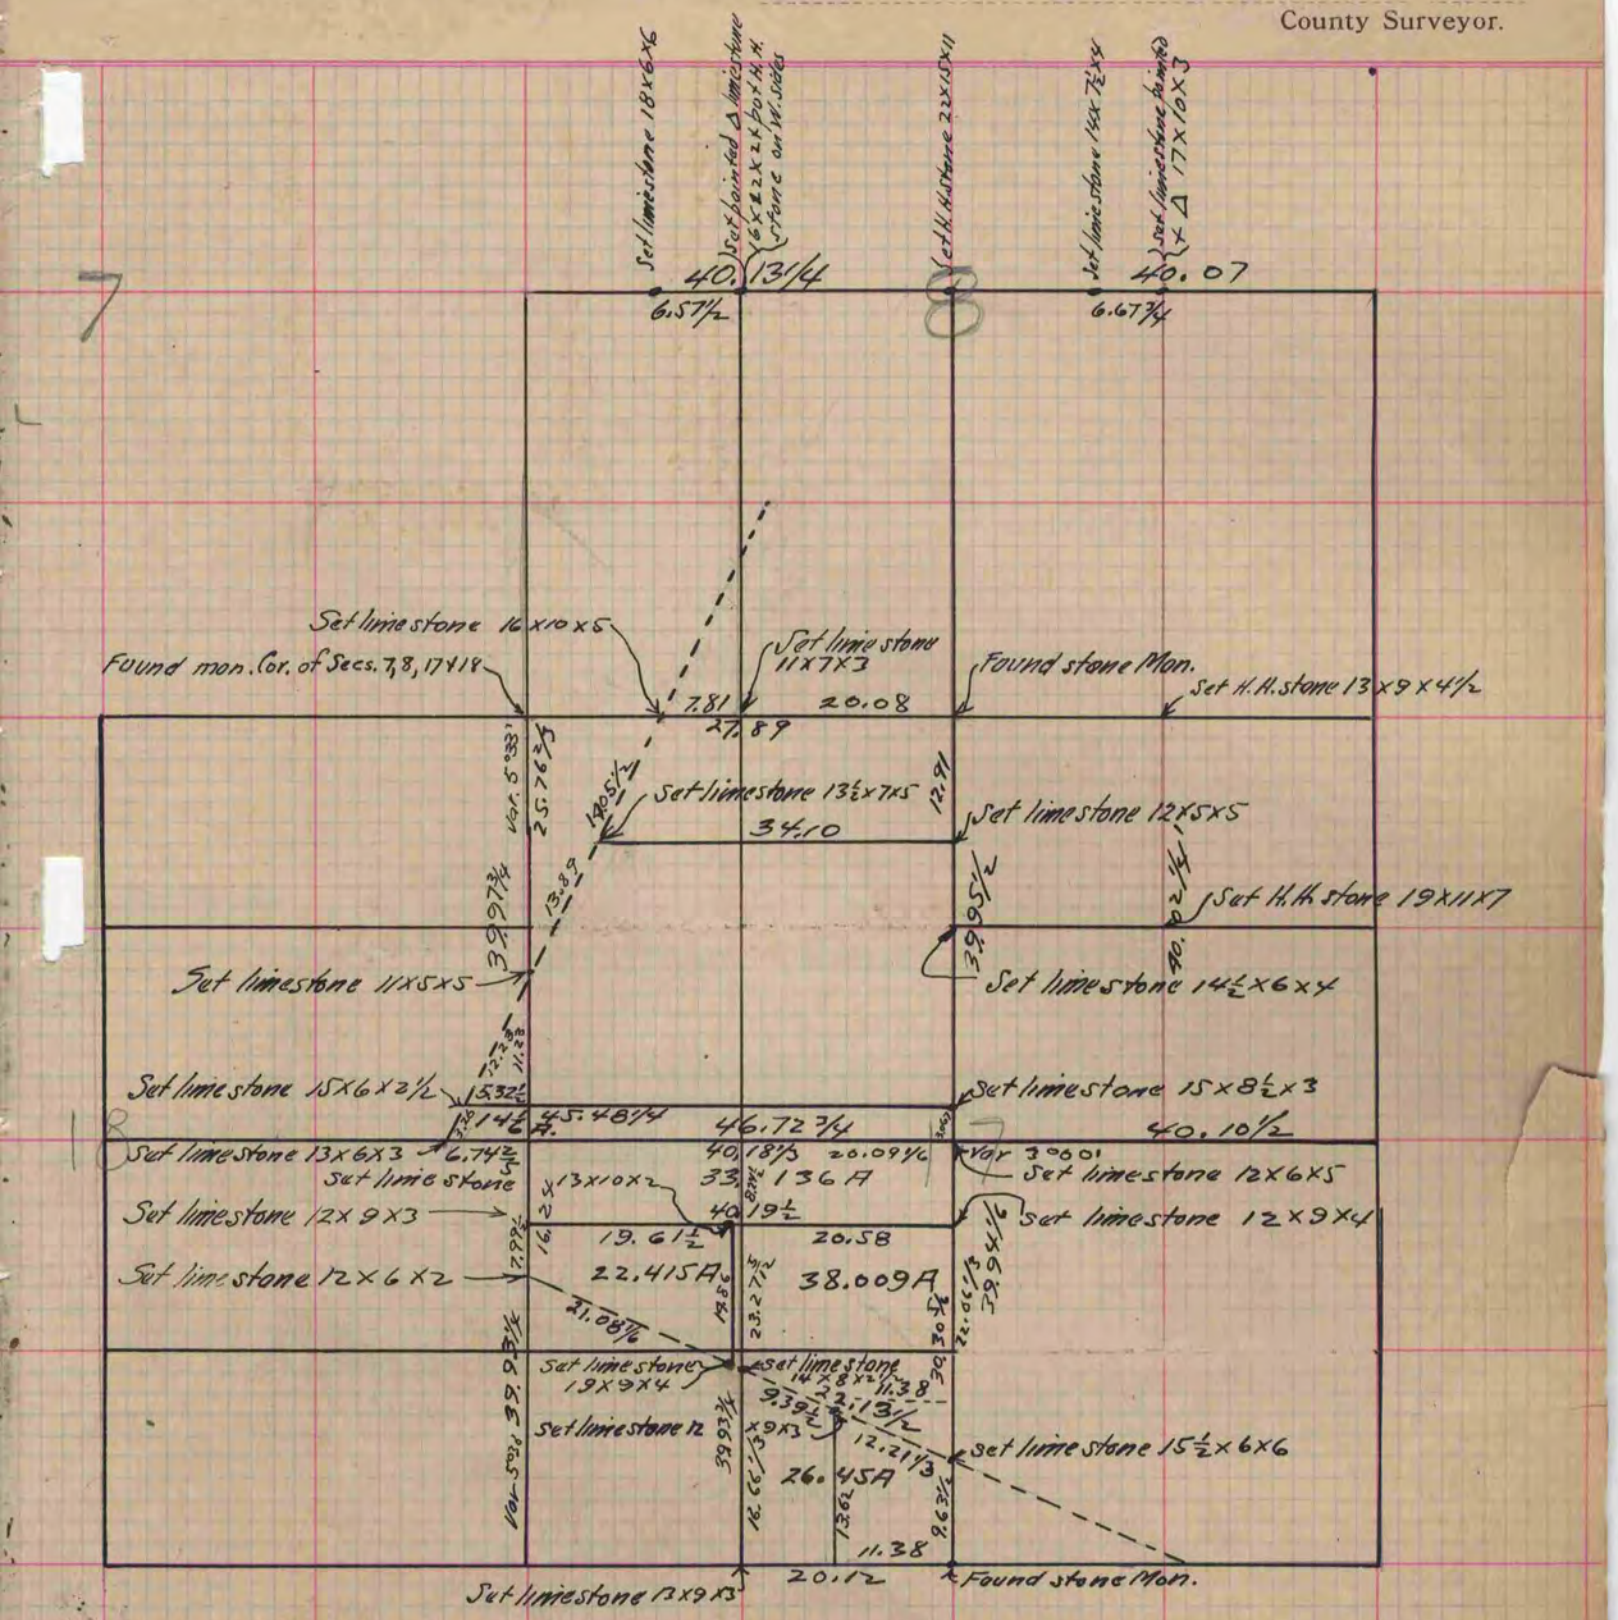

This record is incomplete
See page 241 of this book
(Signed) Edward Ruger, County Surveyor
R.H.B.

Copied from p. 235 Vol. 2. Original County Surveyors Record.