205
V-5

PLAT AND RECORD

COUNTY BUILDING
CITY OF JANESVILLE

Of a Survey on Section 5/32 T 3/4 R 11 E. of the 4 P. M. in Center/Porter Township

Rock County, Wisconsin, made August the 24 1976

I hereby certify that the following is a correct record of said survey as made by me.

Donald Barnes
County Surveyor.

MICROFILMED

THE GEO. H. BARNARD COMPANY, ST. LOUIS
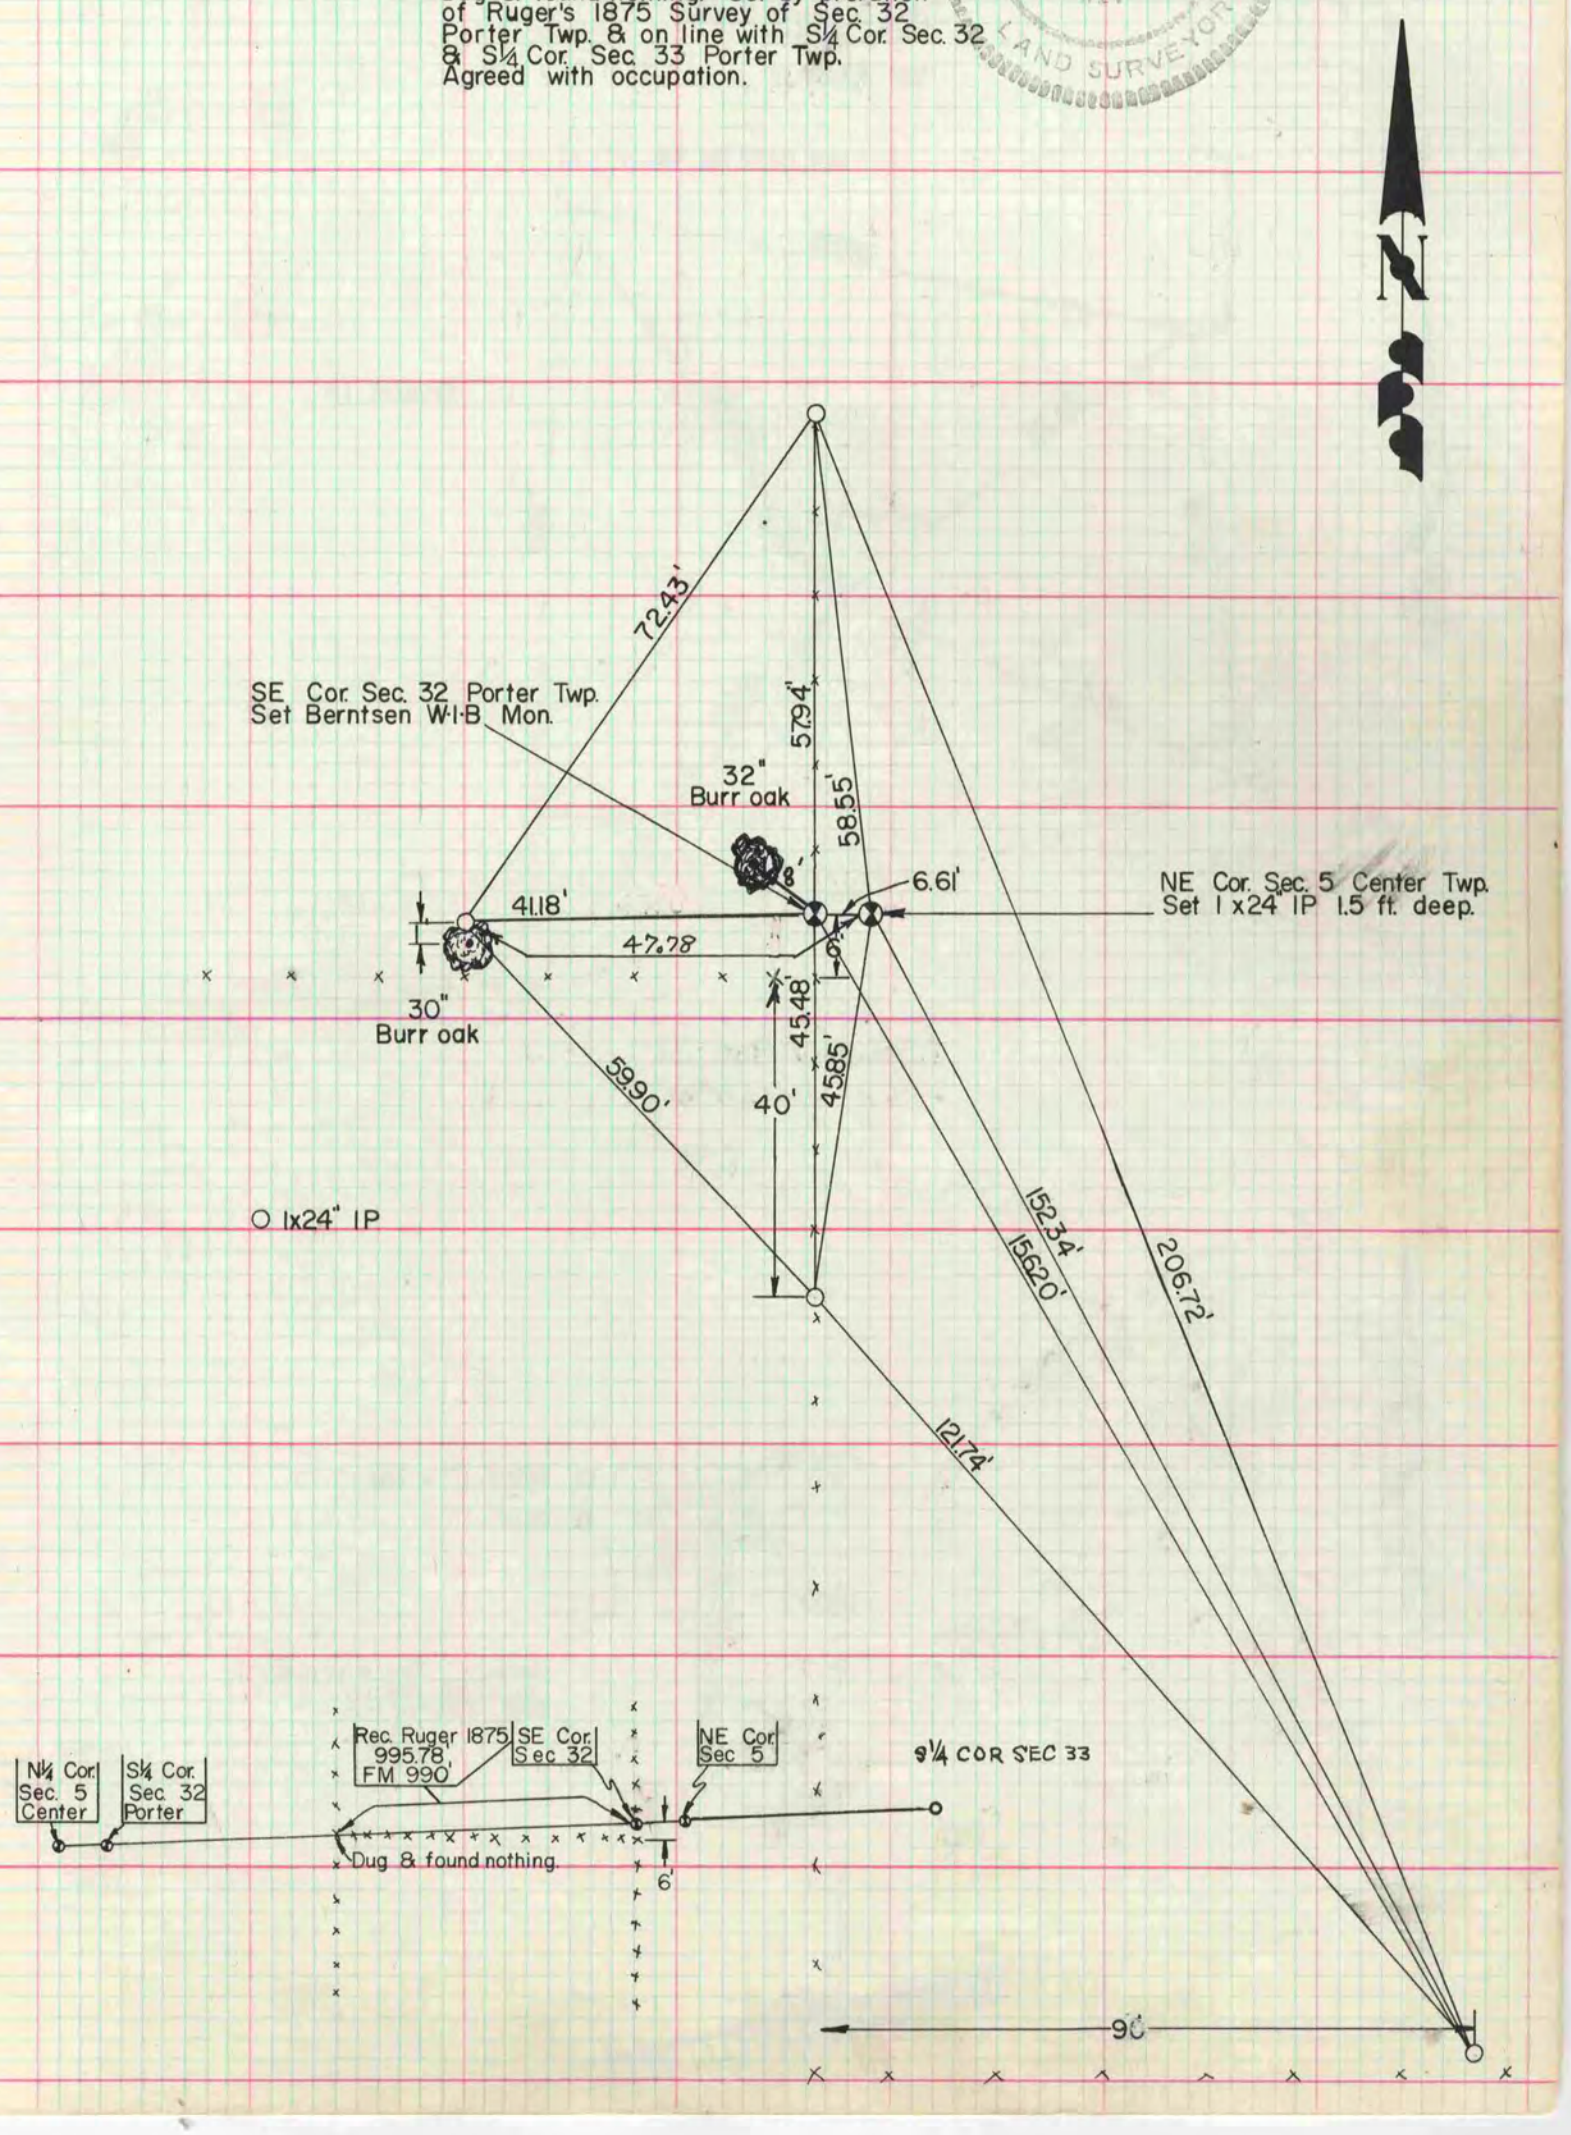
Dug & found nothing. Set by proration of Ruger's 1875 Survey of Sec. 32 Porter Twp. & on line with S¼ Cor. Sec. 32 & S¼ Cor. Sec. 33 Porter Twp. Agreed with occupation.