505
V-2

PLAT AND RECORD

MICROFILMED
COUNTY BUILDING
CITY OF JANESVILLE

Of a Survey on Section 35 T 1 R 10 E. of the 4 P. M. in Avon Township

Rock County, Wisconsin, made the 19

I hereby certify that the following is a correct record of said survey ~~as made by me.~~

(Signed) P. F. Brown
R. H. B. County Surveyor.

Taken from Notes of O. G. Bleedorn.

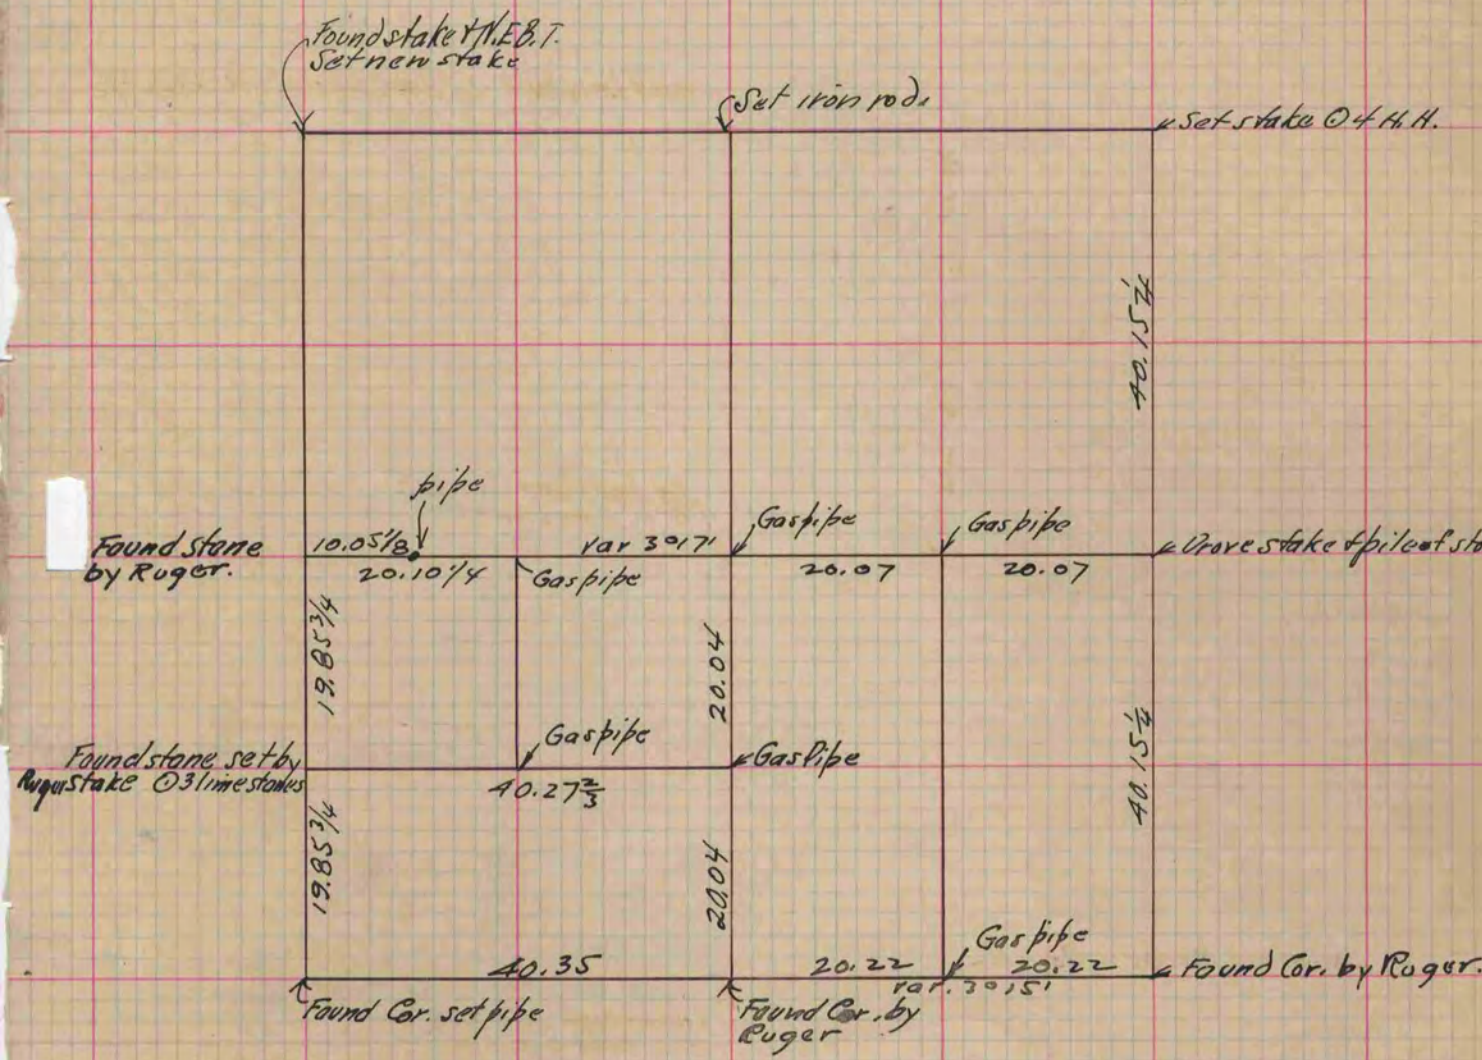

Copied from P. 384 County Surveyors Record. Vol. 2