V-3
205

MICROFILMED

PLAT AND RECORD

PG 196 BELOIT REC
12/15/75 DAB

Fractional Lot 3

Of a Survey on Section 10 T 3N R 12 E. of the 4 P. M. in JANESVILLE Township

Rock County, Wisconsin, made Dec. the 31 1931

I hereby certify that the following is a correct record of said survey as made by me.

COUNTY BUILDING
CITY OF JANESVILLE
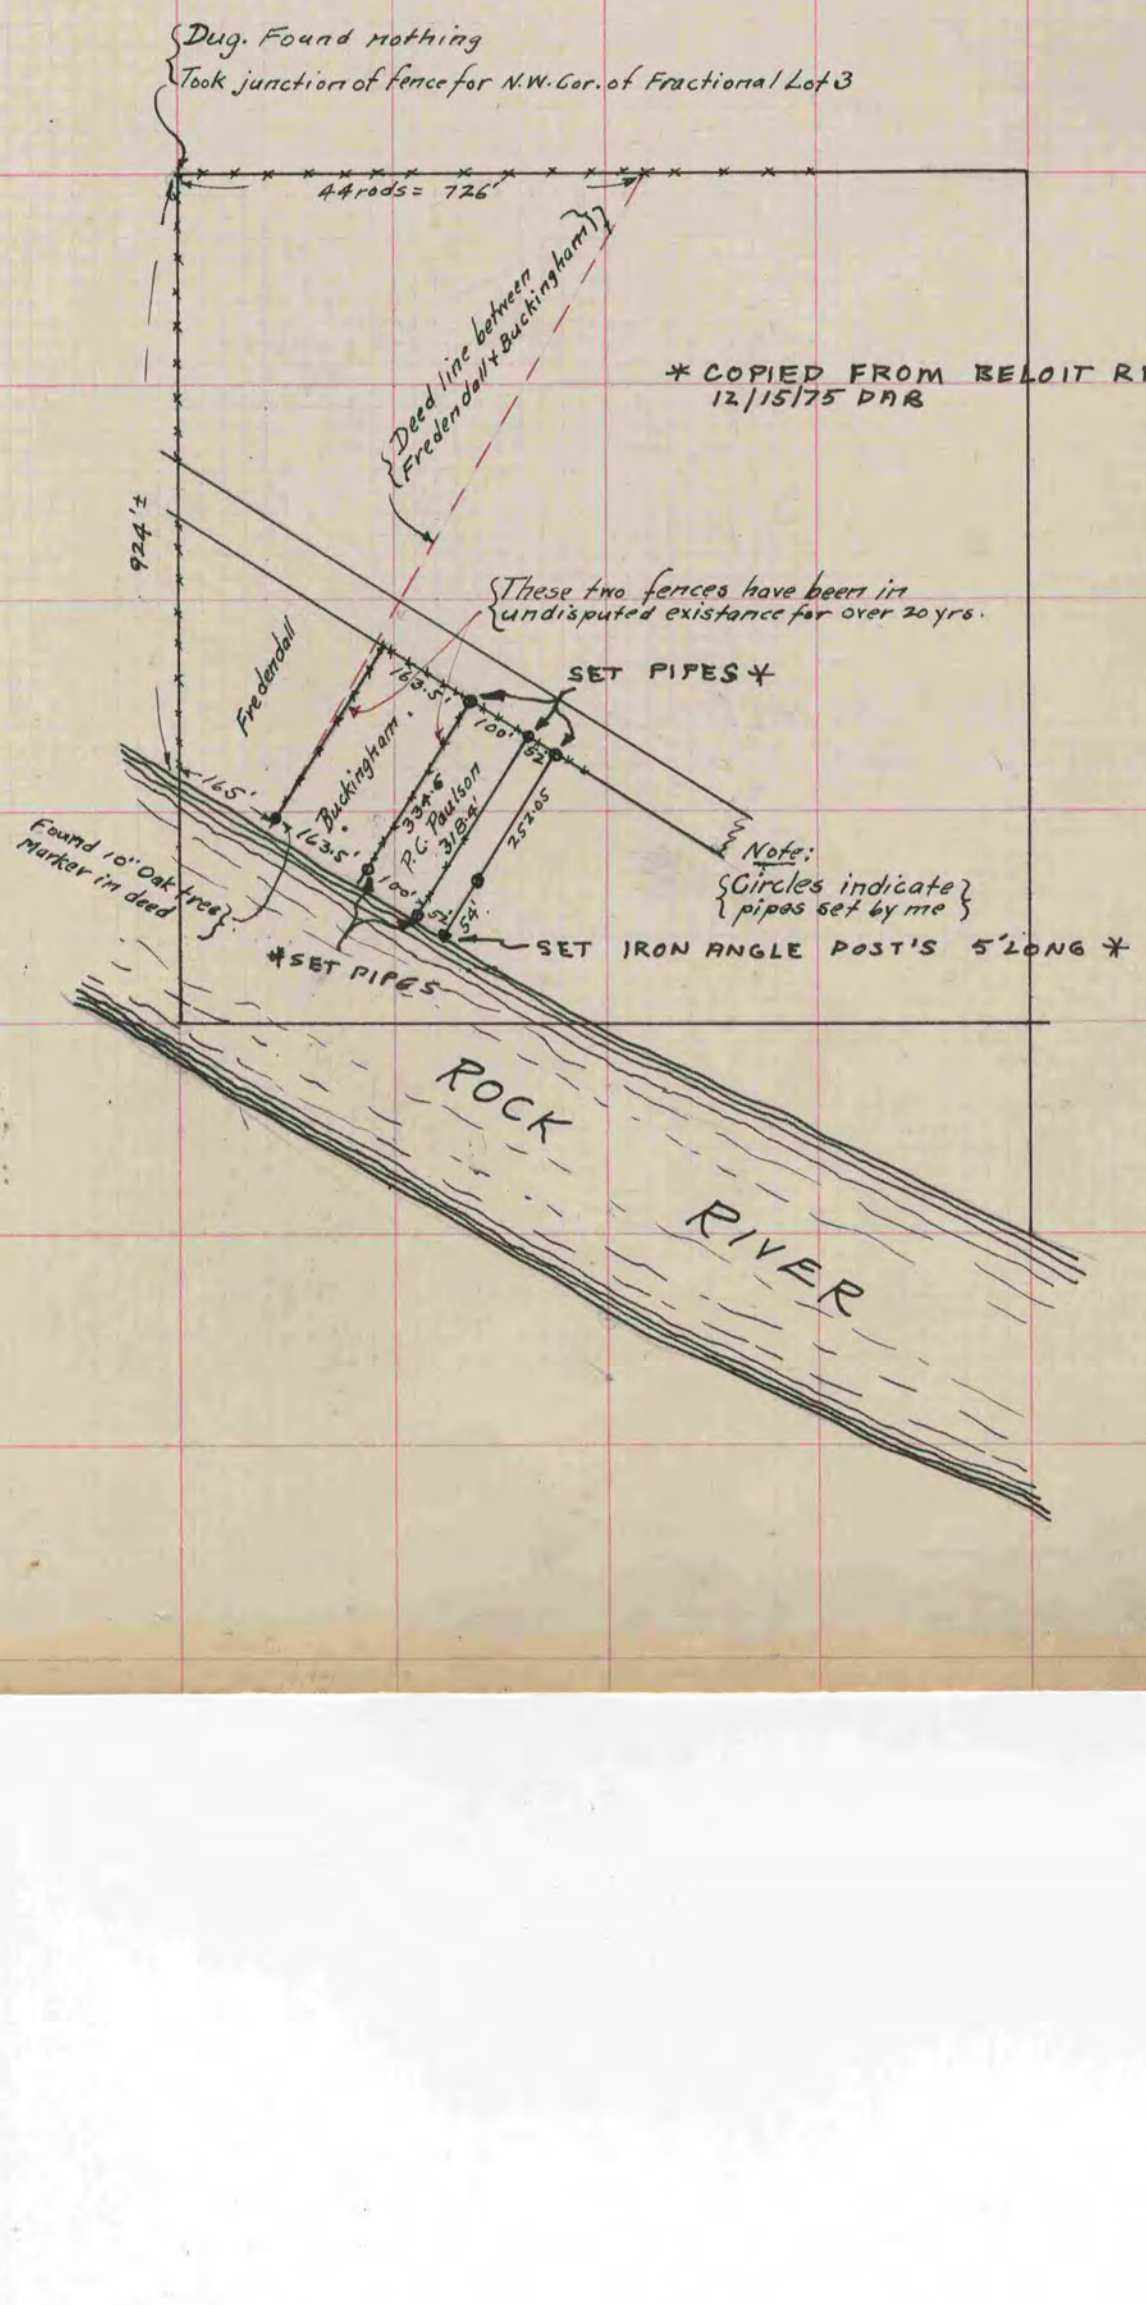
B. J. Bunny
County Surveyor.