MICROFILMED
COUNTY BUILDING
CITY OF JANESVILLE

55
V-2

PLAT AND RECORD

Of a Survey on Section 27 T 4 R 14 E. of the 4 P. M. in Lima Township

Rock County, Wisconsin, made March the 25 & 27 1871

I hereby certify that the following is a correct record of said survey as made by me.

(Signed) Edward Ruger
R.H.B.
County Surveyor.

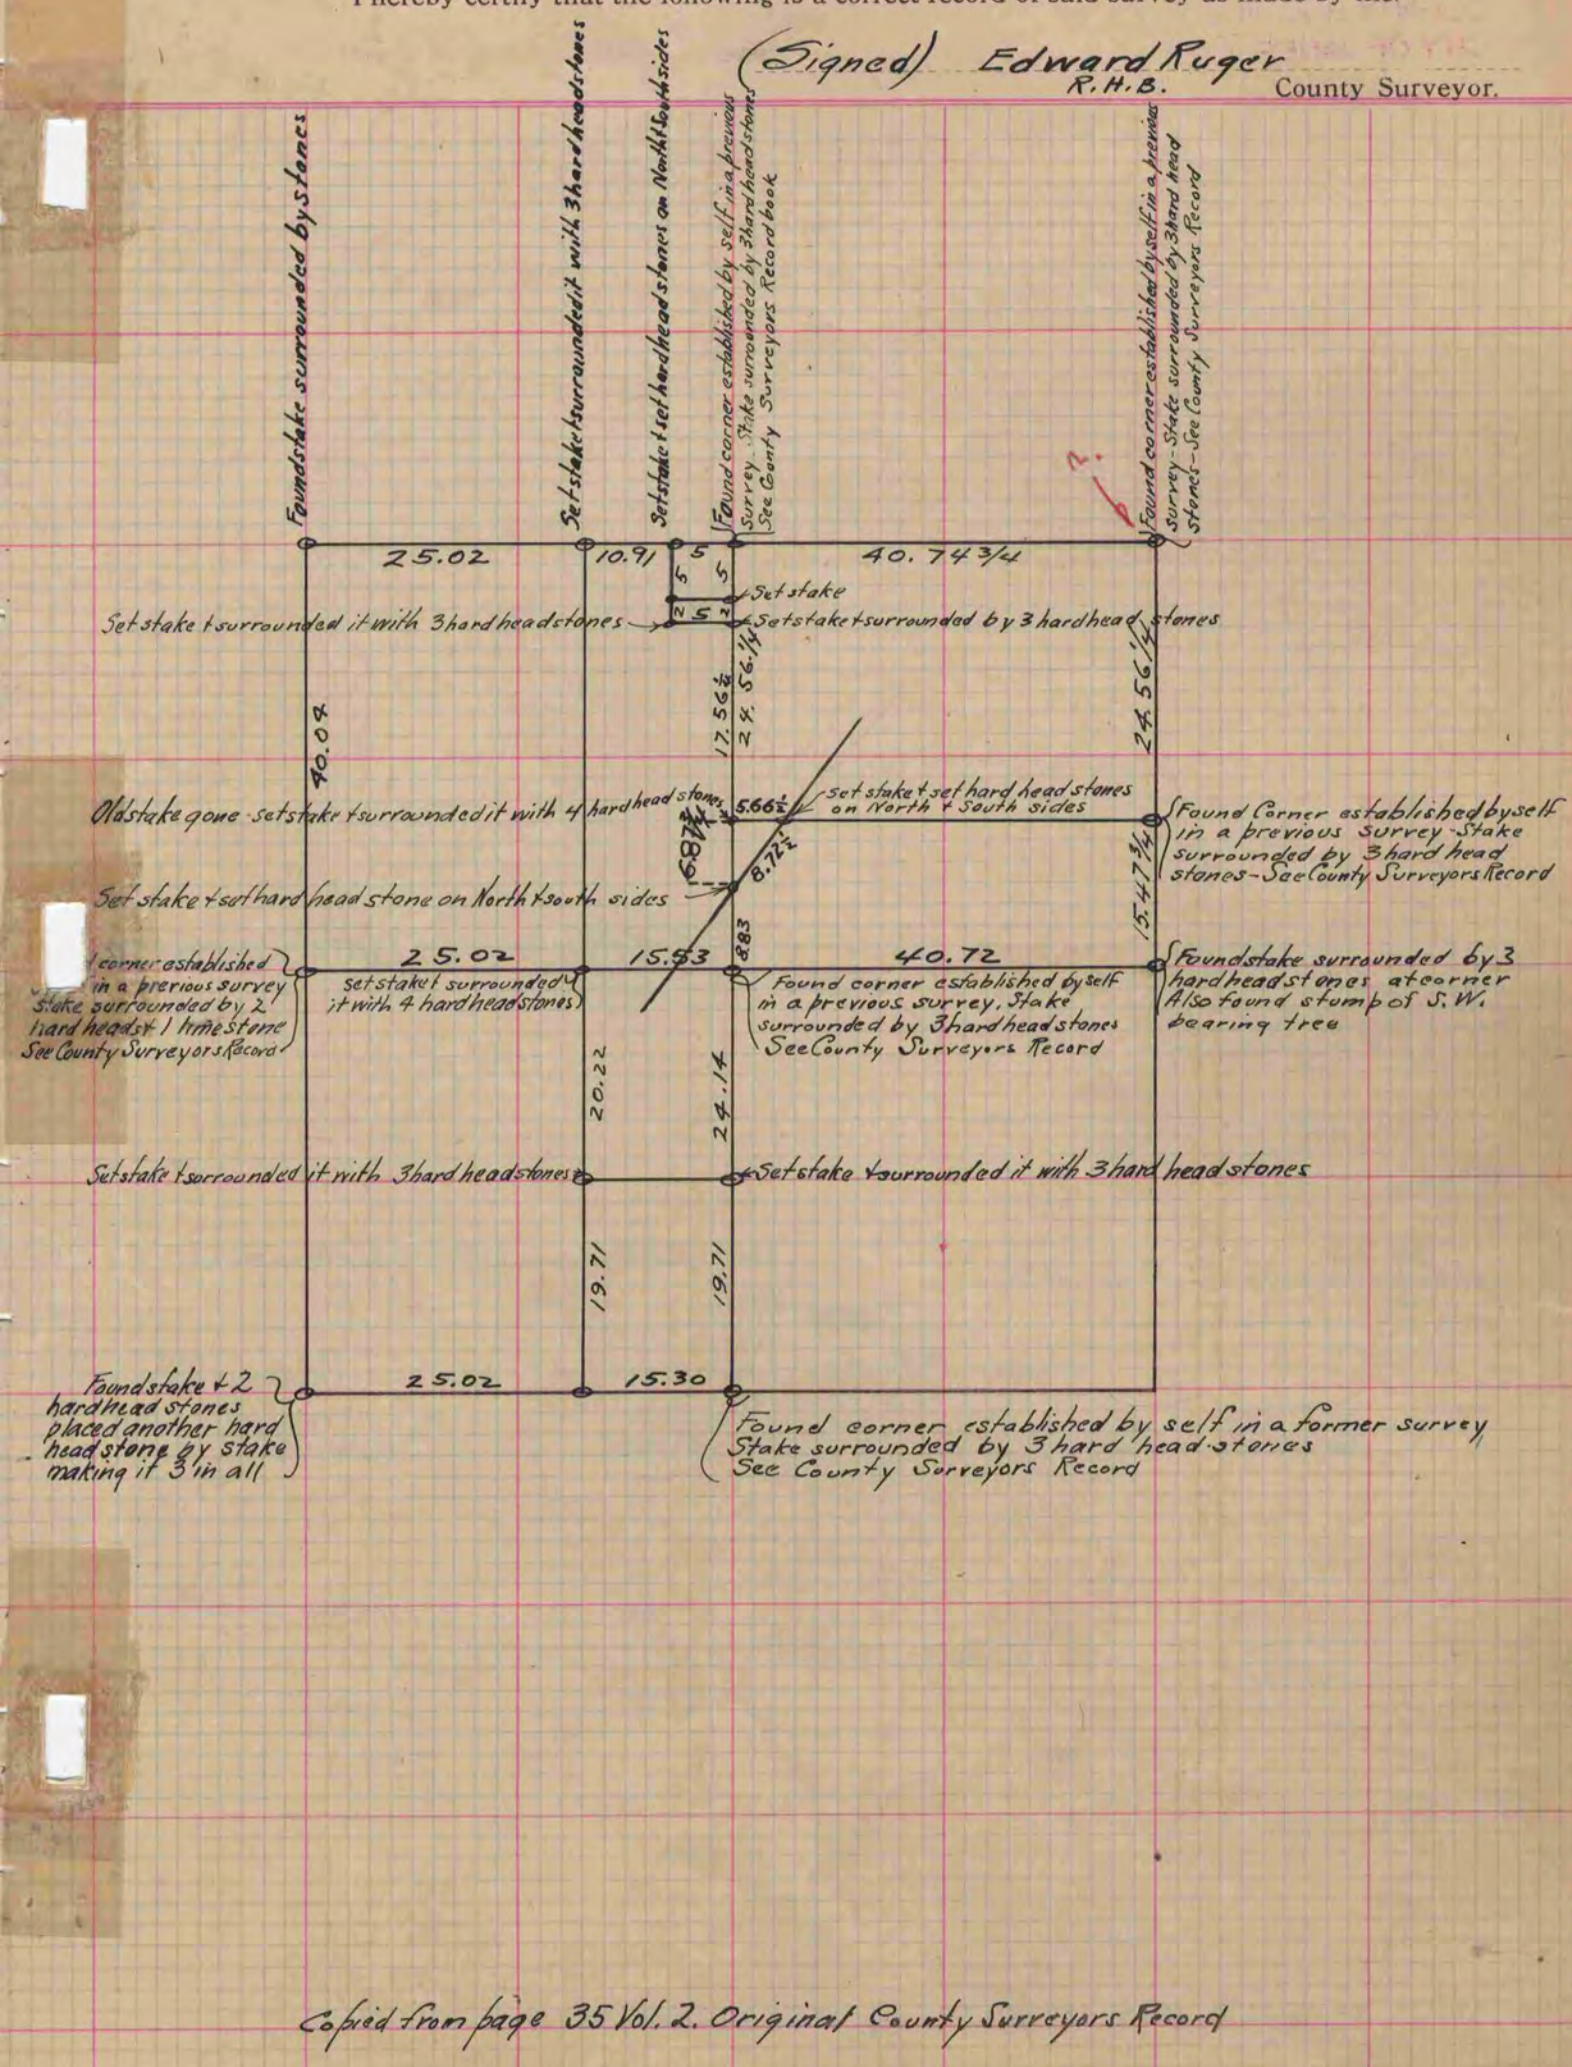

Copied from page 35 Vol. 2. Original County Surveyors Record