382

VOL. 6

PLAT AND RECORD

Of a Survey on Section 34 T 3 R 12 E. of the 4 P. M. in JANESVILLE Township

Rock County, Wisconsin, made July the 15 1988

I hereby certify that the following is a correct record of said survey as made by me.

Donald Barnes

County Surveyor.

COUNTY OF ROCK
CITY OF JANESVILLE

WISCONSIN
DONALD A. BARNES
S-1216
JANESVILLE WI.
LAND SURVEYOR

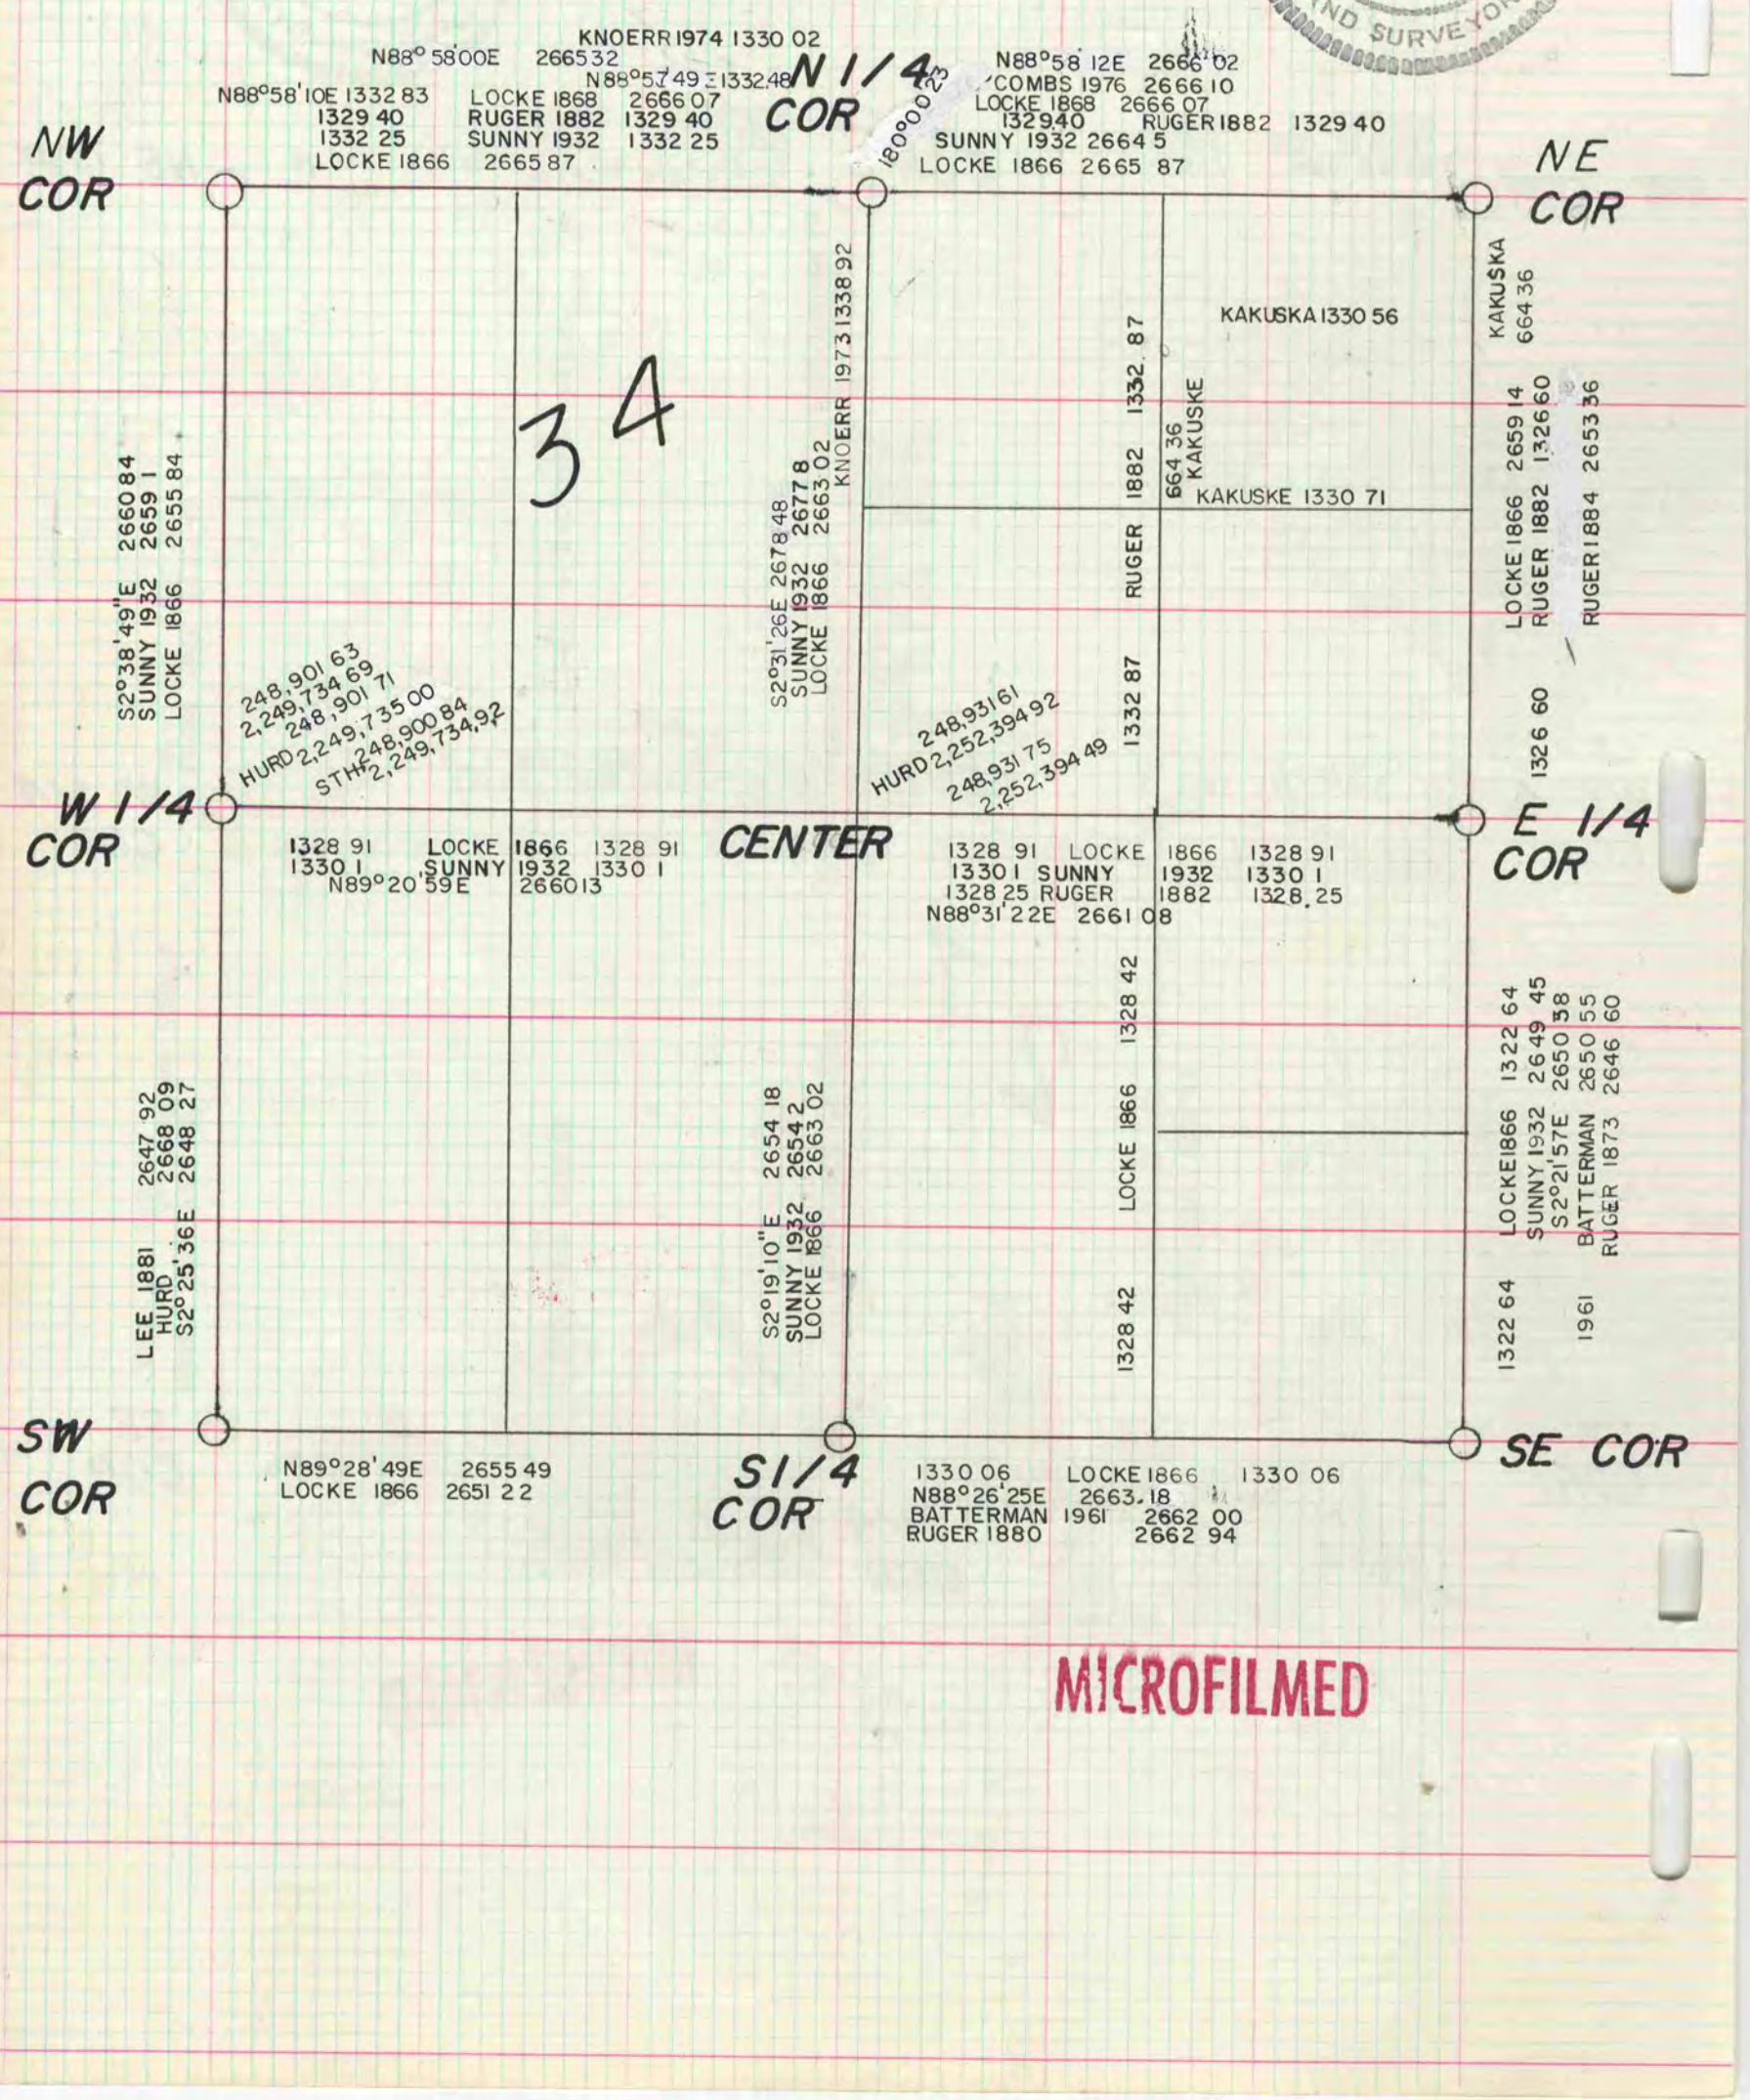

MICROFILMED