206
V-1

PLAT AND RECORD

MICROFILMED

Of a Survey on Section 18 T 3 R 11 E. of the 4 P. M. in Center Township

Rock County, Wisconsin, made April the 20th 1864

I hereby certify that the following is a correct record of said survey as made by me.

COUNTY BUILDING
CITY OF JANESVILLE

(Signed) S. D. Locke
R.H.B. County Surveyor.

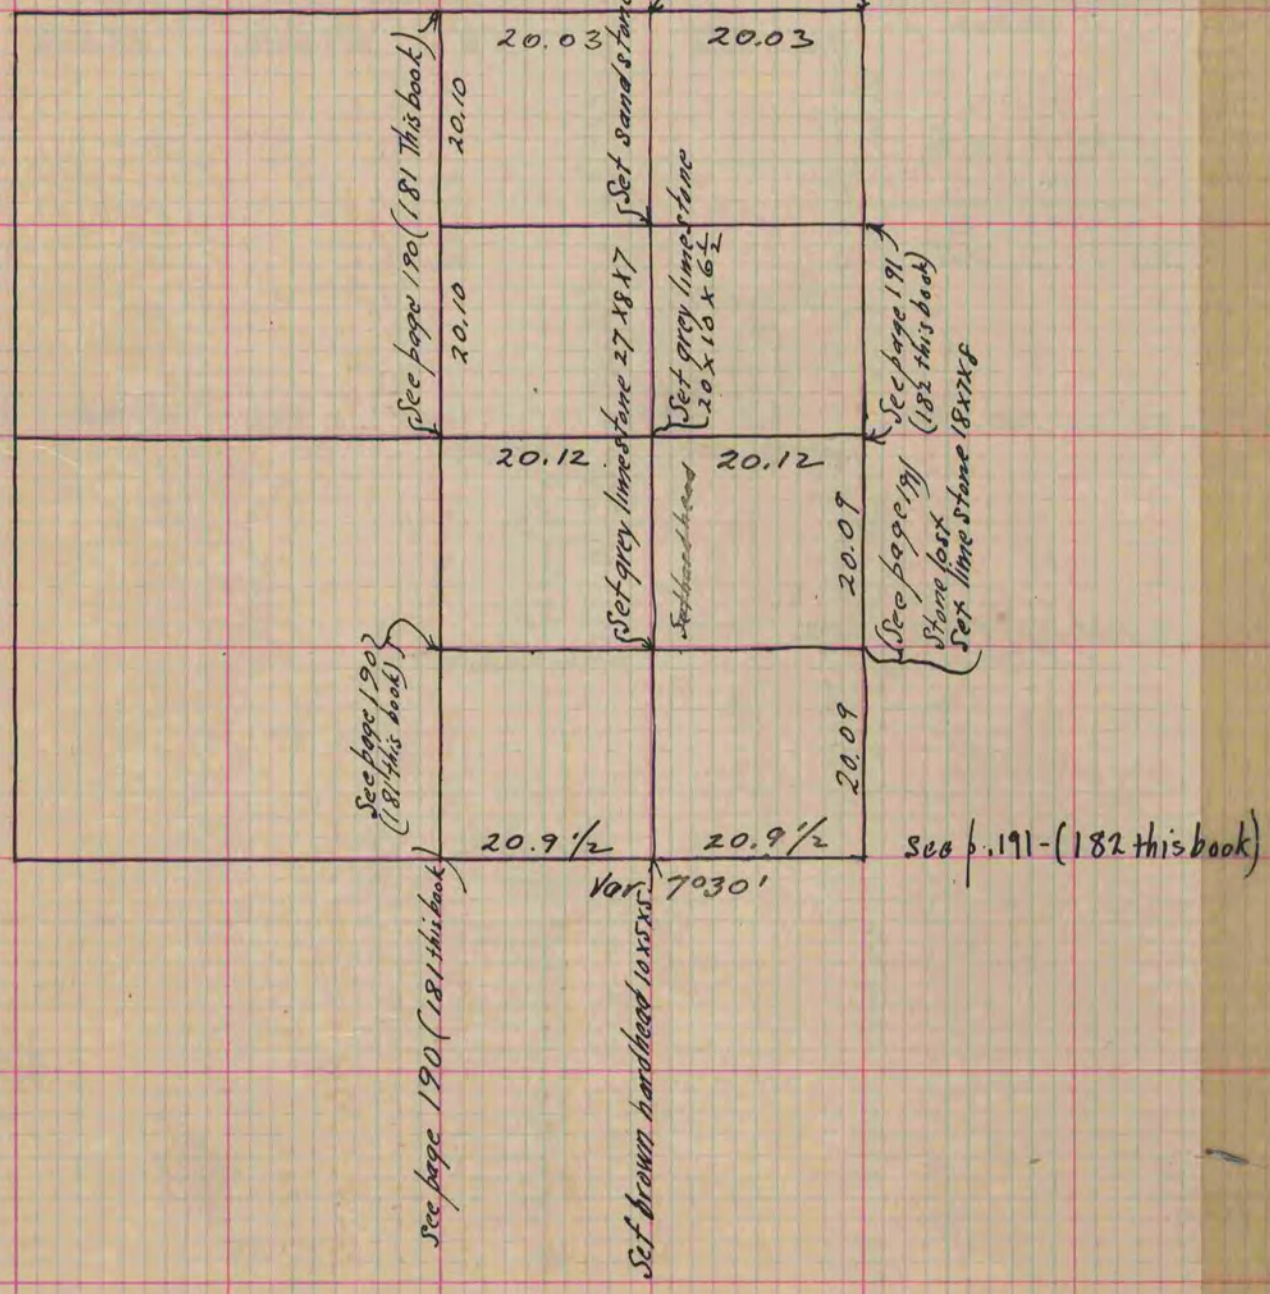

Copied from lower ½ of Page 203 Vol. 1. Original County Surveyors Record