99
V-2

PLAT AND RECORD

MICROFILMED
COUNTY BUILDING
CITY OF JANESVILLE

Of a Survey on Section 2 T 2 R 13 E. of the 4 P. M. in Harmony Township

Rock County, Wisconsin, made May the 27th 1873

I hereby certify that the following is a correct record of said survey as made by me.

(Signed) R.K. Lee R.H.B. Deputy County Surveyor.

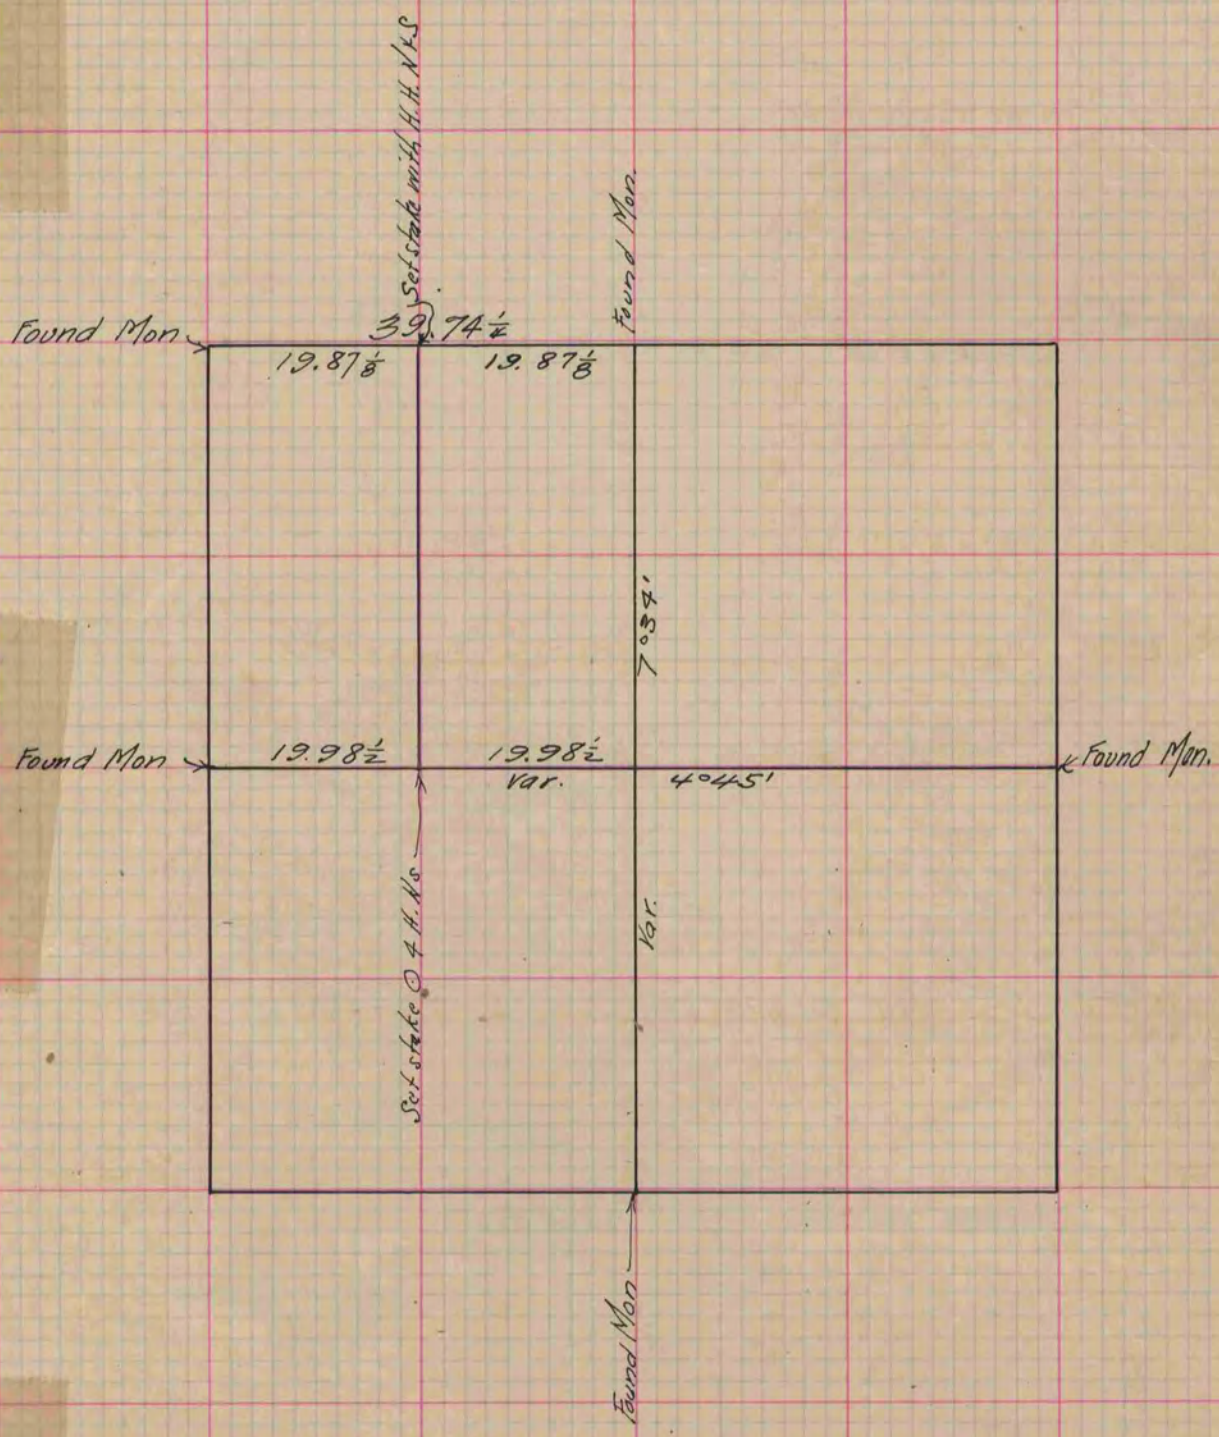

Copied from P. 60 Vol. 2 Original County Surveyors Record