140
V-1

MICROFILMED

PLAT AND RECORD

Of a Survey on Section 16 T 2 R 13 E. of the 4 P. M. in La Prairie Township

Rock County, Wisconsin, made October the 4th & 5th 1860

I hereby certify that the following is a correct record of said survey as made by me.

COUNTY BUILDING
CITY OF JANESVILLE

(Signed) Edward Ruger
R.H.B.
County Surveyor.

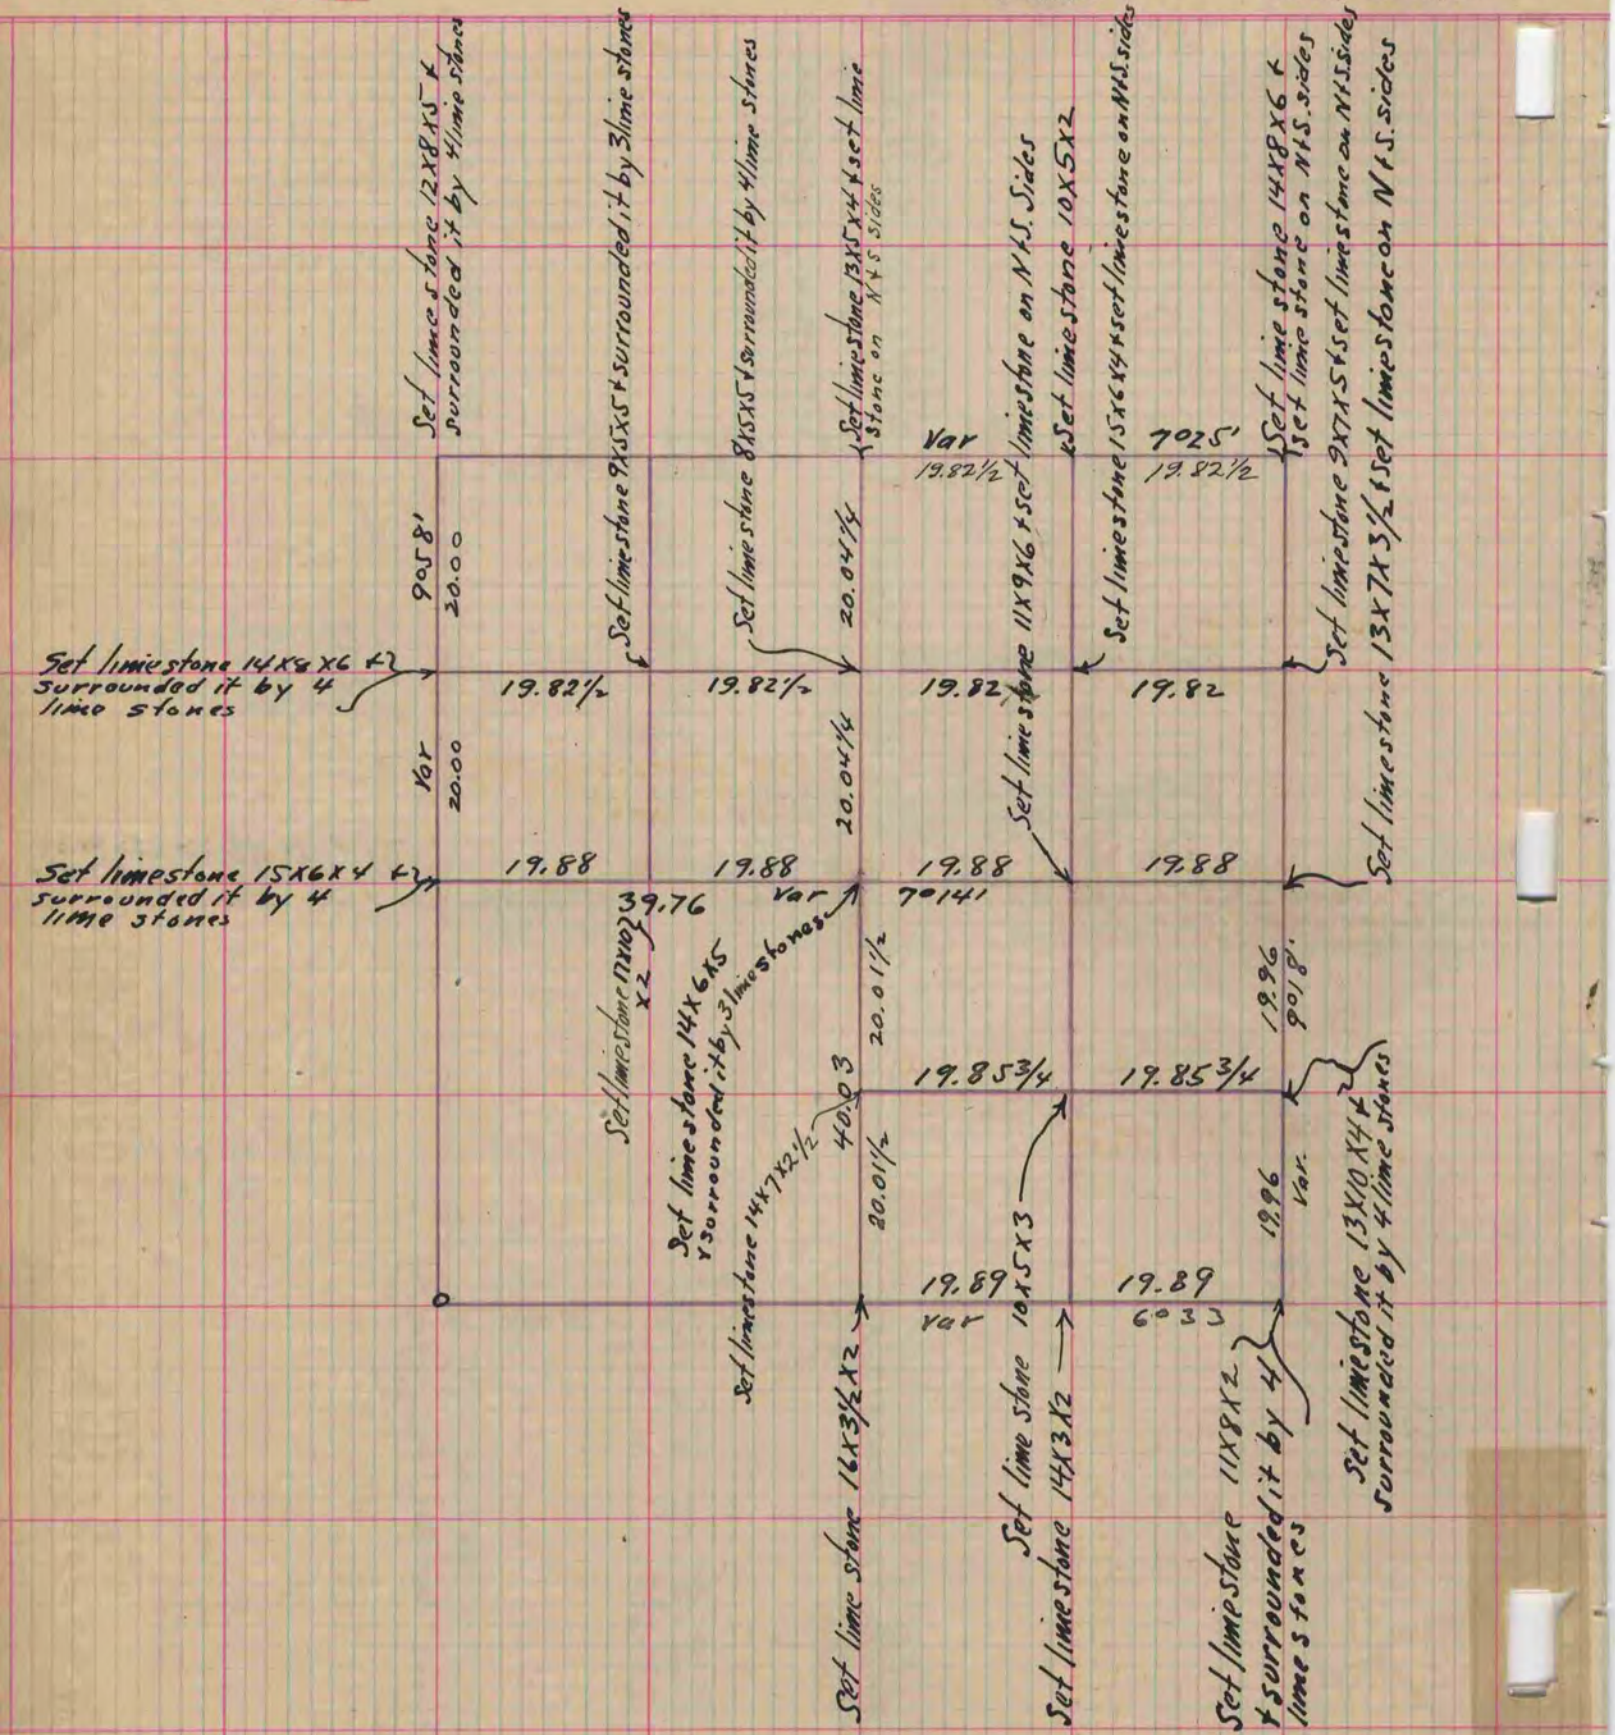

Copied from Page 149 Vol. I. Original County Surveyors Record