PLAT AND RECORD

MICROFILMED
COUNTY BUILDING
CITY OF JANESVILLE

Of a Survey on Section 17 T 2 R 11 E. of the 4 P. M. in Plymouth Township

Rock County, Wisconsin, made December the 22 1873

I hereby certify that the following is a correct record of said survey as made by me.

(Signed) Edward Roger
R.H.B. County Surveyor.

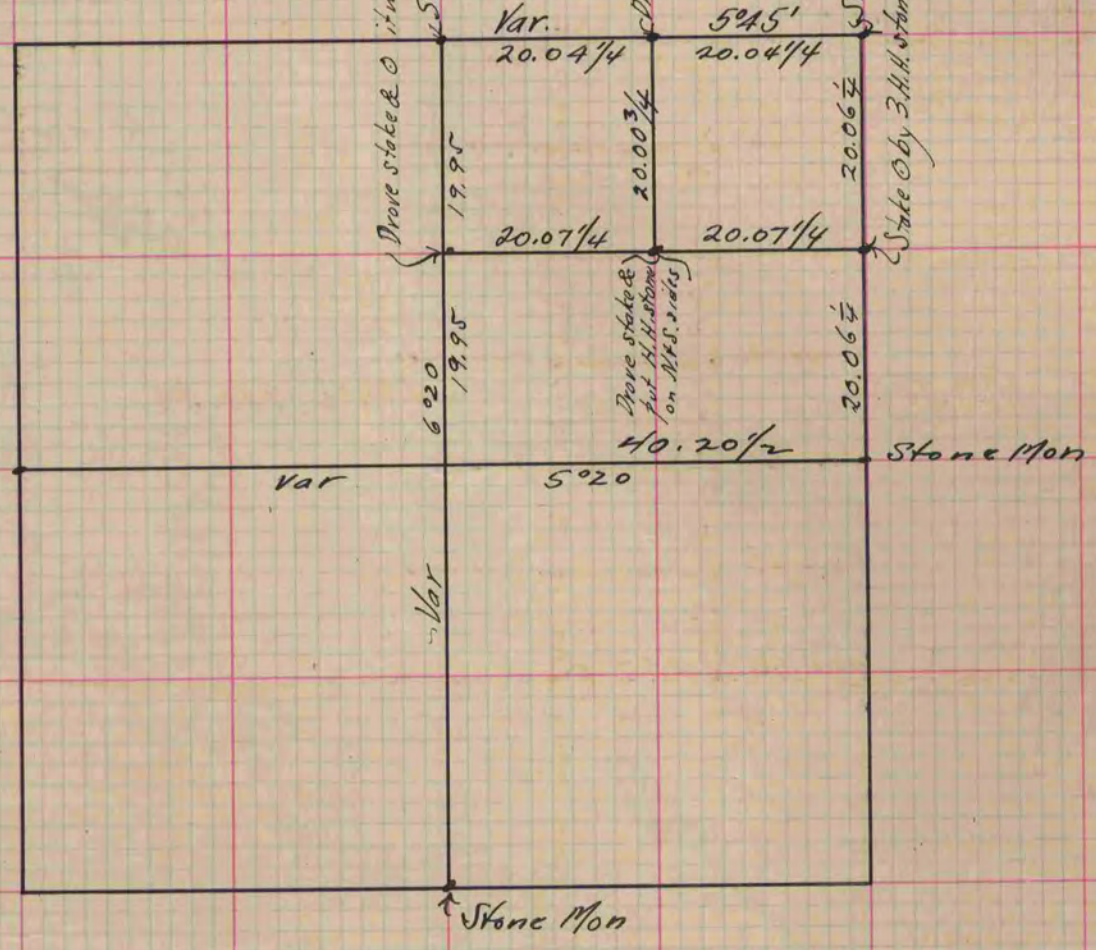

Copied from P. 79 Vol. 2 Original County Surveyors Record