MICROFILMED

PLAT AND RECORD

COUNTY BUILDING
CITY OF JANESVILLE

Of a Survey on Section 27 T 4 R 14 E. of the 4 P. M. in Lima Township

Rock County, Wisconsin, made October the 24th & 25th 1859

I hereby certify that the following is a correct record of said survey as made by me.

(Signed) Edward Ruger
R.H.B. County Surveyor.

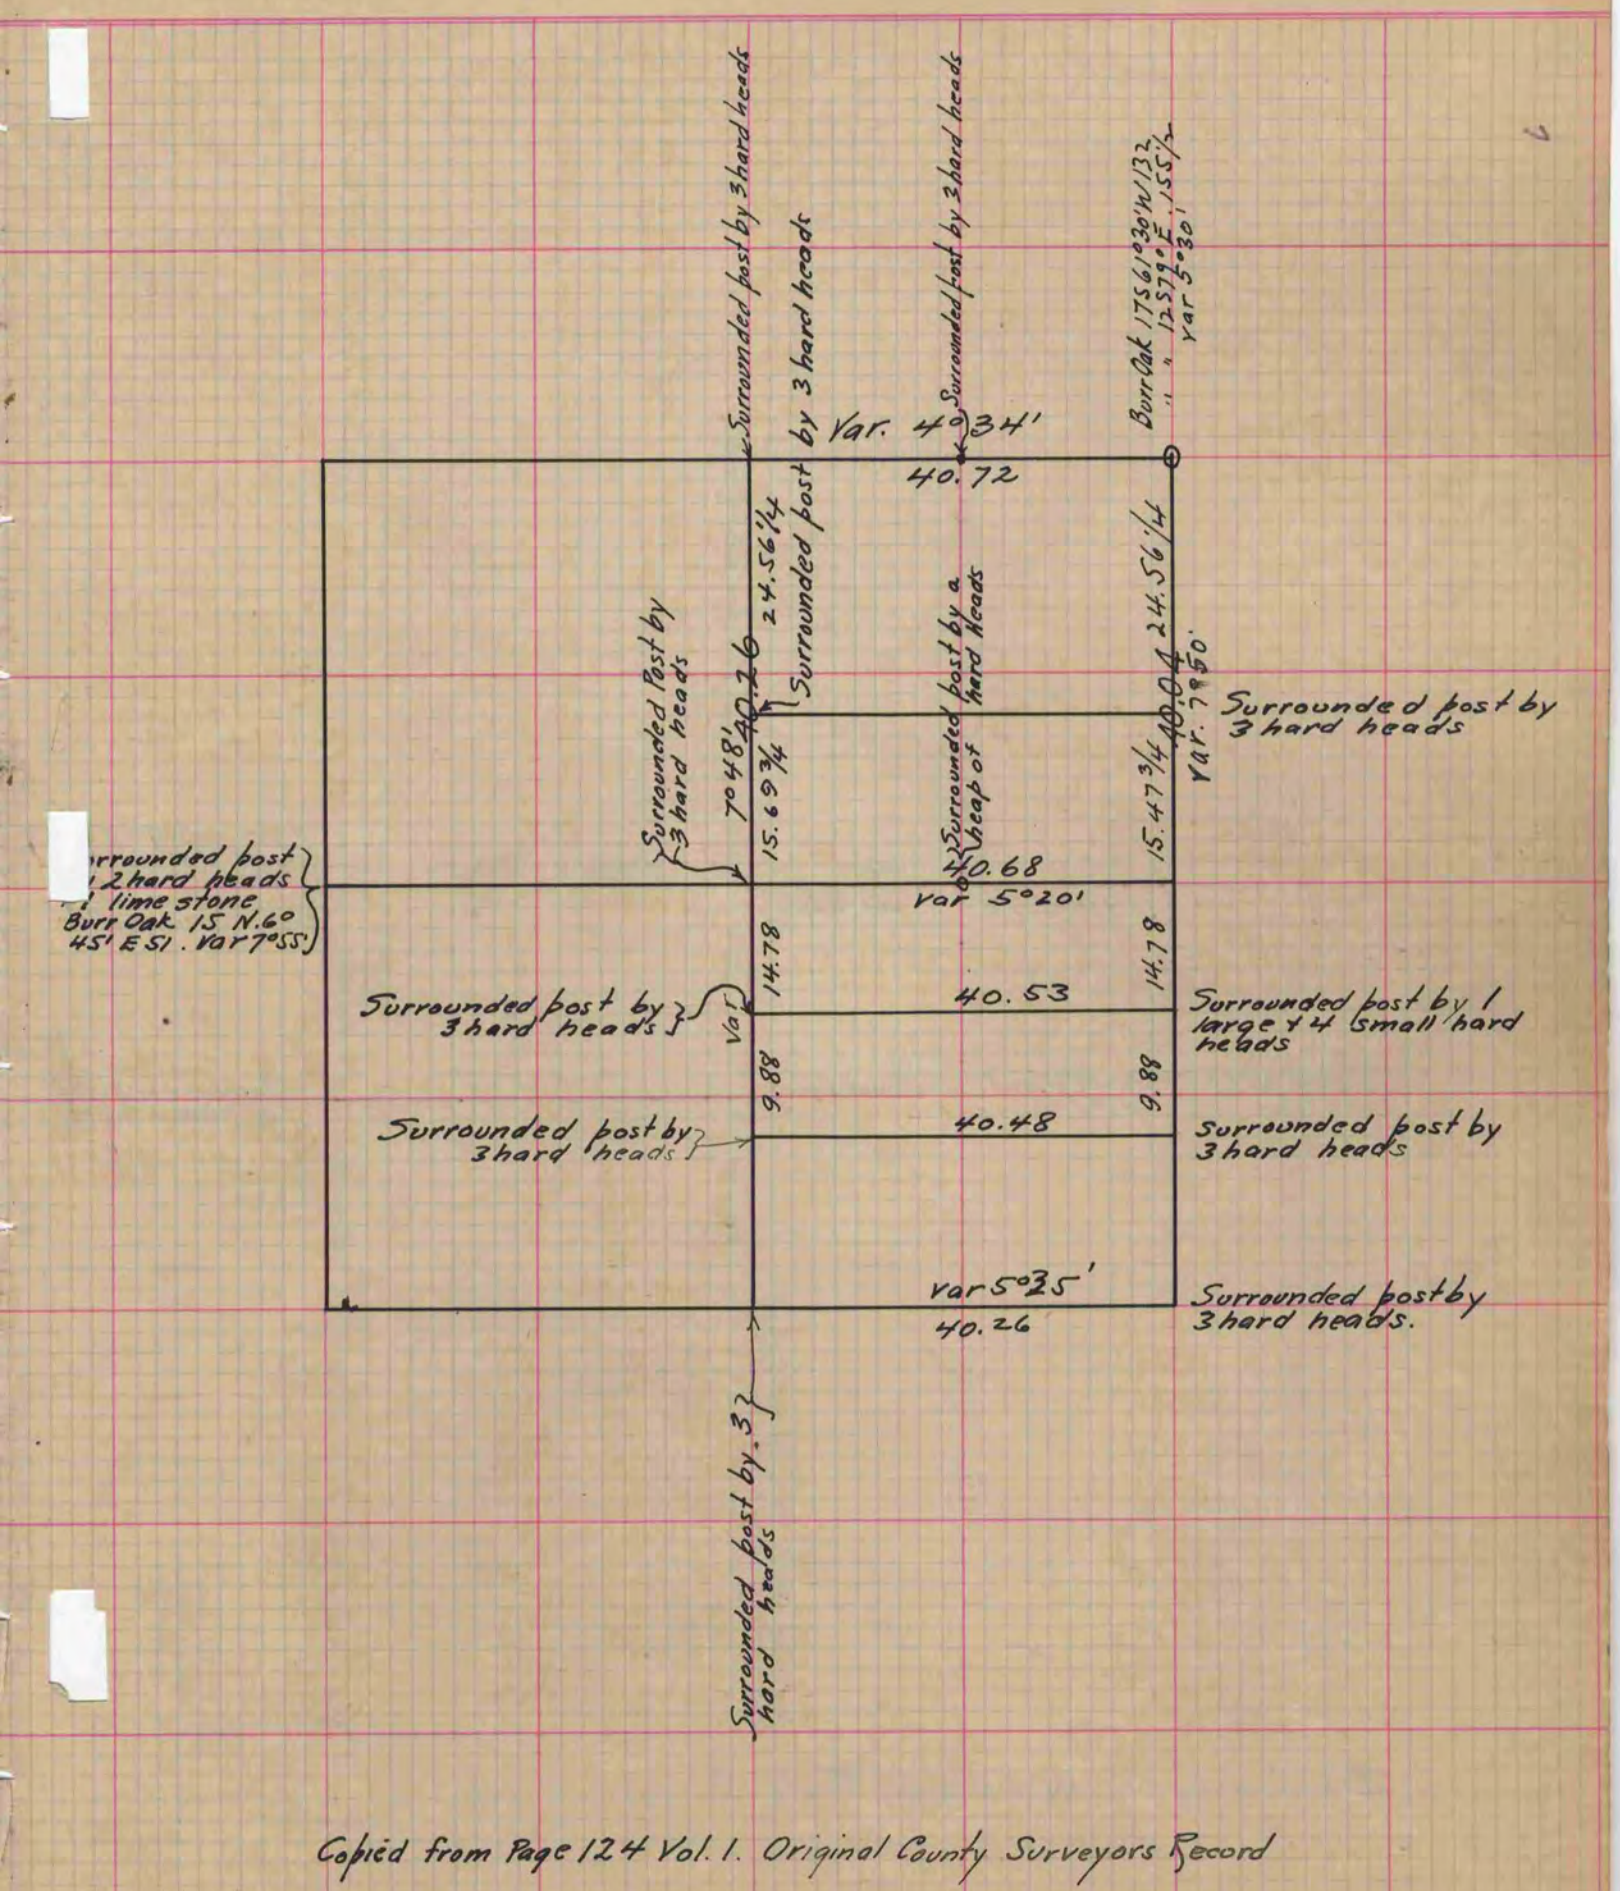

Copied from Page 124 Vol. 1. Original County Surveyors Record